



FUTURE FABRICATING
 23450 REGENCY PARK DRIVE
 WARREN, MICHIGAN 48089
 (586) 755-0900 FAX (586) 755-7456

LETTER OF TRANSMITTAL

DATE 9/9/22	JOB # 22-2089
ATTENTION Luiza Diac	
RE: Motown Museum Expansion - Phase 2	
FROM Randy Watycha	
EMAIL randyw@futurefabricating.com	

TO:
 L.S. Brinker
 3633 Michigan Ave., Suite 200
 Detroit, MI 48216

WE ARE SENDING YOU:

- ATTACHED UNDER SEPARATE COVER VIA _____
 SHOP DRAWINGS PRINTS PLANS SAMPLES SPECIFICATIONS
 COPY OF LETTER CHANGE ORDER

COPIES	SPEC SECTION	DATE	SUBMITTAL NO.	DESCRIPTION
1	057300	9/9/22	2	Submittal drawings revC


THESE ARE TRANSMITTED as checked below:

- FOR APPROVAL APPROVED AS SUBMITTED RESUBMIT
 FOR YOUR USE APPROVED AS NOTED SUBMIT
 AS REQUESTED RETURNED FOR CORRECTIONS RETURN
 FOR REVIEW AND COMMENT

REMARKS

Please review and approve the attached submittal drawings.

Please return approvals by **9/23/2022** to avoid possible delays in your project

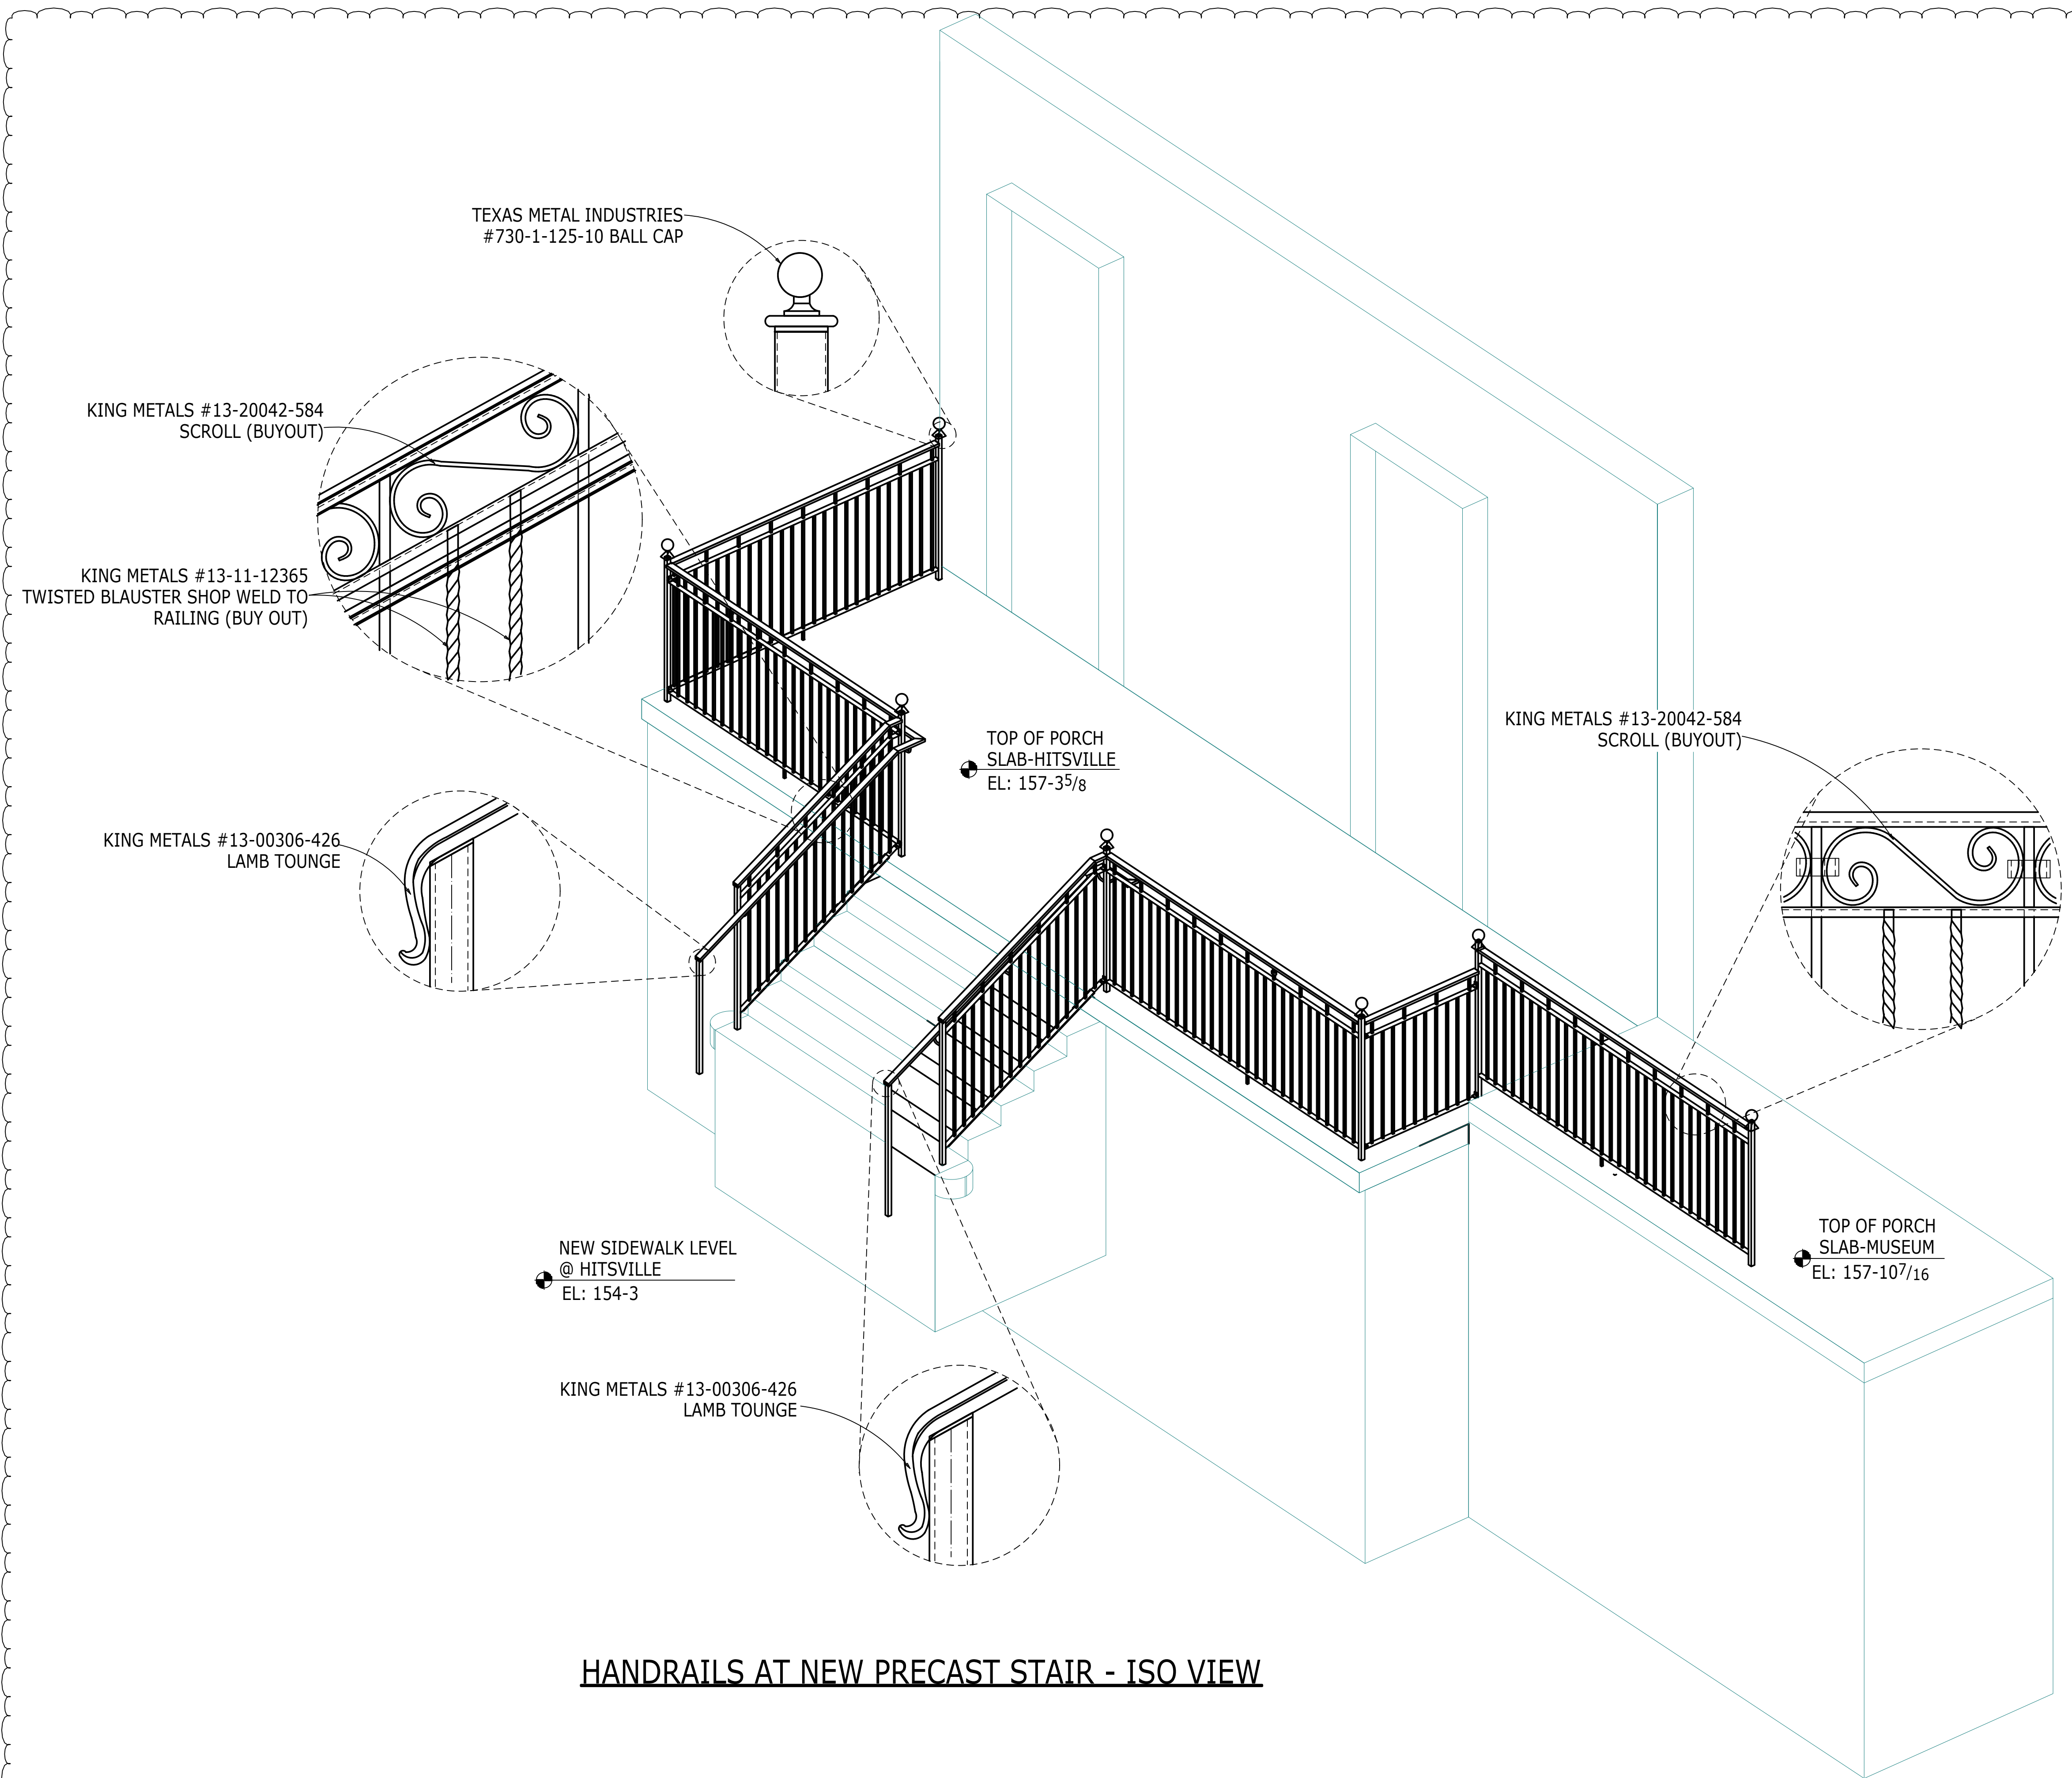


HANDRAILS AT NEW PRECAST STAIR - ISO VIEW

TYPICAL APPROVER NOTE:
 CONFIRM/ELSE ADVISE ON ALL MATERIALS, DIMENSIONS, ELEVATIONS AND CONNECTION DETAILS. THINGS WHICH WERE NOT COMMENTED WHILE APPROVAL RETURNS, WILL BE CONSIDERED AS APPROVED, AS SHOWN.

NOT FOR CONSTRUCTION			
BY:		09-09-2022	REVISED AS MARKED
DATE:		07-06-2022	FOR RE-APPROVAL
		06-10-2022	FOR APPROVAL
		DATE	DESCRIPTION



DRAWING NOTES:
 ◆ ADD ADDITIONAL NOTES HERE (IF REQ'D)
 MATERIAL: STEEL A53, A500 & A36 U.N.O.
 HOLES: 13/16" U.N.O.
 ELECTRODES: PER AWS D1.1 U.N.O.
 WELD FINISH: NOMMA #3 U.N.O.
 REF-DWG REF: AD1.1, A1.1, A3.1, A3.2, A3.3, A4.1, ASK-2203144

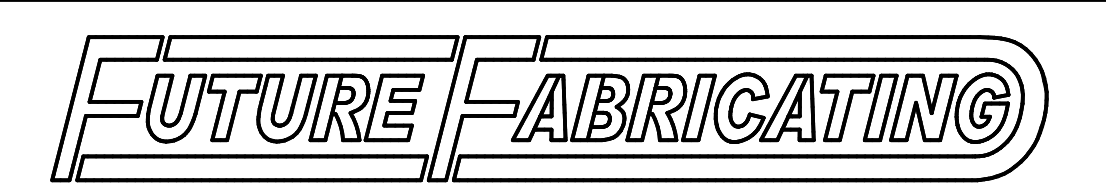

P: 586.755.7080 o F: 586.755.7456 o www.futurefabricating.com

DRAWING REVIEW / APPROVAL: THESE DRAWINGS REPRESENT FUTURE FABRICATING'S INTERPRETATION OF THE INTENT OF THE CONTRACT DOCUMENTS. EVERY EFFORT HAS BEEN MADE TO ENSURE THAT THEY ARE ACCURATE AND COMPLETE. APPROVAL BY THE AUTHORIZED PARTIES SHALL CONSTITUTE ACCEPTANCE AND ANY POST APPROVAL CHANGES WILL BE CONSIDERED TO BE CHANGES TO FUTURE FABRICATING'S CONTRACT. SHEET DESCRIPTION:		
DRAWN BY: MSK	CHECKED BY: ARS	FIELD MEASURED:
DATE: 06-03-2022	DATE: 06-03-2022	DATE:
JOB NUMBER: 22-2089	REV:	REV:
PROJECT NAME: MOTOWN MUSEUM EXPANSION-PHASE 2	SHEET NUMBER: E1	REV:
CUSTOMER: L.S.BRINKER		



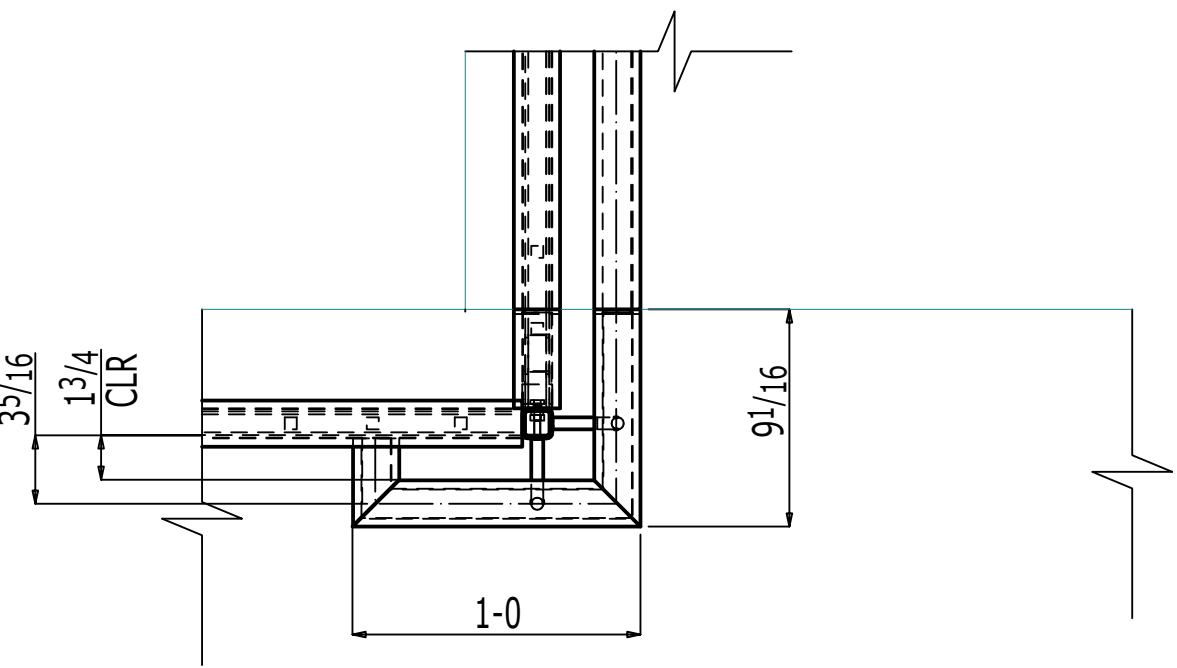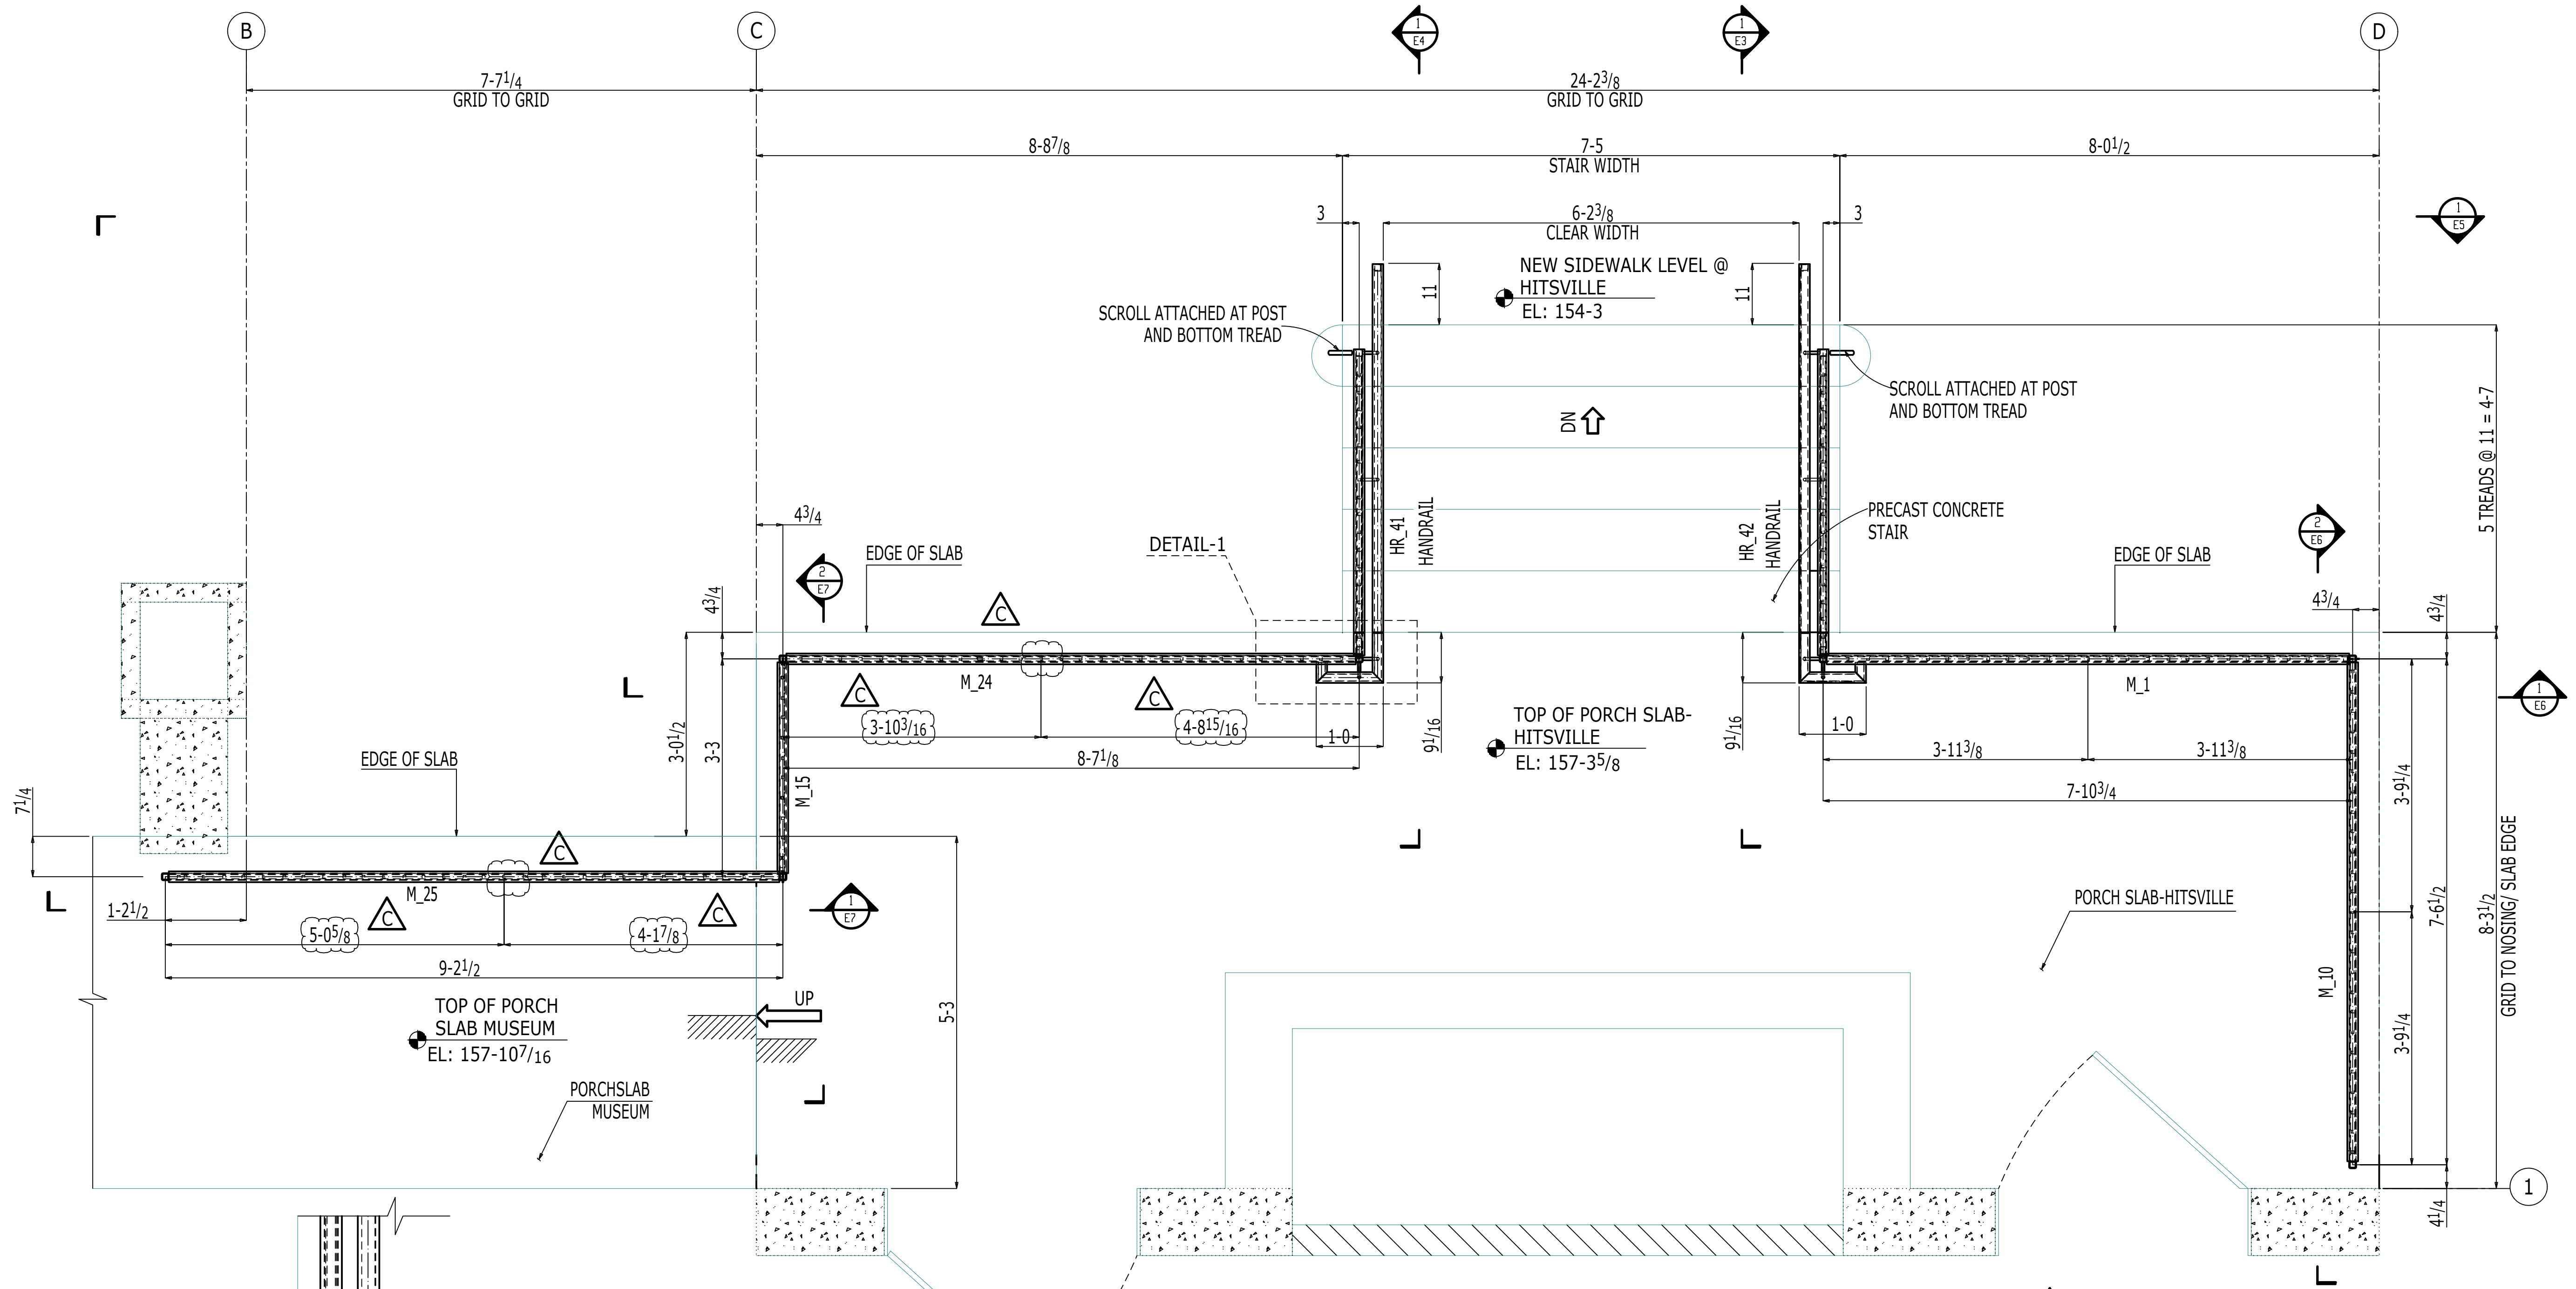

HANDRAILS AT NEW PRECAST STAIR - PLAN VIEW
 (REF DWG:2/A1.1)
 PROJECT NORTH

TYPICAL APPROVER NOTE:
 CONFIRM/ELSE ADVISE ON ALL MATERIALS, DIMENSIONS, ELEVATIONS AND CONNECTION DETAILS. THINGS WHICH WERE NOT COMMENTED WHILE APPROVAL RETURNS, WILL BE CONSIDERED AS APPROVED, AS SHOWN.

PAINT : HOT DIP GALVANIZED AND POWDER COATED A STANDARD BLACK COLOR.
PREPARATION : SSPC-SP3

NOT FOR CONSTRUCTION			
BY:		09-09-2022	REVISED AS MARKED
DATE:		07-06-2022	FOR RE-APPROVAL
		06-10-2022	FOR APPROVAL
			DESCRIPTION

DRAWING NOTES:
 ♦ ADD ADDITIONAL NOTES HERE (IF REQ'D)


MATERIAL: STEEL A53, A500 & A36 U.N.O.
HOLES: 13/16" U.N.O.
ELECTRODES: PER AWS D1.1 U.N.O.
WELD FINISH: NOMMA #3 U.N.O.
REF-DWG REF: A1.1, A1.1, A3.1, A3.2, A3.3, A4.1, ASK-2203144

FUTURE FABRICATING
 P: 586.755.7080 • F: 586.755.7456 • www.futurefabricating.com

DRAWING REVIEW / APPROVAL:
 THESE DRAWINGS REPRESENT FUTURE FABRICATING'S INTERPRETATION OF THE INTENT OF THE CONTRACT DOCUMENTS. EVERY EFFORT HAS BEEN MADE TO ENSURE THAT THEY ARE ACCURATE AND COMPLETE. APPROVAL BY THE AUTHORIZED PARTIES SHALL CONSTITUTE ACCEPTANCE AND ANY POST APPROVAL CHANGES WILL BE CONSIDERED TO BE CHANGES TO FUTURE FABRICATING'S CONTRACT.

DRAWN BY:	CHECKED BY:	FIELD MEASURED:
MSK	ARS	
DATE:	DATE:	DATE:
06-03-2022	06-03-2022	
JOB NUMBER:	REV:	
22-2089	E2	


PROJECT NAME: MOTOWN MUSEUM EXPANSION-PHASE 2
CUSTOMER: L.S.BRINKER

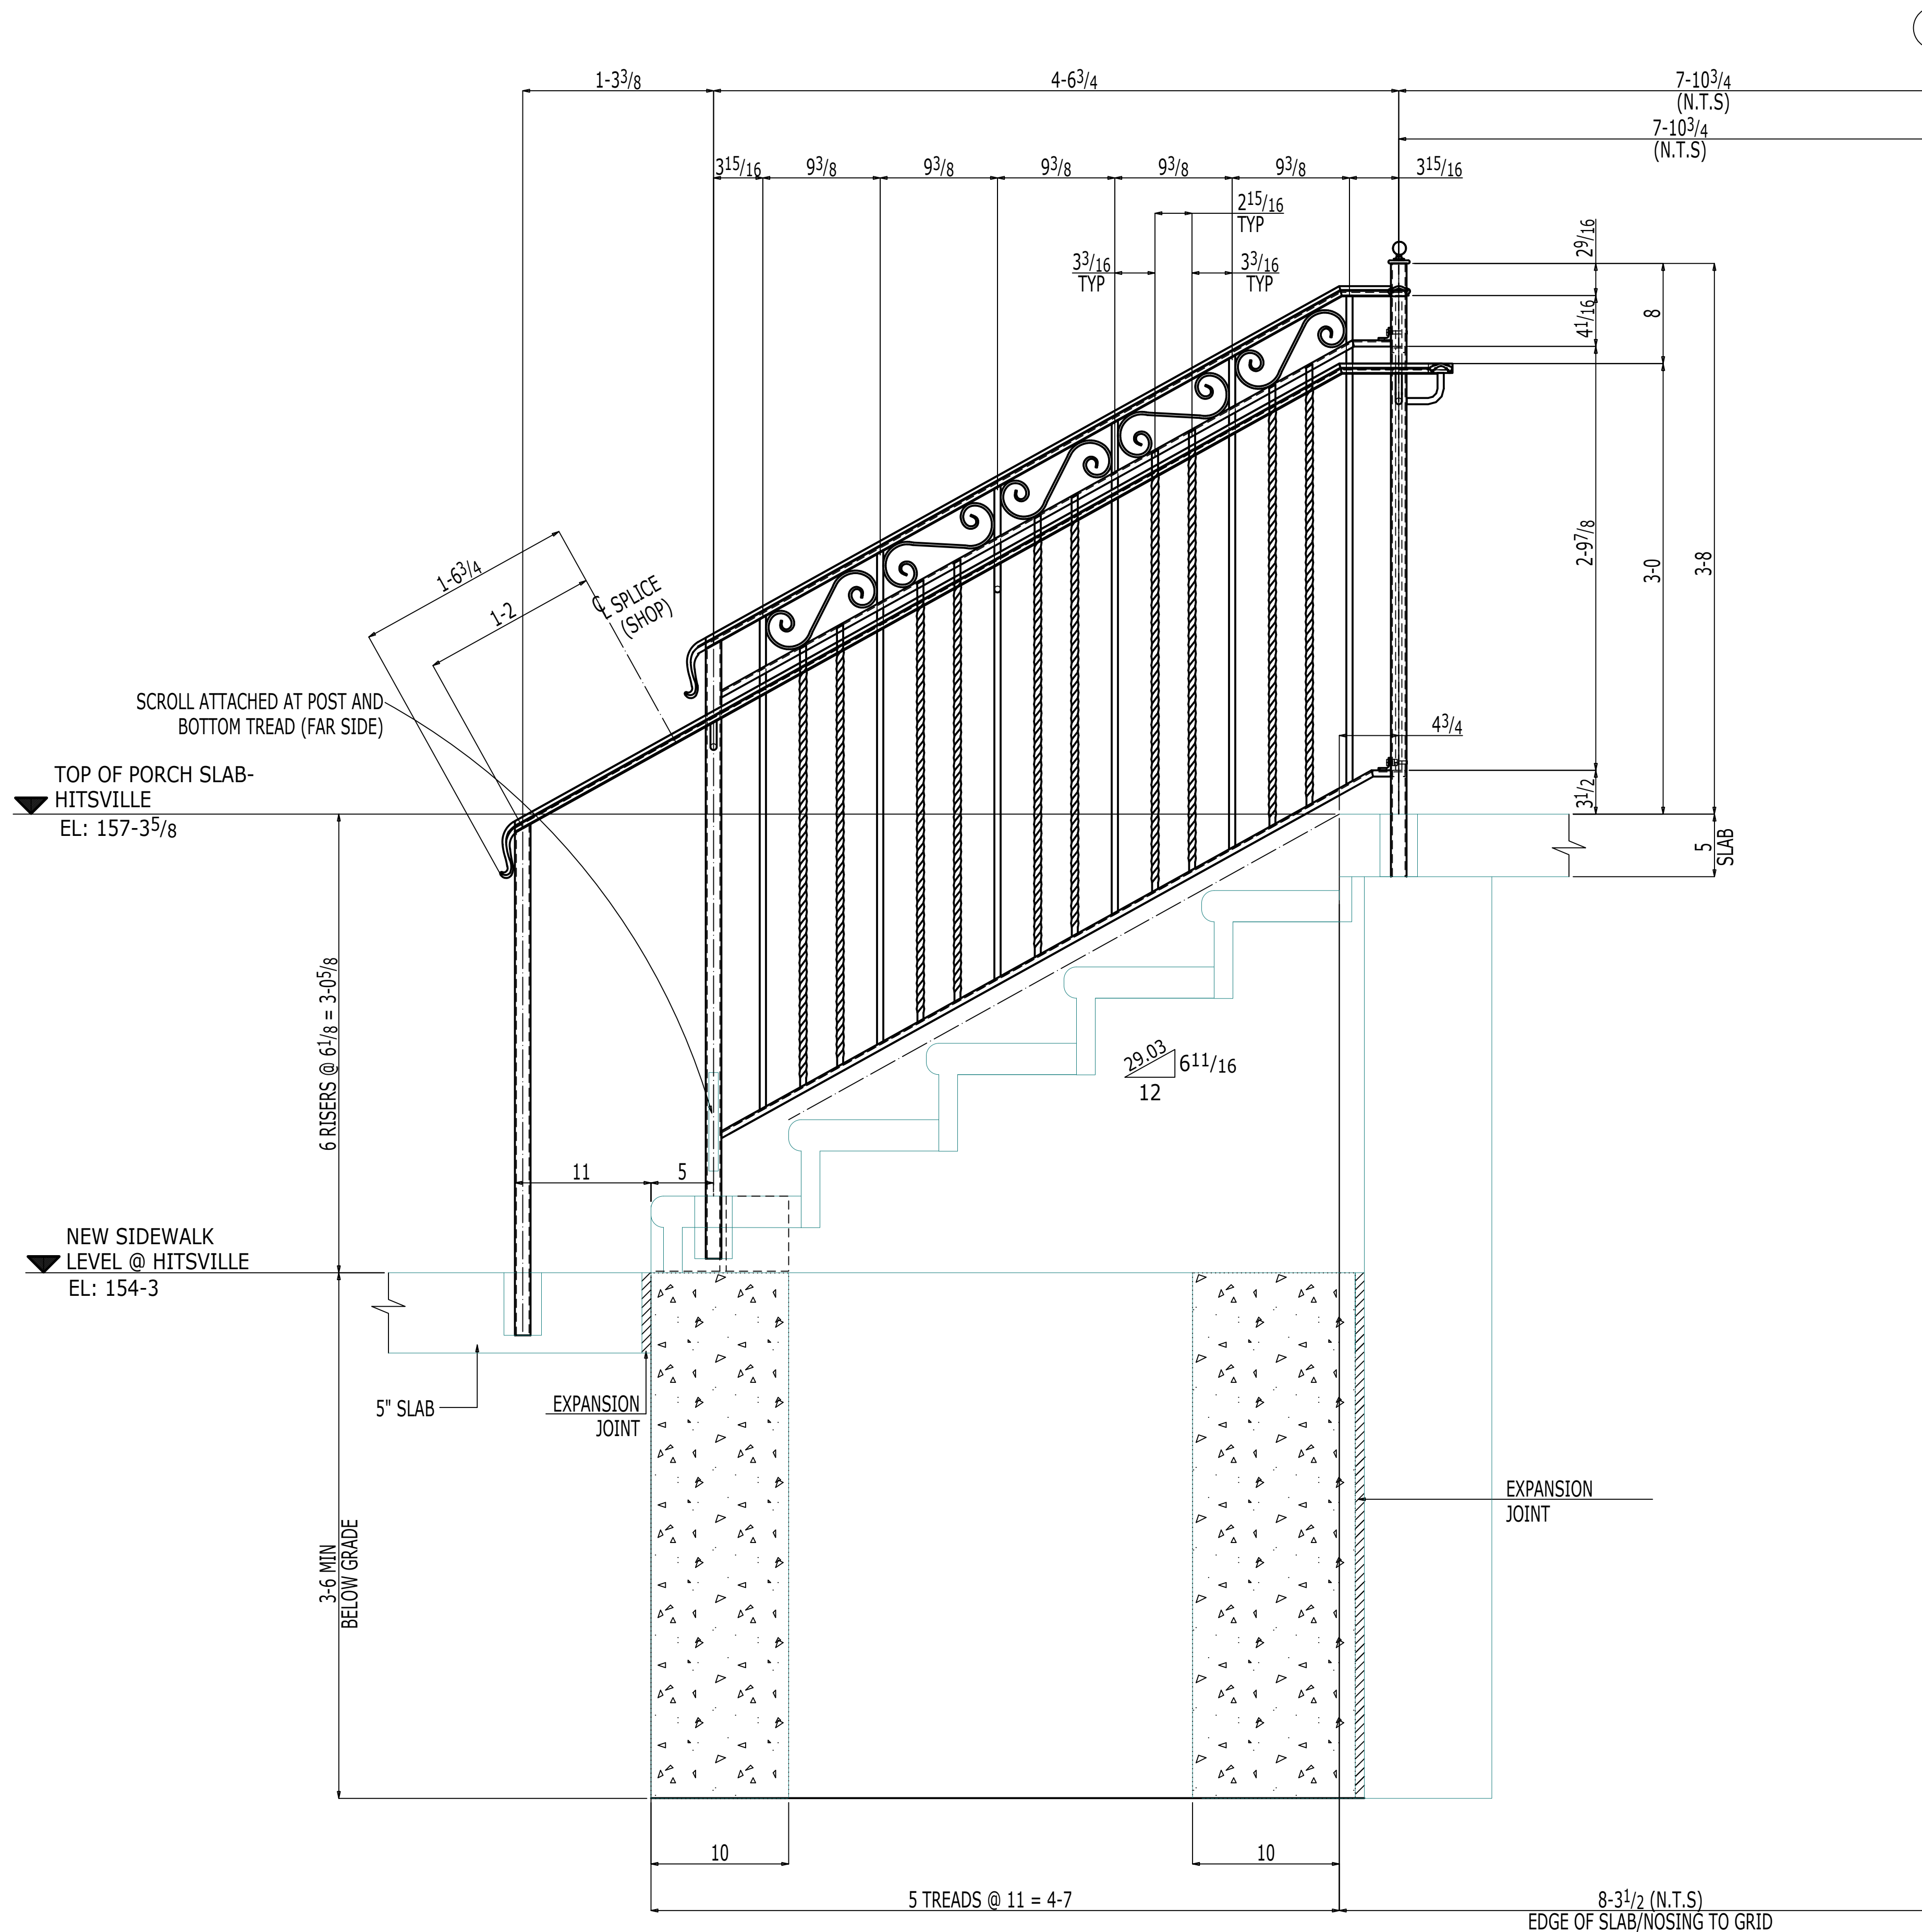

TYPICAL APPROVER NOTE:
 CONFIRM/ELSE ADVISE ON ALL MATERIALS, DIMENSIONS, ELEVATIONS AND CONNECTION DETAILS. THINGS WHICH WERE NOT COMMENTED WHILE APPROVAL RETURNS, WILL BE CONSIDERED AS APPROVED, AS SHOWN.

NOT FOR CONSTRUCTION			
BY:		09-09-2022	REVISED AS MARKED
DATE:		07-06-2022	FOR RE-APPROVAL
		06-10-2022	FOR APPROVAL
			DESCRIPTION


DRAWING NOTES:
 ♦ ADD ADDITIONAL NOTES HERE (IF REQ'D)
 MATERIAL: STEEL A53, A500 & A36 U.N.B.
 HOLES: 13/16" U.N.B.
 ELECTRODES: PER AWS D1.1 U.N.B.
 WELD FINISH: NOMMA #3 U.N.B.
 REF-DWG REF: AD1.1, A1.1, A3.1, A3.2, A3.3, A4.1, ASK-220314B

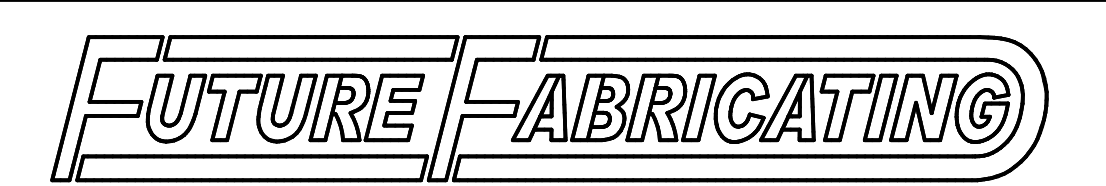

P: 586.755.7080 • F: 586.755.7456 • www.futurefabricating.com

DRAWING REVIEW / APPROVAL: THESE DRAWINGS REPRESENT FUTURE FABRICATING'S INTERPRETATION OF THE INTENT OF THE CONTRACT DOCUMENTS. EVERY EFFORT HAS BEEN MADE TO ENSURE THAT THEY ARE ACCURATE AND COMPLETE. APPROVAL BY THE AUTHORIZED PARTIES SHALL CONSTITUTE ACCEPTANCE AND ANY POST APPROVAL CHANGES WILL BE CONSIDERED TO BE CHANGES TO FUTURE FABRICATING'S CONTRACT. SHEET DESCRIPTION:		
DRAWN BY: MSK	CHECKED BY: ARS	FIELD MEASURED:
DATE: 06-03-2022	DATE: 06-03-2022	DATE:
JOB NUMBER: 22-2089	REV:	
PROJECT NAME: MOTOWN MUSEUM EXPANSION-PHASE 2	SHEET NUMBER: E3	
CUSTOMER: L.S.BRINKER		

1 SECTION VIEW
 E3 (REF DWG: 6/A1.1 & ASK-220314B)

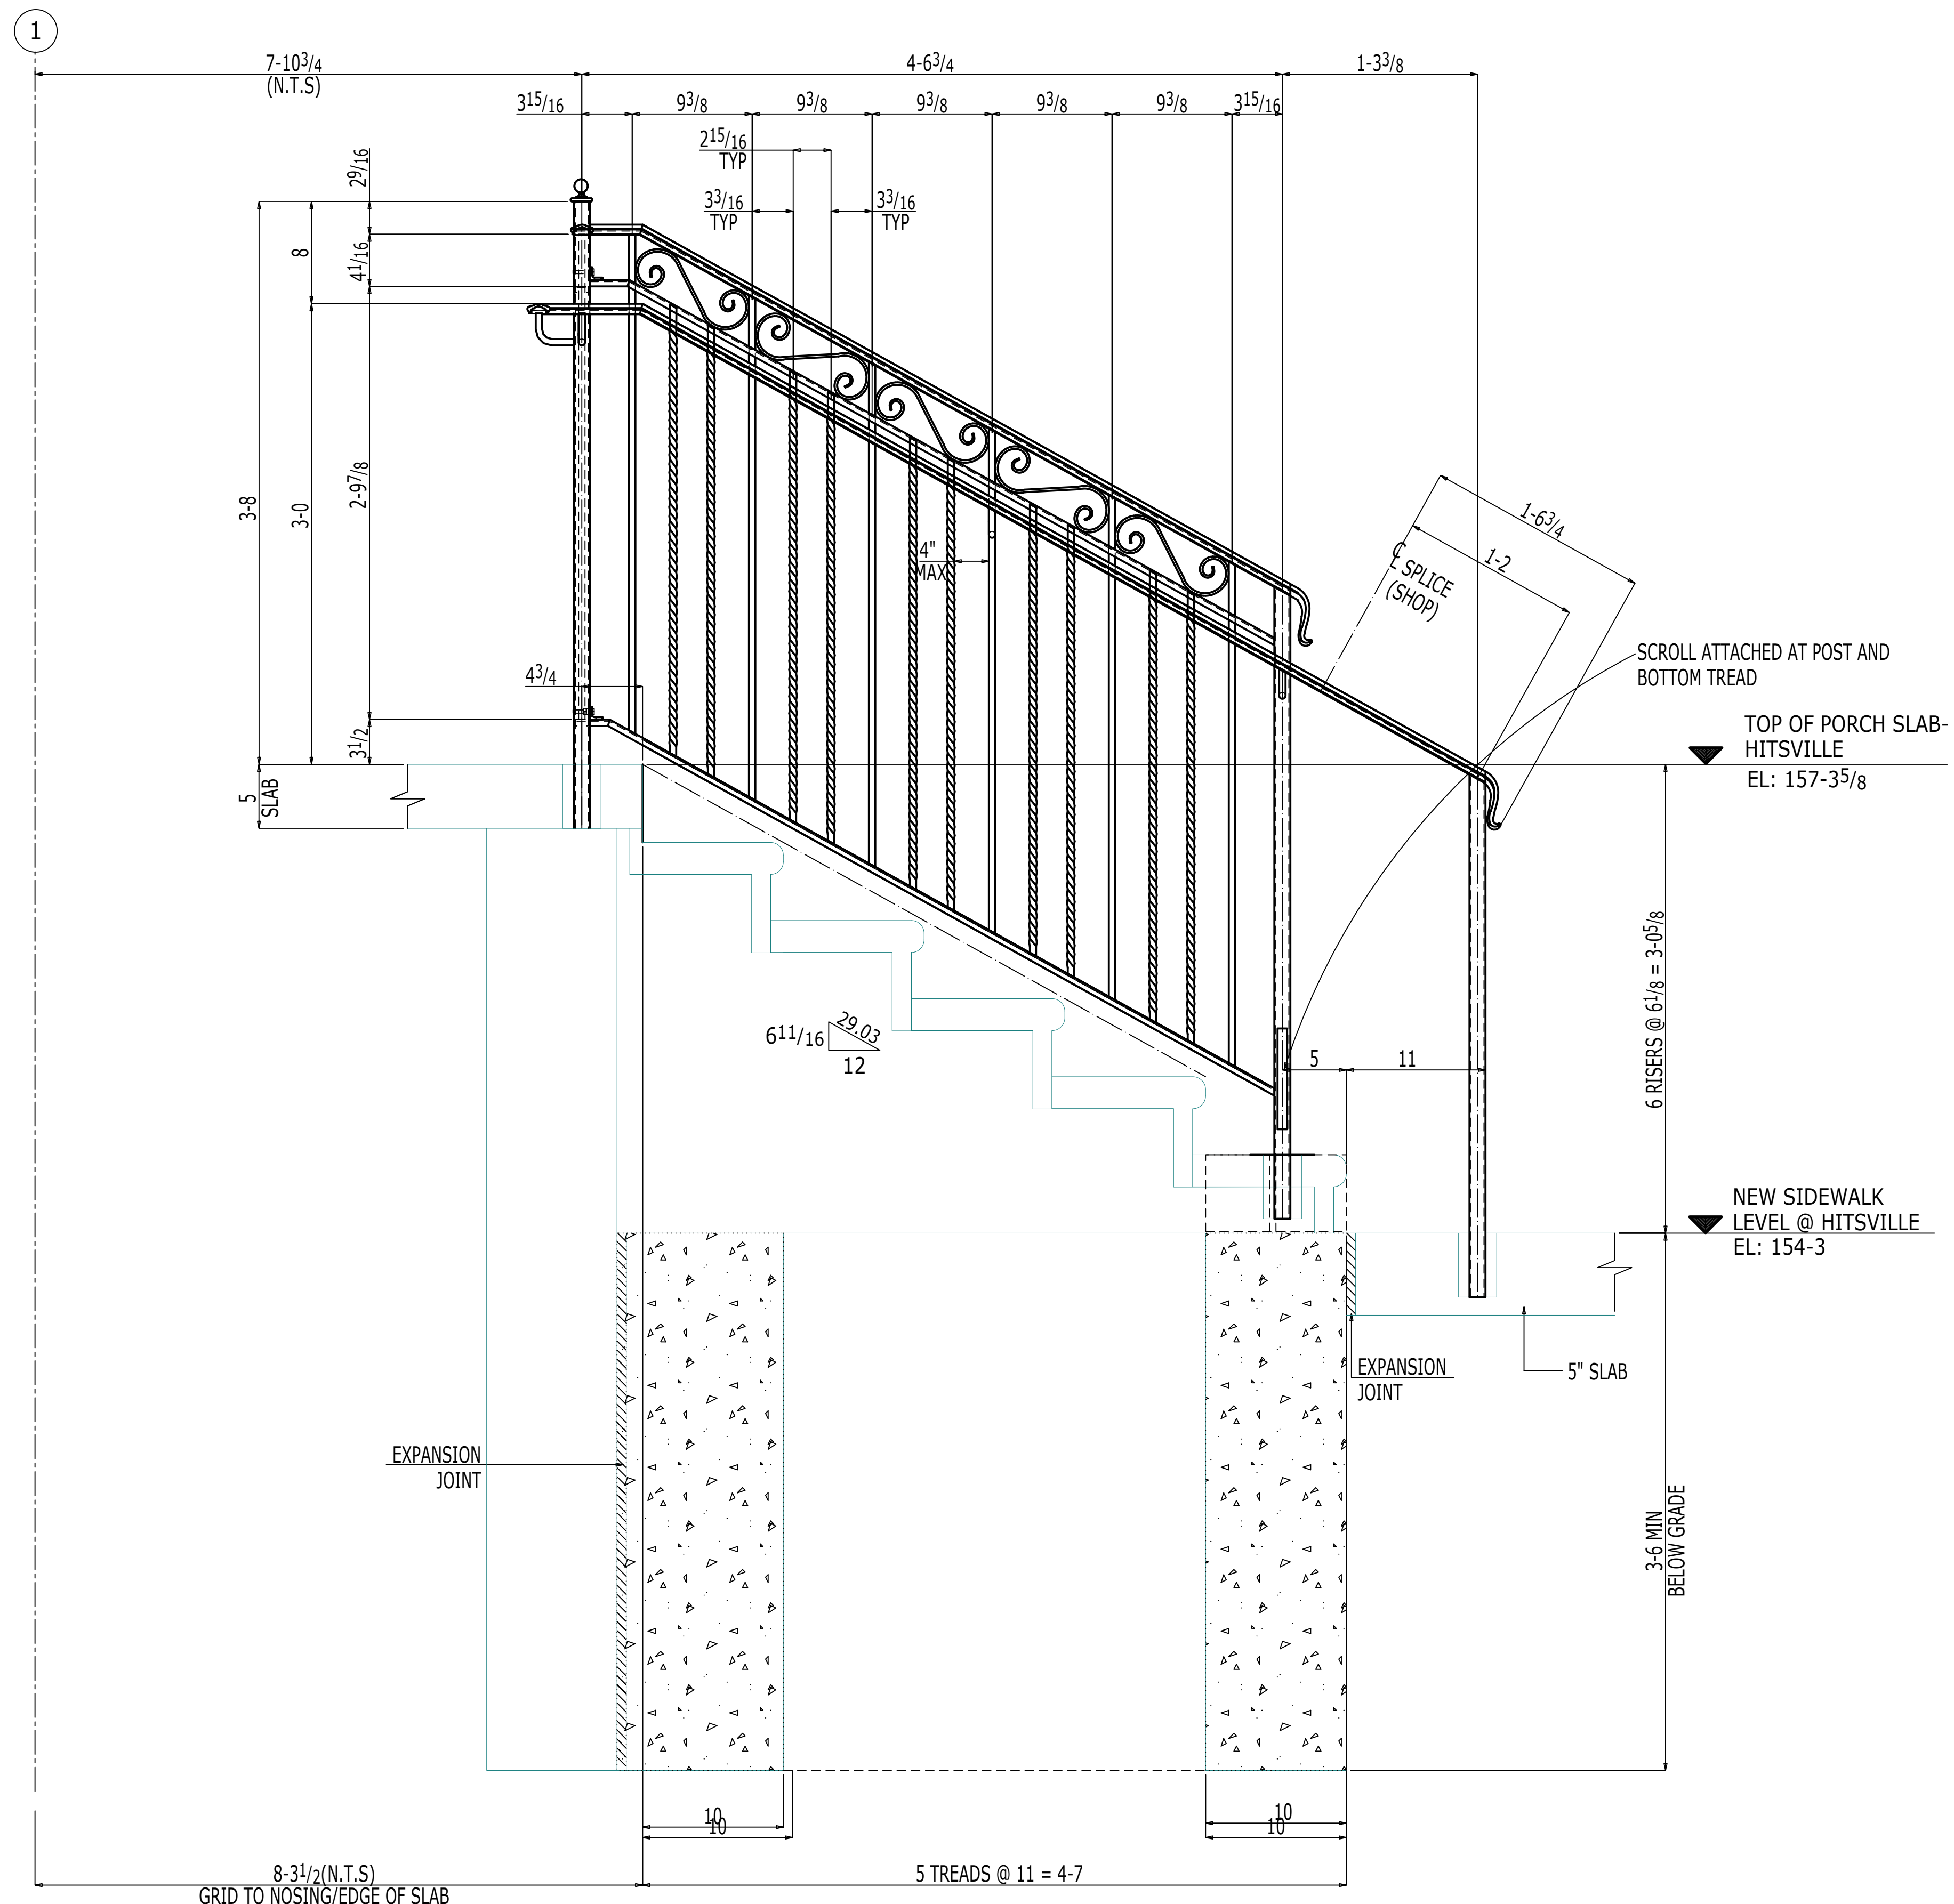


SECTION VIEW
 (REF DWG: 6/A1.1 & ASK-220314B)

TYPICAL APPROVER NOTE:
 CONFIRM/ELSE ADVISE ON ALL MATERIALS, DIMENSIONS, ELEVATIONS AND CONNECTION DETAILS. THINGS WHICH WERE NOT COMMENTED WHILE APPROVAL RETURNS, WILL BE CONSIDERED AS APPROVED, AS SHOWN.

NOT FOR CONSTRUCTION			
BY:		09-09-2022	REVISED AS MARKED
DATE:		07-05-2022	FOR RE-APPROVAL
		06-10-2022	FOR APPROVAL
		DATE	DESCRIPTION


DRAWING NOTES:
 ♦ ADD ADDITIONAL NOTES HERE (IF REQ'D)
 MATERIAL: STEEL A53, A500 & A36 U.N.O.
 HOLES: 13/16" U.N.O.
 ELECTRODES: PER AWS D1.1 U.N.O.
 WELD FINISH: NOMMA #3 U.N.O.
 REF-DWG REF: AD1.1, A1.1, A3.1, A3.2, A3.3, A4.1, ASK-220314B

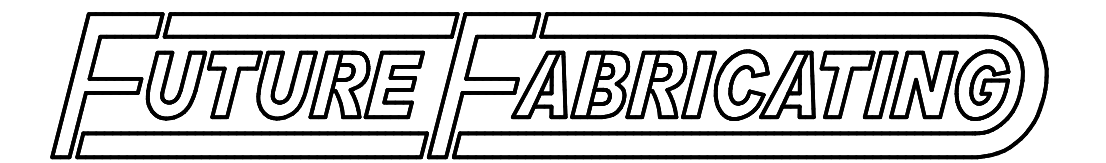

P: 586.755.7080 • F: 586.755.7456 • www.futurefabricating.com

DRAWING REVIEW / APPROVAL: THESE DRAWINGS REPRESENT FUTURE FABRICATING'S INTERPRETATION OF THE INTENT OF THE CONTRACT DOCUMENTS. EVERY EFFORT HAS BEEN MADE TO ENSURE THAT THEY ARE ACCURATE AND COMPLETE. APPROVAL BY THE AUTHORIZED PARTIES SHALL CONSTITUTE ACCEPTANCE AND ANY POST APPROVAL CHANGES WILL BE CONSIDERED TO BE CHANGES TO FUTURE FABRICATING'S CONTRACT. SHEET DESCRIPTION:		
DRAWN BY: MSK	CHECKED BY: ARS	FIELD MEASURED: DATE:
DATE: 06-03-2022	DATE: 06-03-2022	DATE:
JOB NUMBER: 22-2089	REV:	REV:
PROJECT NAME: MOTOWN MUSEUM EXPANSION-PHASE 2	SHEET NUMBER: E4	DATE: Sep 09 2022
CUSTOMER: L.S. BRINKER		

Hitsville U.S.A.

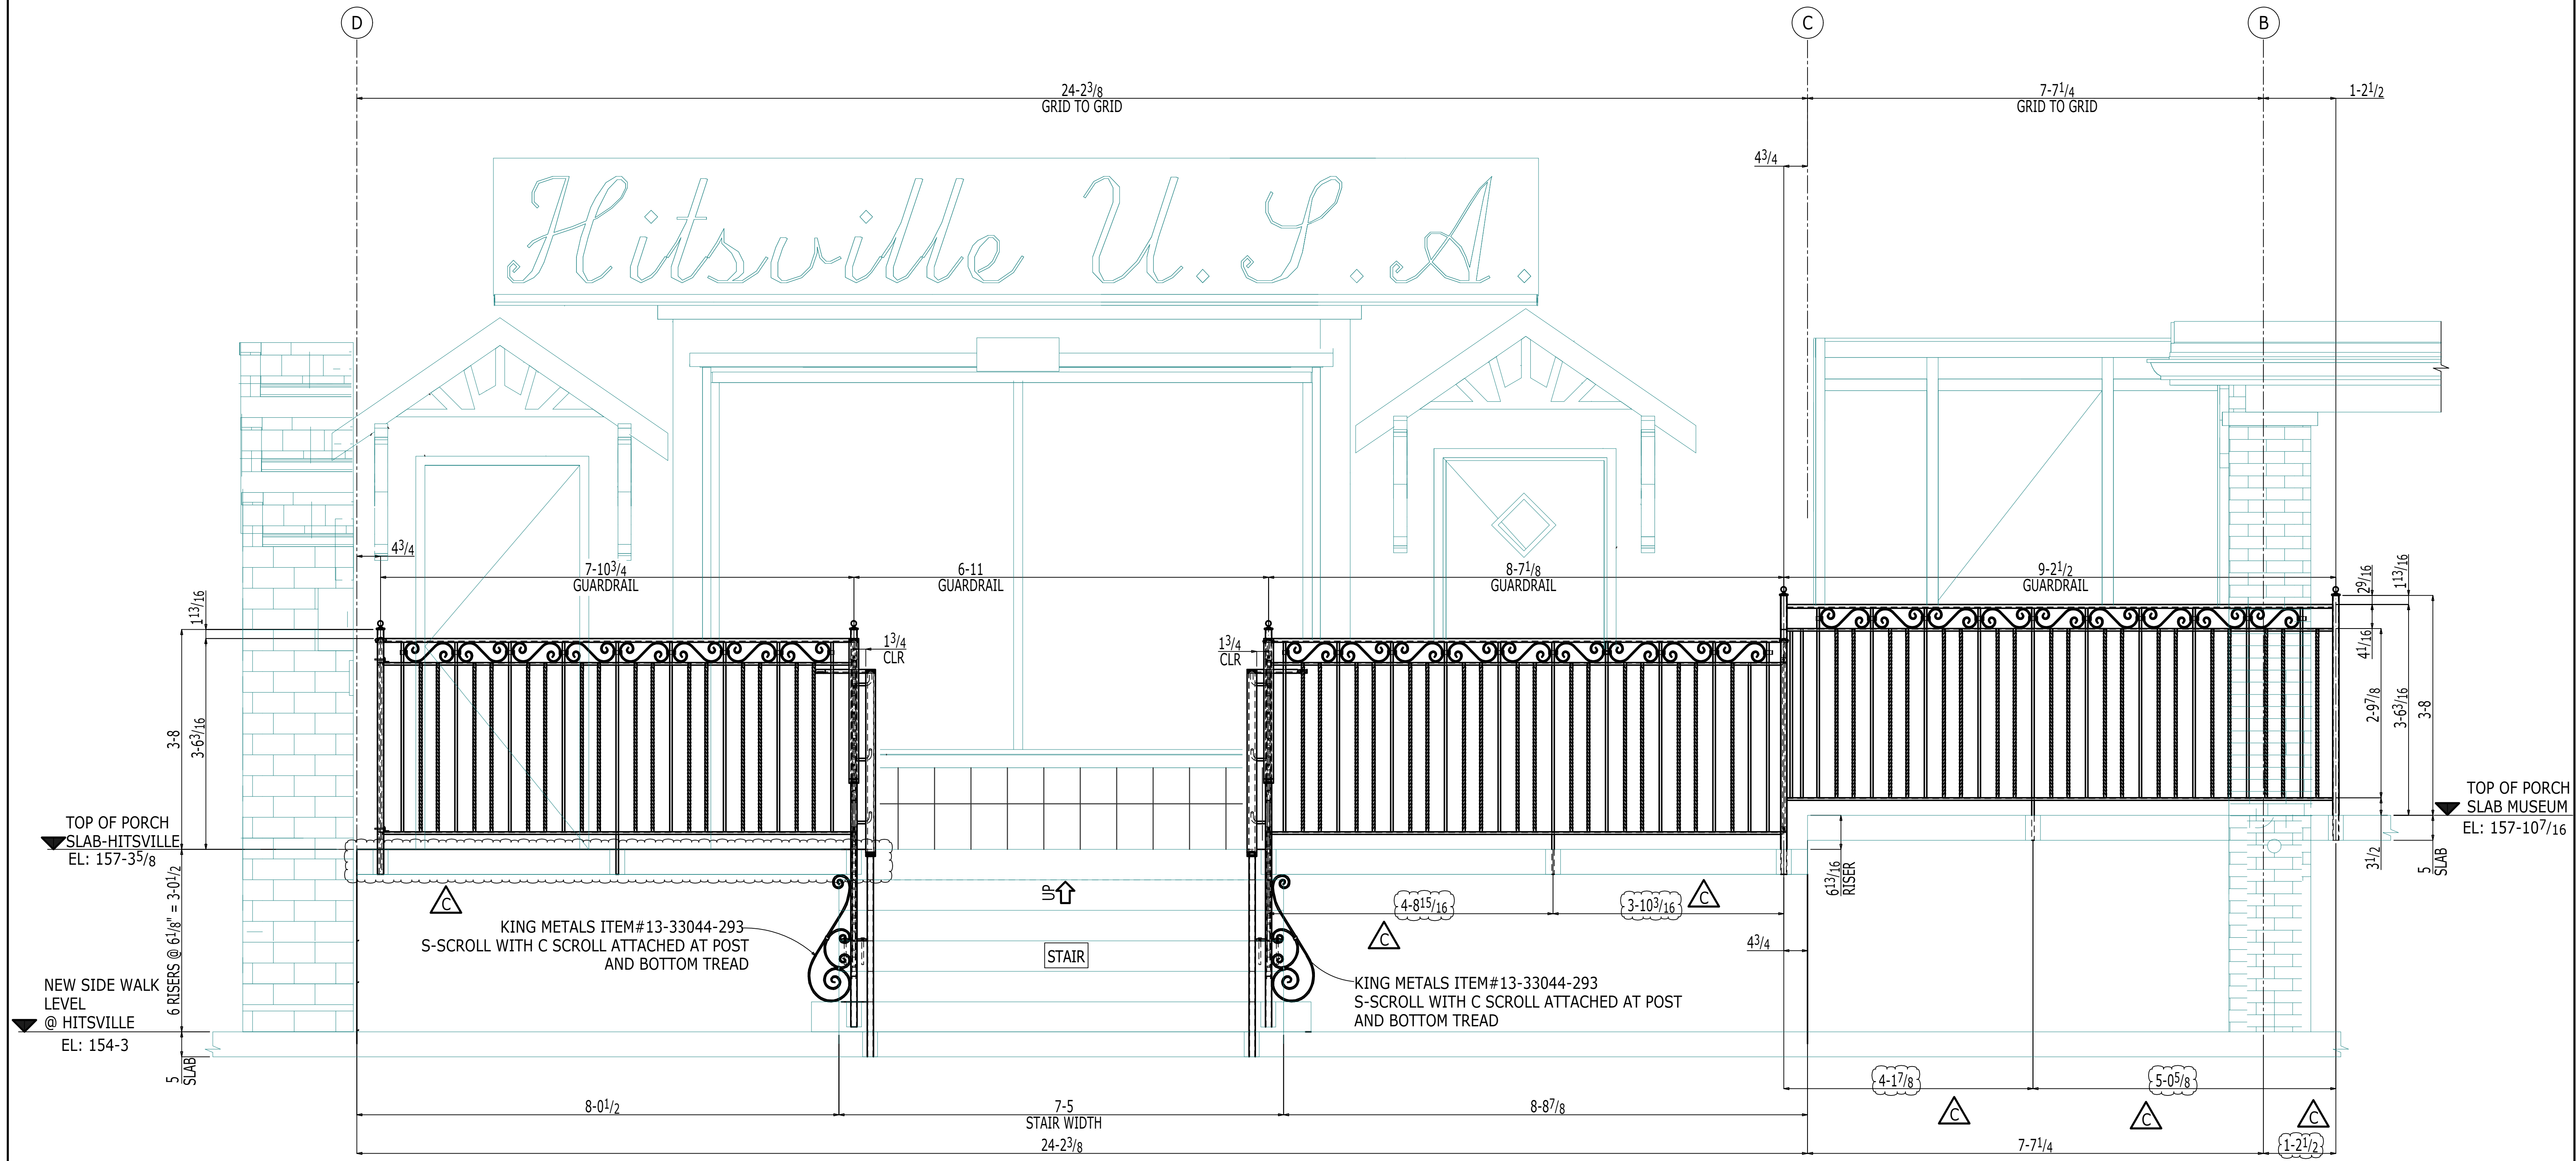

1 SECTION VIEW
E5

TOP OF PORCH
SLAB-HITSVILLE
EL: 157-35⁷/₈

NEW SIDE WALK
LEVEL
@ HITSVILLE
EL: 154-3

TOP OF PORCH
SLAB MUSEUM
EL: 157-10⁷/₁₆

KING METALS ITEM#13-33044-293
S-SCROLL WITH C SCROLL ATTACHED AT POST
AND BOTTOM TREAD


KING METALS ITEM#13-33044-293
S-SCROLL WITH C SCROLL ATTACHED AT POST
AND BOTTOM TREAD

TYPICAL APPROVER NOTE:

CONFIRM/ELSE ADVISE ON ALL MATERIALS, DIMENSIONS,
ELEVATIONS AND CONNECTION DETAILS.
THINGS WHICH WERE NOT COMMENTED WHILE APPROVAL
RETURNS, WILL BE CONSIDERED AS APPROVED, AS SHOWN.


NOT FOR CONSTRUCTION			
BY:		09-09-2022	REVISED AS MARKED
DATE:		07-06-2022	FOR RE-APPROVAL
		06-10-2022	FOR APPROVAL
			DESCRIPTION

DRAWING NOTES:
 ◆ ADD ADDITIONAL NOTES HERE (IF REQ'D)
 MATERIAL: STEEL A53, A500 & A36 U.N.O.
 HOLES: 13/16" U.N.O.
 ELECTRODES: PER AWS D1.1 U.N.O.
 WELD FINISH: NOMMA #3 U.N.O.
 REF-DRWG REF: A01.1, A1.1, A3.1, A3.2, A3.3, A4.1, A5C-220344

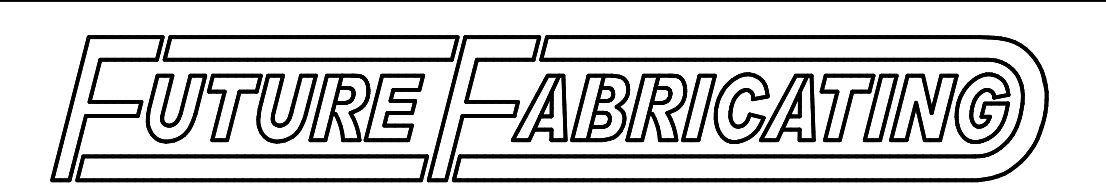


P: 586.755.7080 • F: 586.755.7456 • www.futurefabricating.com

DRAWING REVIEW / APPROVAL: THESE DRAWINGS REPRESENT FUTURE FABRICATING'S INTERPRETATION OF THE INTENT OF THE CONTRACT DOCUMENTS. EVERY EFFORT HAS BEEN MADE TO ENSURE THAT THEY ARE ACCURATE AND COMPLETE. APPROVAL BY THE AUTHORIZED PARTIES SHALL CONSTITUTE ACCEPTANCE AND ANY POST APPROVAL CHANGES WILL BE CONSIDERED TO BE CHANGES TO FUTURE FABRICATING'S CONTRACT.		
DRAWN BY: MSK	CHECKED BY: ARS	FIELD MEASURED:
DATE: 06-03-2022	DATE: 06-03-2022	DATE:
JOB NUMBER: 22-2089	REV:	
HANDRAILS AT NEW PRECAST STAIR - ELEVATION		
PROJECT NAME: MOTOWN MUSEUM EXPANSION-PHASE 2		
CUSTOMER: L.S.BRINKER		
SHEET NUMBER: E5		

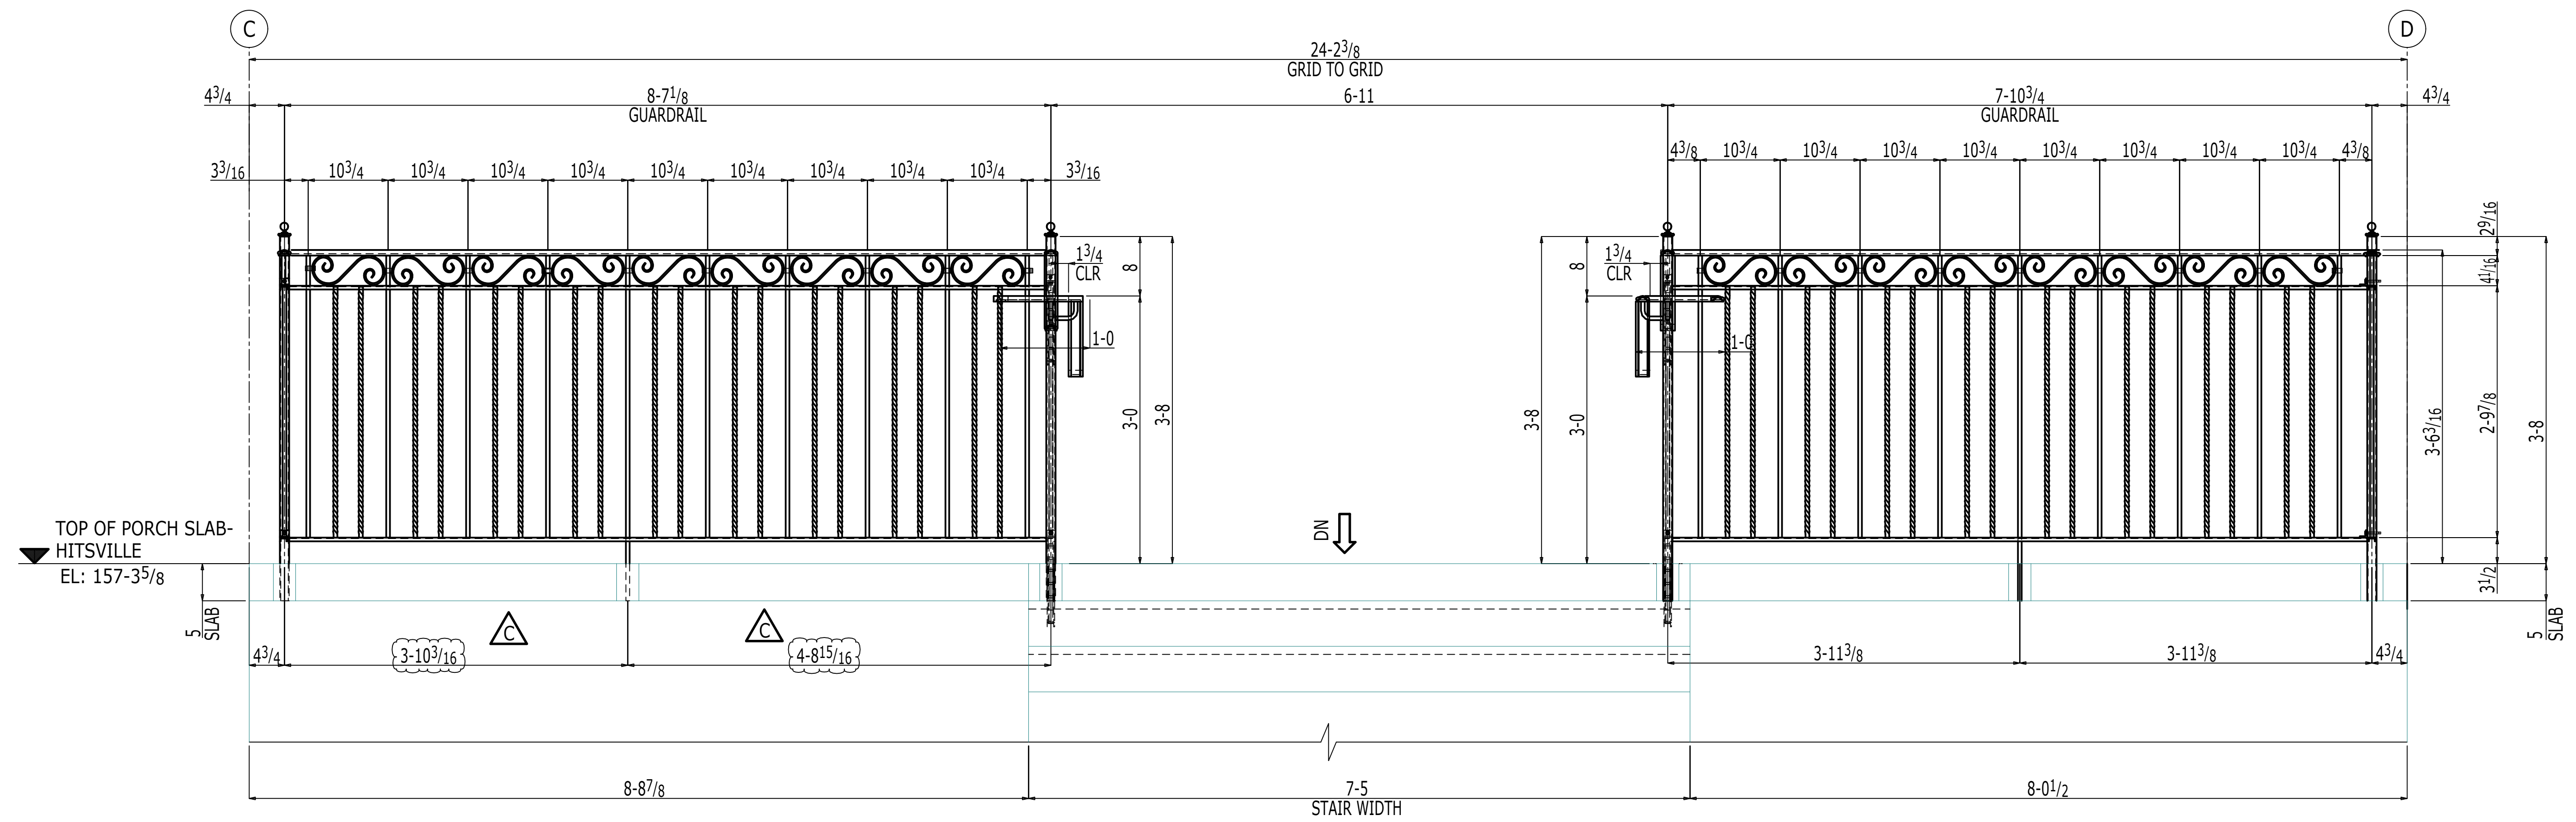

1 SECTION VIEW
E6

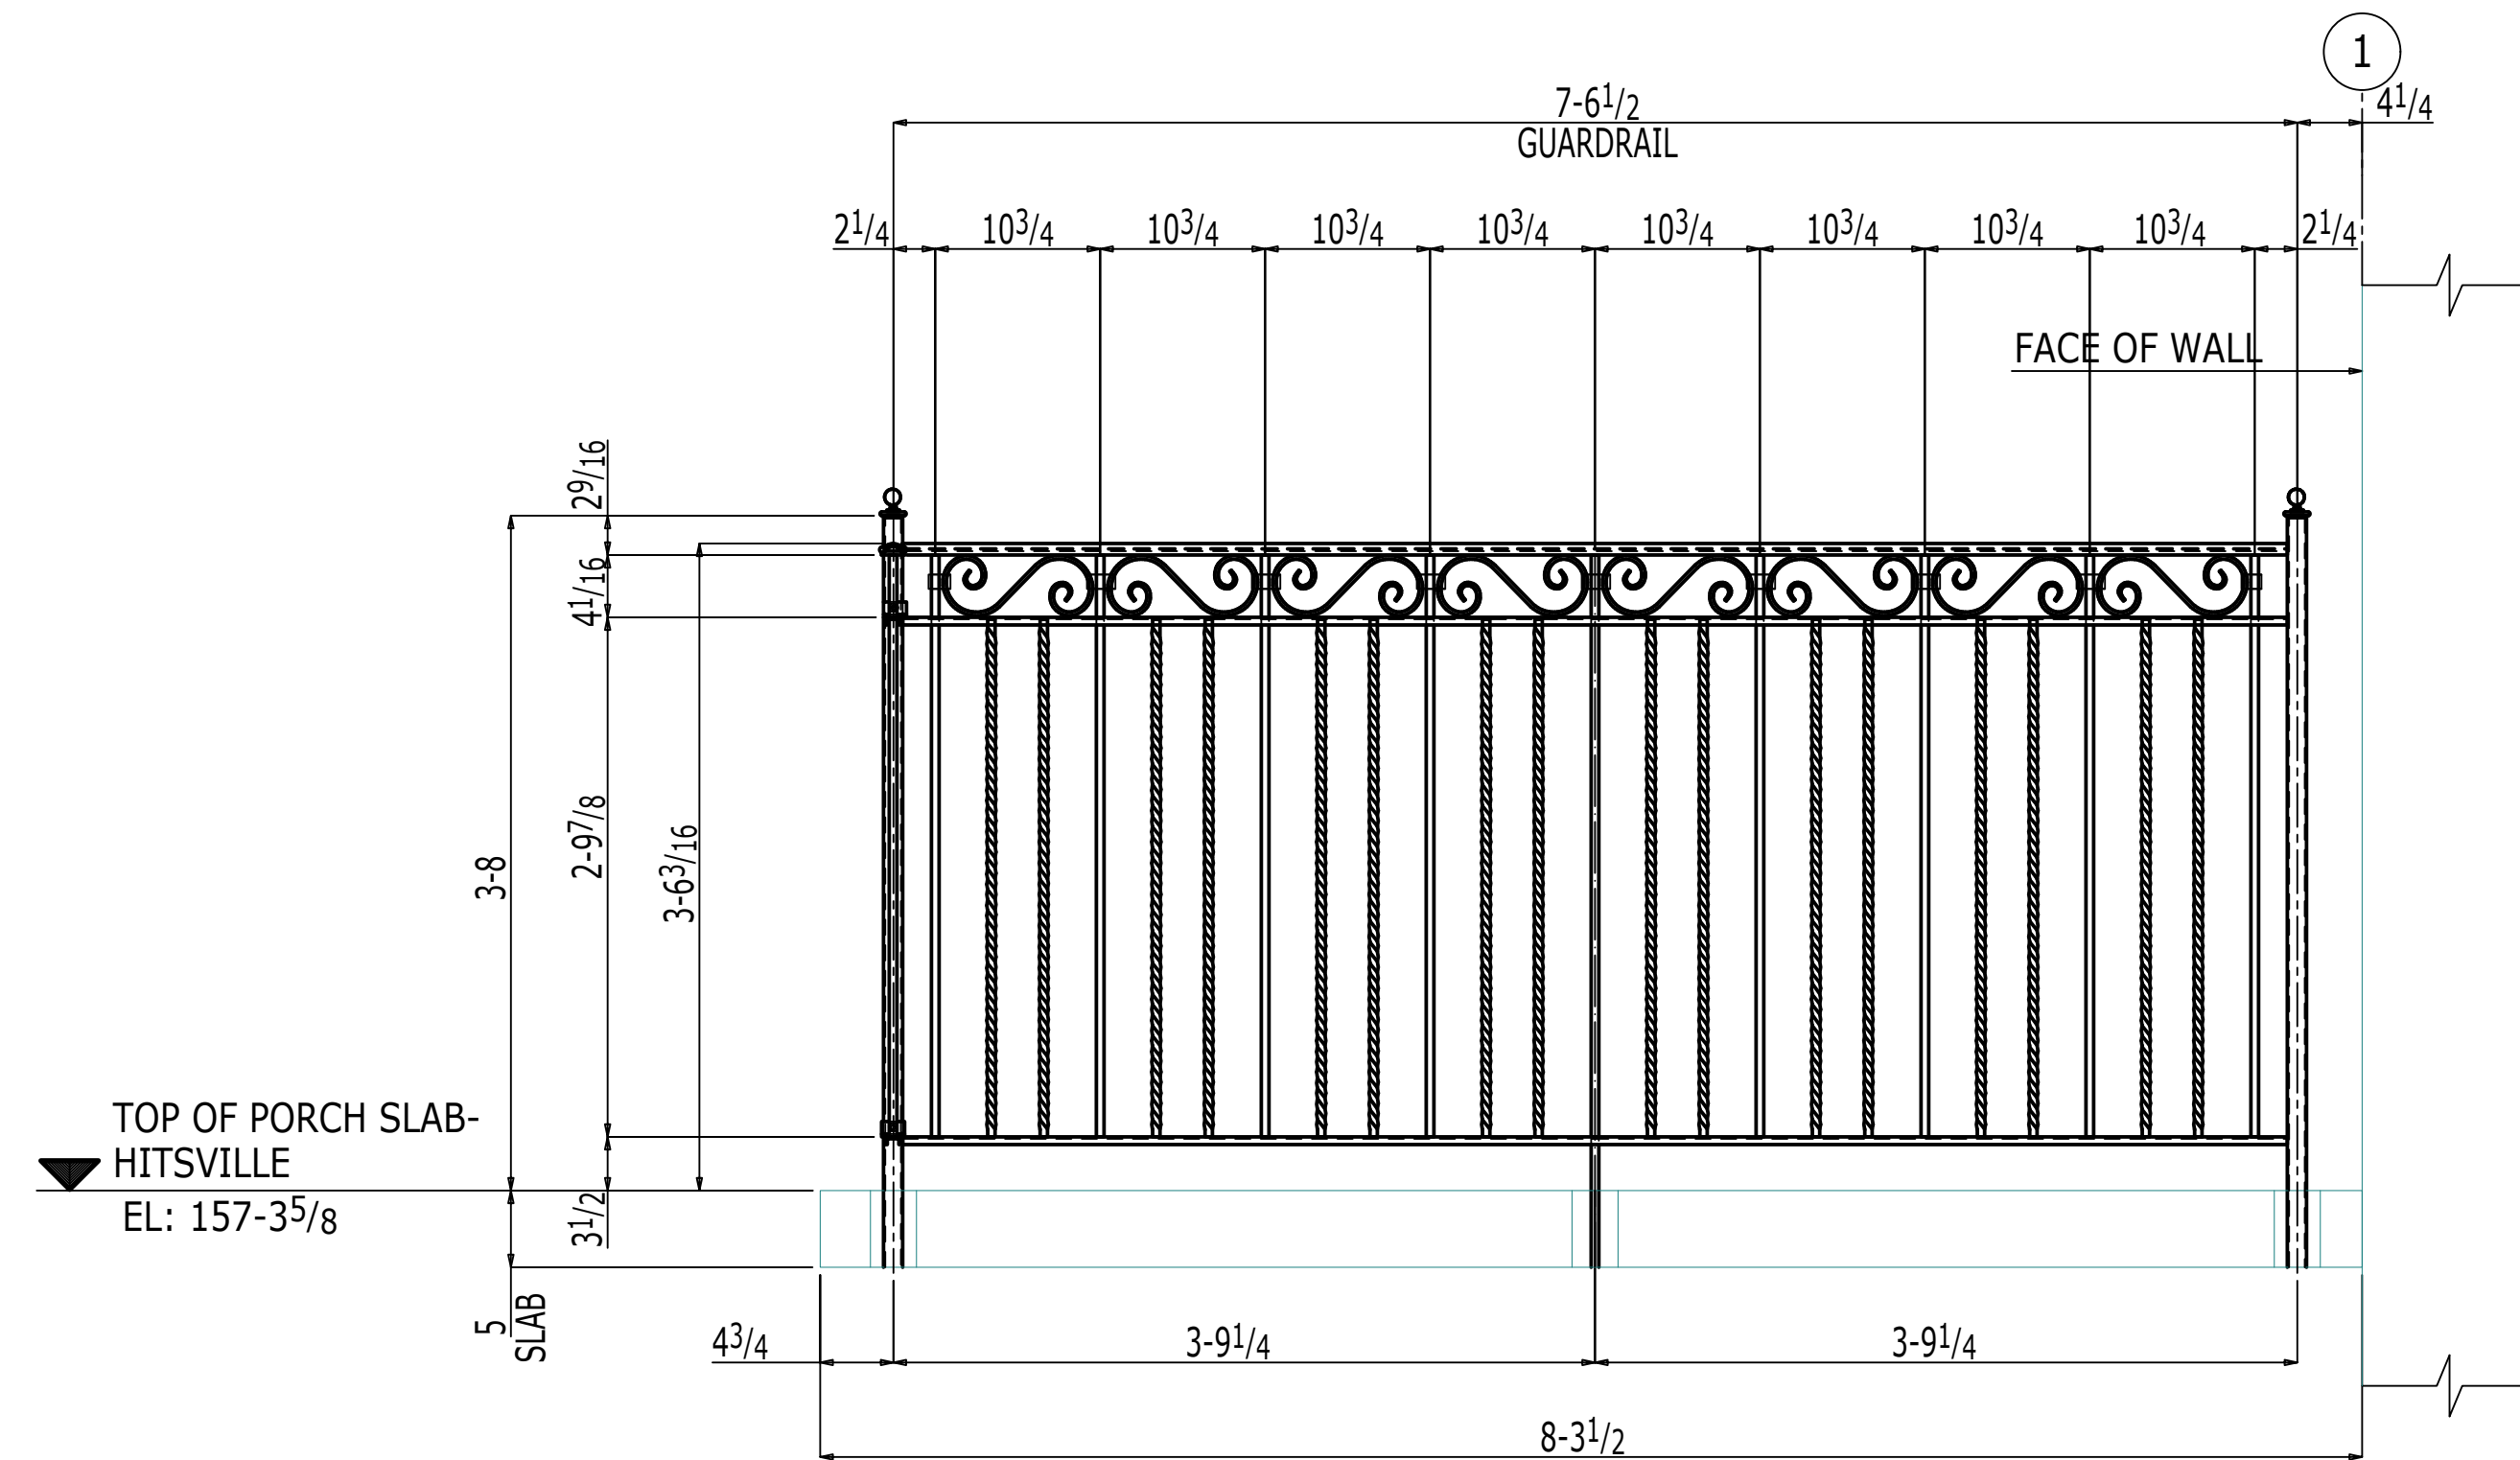

2 SECTION VIEW
E6

TYPICAL APPROVER NOTE:
 CONFIRM/ELSE ADVISE ON ALL MATERIALS, DIMENSIONS, ELEVATIONS AND CONNECTION DETAILS. THINGS WHICH WERE NOT COMMENTED WHILE APPROVAL RETURNS, WILL BE CONSIDERED AS APPROVED, AS SHOWN.

NOT FOR CONSTRUCTION			
BY:		09-09-2022	REVISED AS MARKED
DATE:		07-06-2022	FOR RE-APPROVAL
		06-10-2022	FOR APPROVAL
			DATE DESCRIPTION

DRAWING NOTES:
 ♦ ADD ADDITIONAL NOTES HERE (IF REQ'D)

MATERIAL: STEEL A53, A500 & A36 U.N.O.
 HOLES: 13/16" U.N.O.
 ELECTRODES: PER AWS D1.1 U.N.O.
 WELD FINISH: NOMMA #3 U.N.O.
 REF-DWG REF: A01.1, A1.1, A3.1, A3.2, A3.3, A4.1, A5C-2020144


FUTURE FABRICATING
 P: 586.755.7080 • F: 586.755.7456 • www.futurefabricating.com

DRAWING REVIEW / APPROVAL:
 THESE DRAWINGS REPRESENT FUTURE FABRICATING'S INTERPRETATION OF THE INTENT OF THE CONTRACT DOCUMENTS. EVERY EFFORT HAS BEEN MADE TO ENSURE THAT THEY ARE ACCURATE AND COMPLETE. APPROVAL BY THE AUTHORIZED PARTIES SHALL CONSTITUTE ACCEPTANCE AND ANY POST APPROVAL CHANGES WILL BE CONSIDERED TO BE CHANGES TO FUTURE FABRICATING'S CONTRACT.

DRAWN BY:	CHECKED BY:	FIELD MEASURED:
MSK	ARS	
DATE:	DATE:	DATE:
06-03-2022	06-03-2022	
JOB NUMBER:	REV:	


HANDRAILS AT NEW PRECAST STAIR - ELEVATION
 PROJECT NAME:
 MOTOWN MUSEUM EXPANSION-PHASE 2
 CUSTOMER:
 L.S.BRINKER

SHEET NUMBER:
22-2089
E6

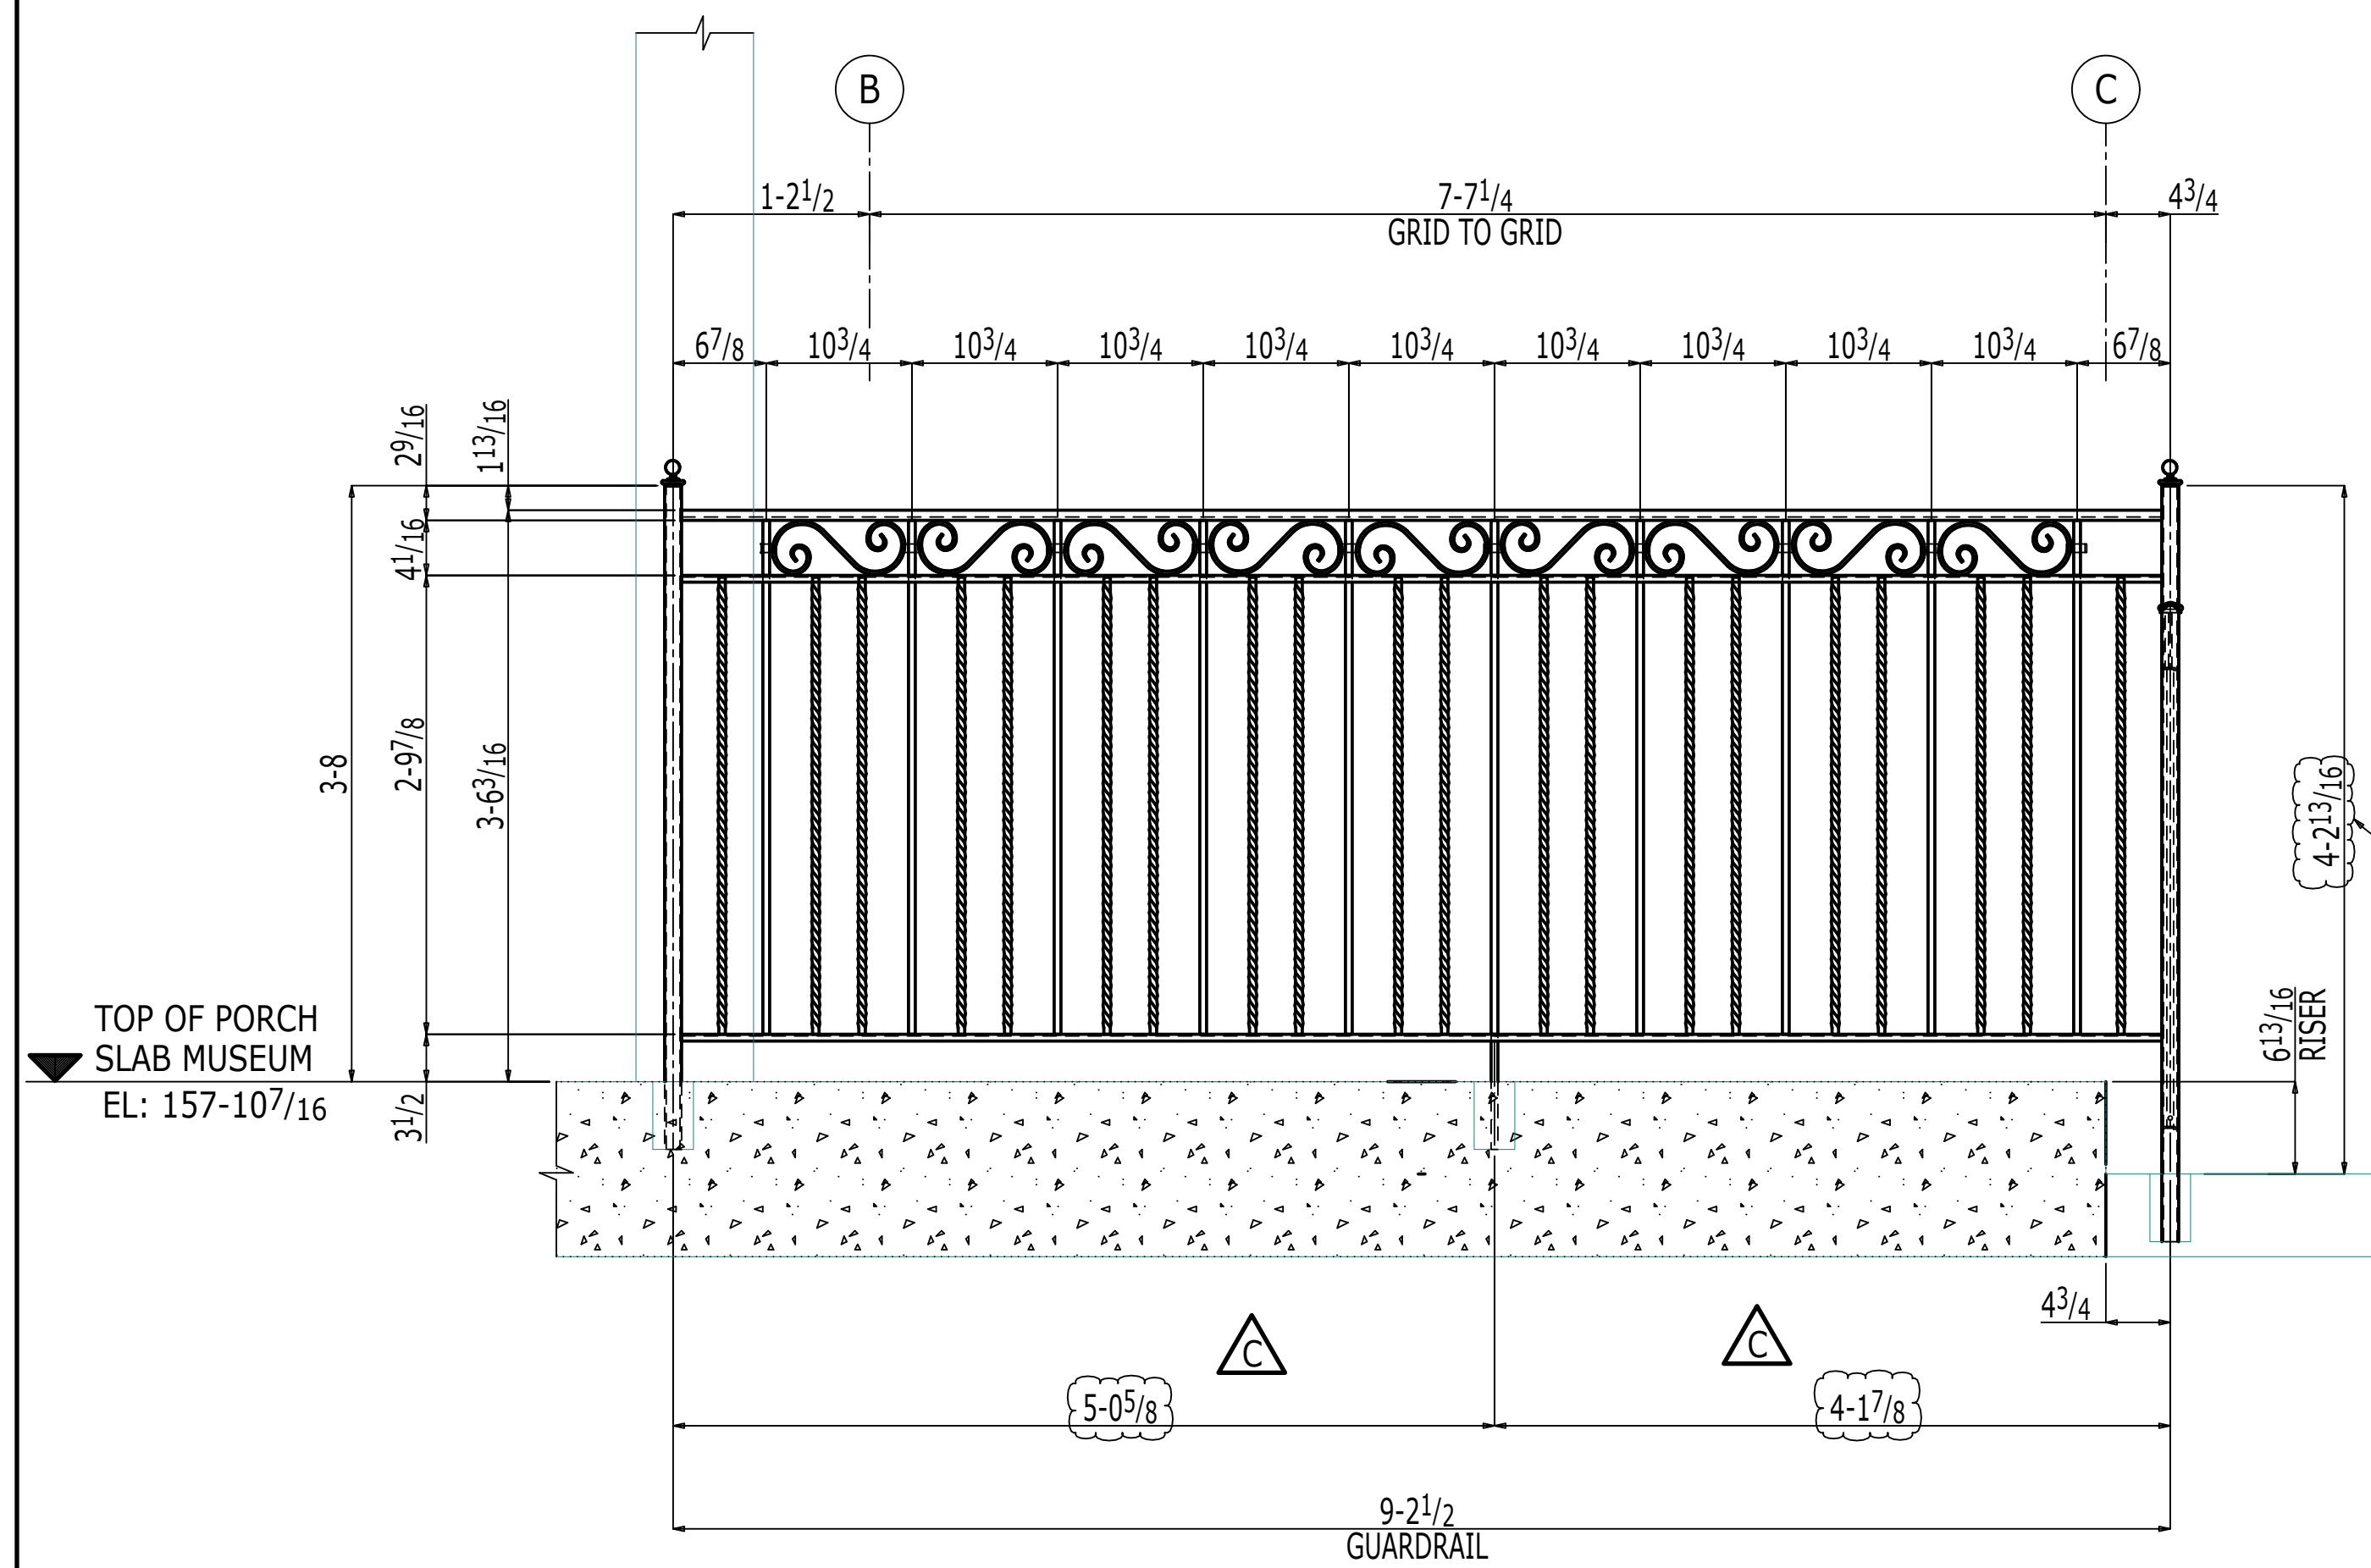

1 SECTION VIEW
E7

APPROVER NOTE:
DUE TO THE 6 13/16" SLAB DIFFERENCE, POST LENGTH IS EXCEEDING 3'-8" (i.e., 4'-2 13/16") TO MATCH WITH RAILING AT SLAB MUSEUM. AS SHOWN.

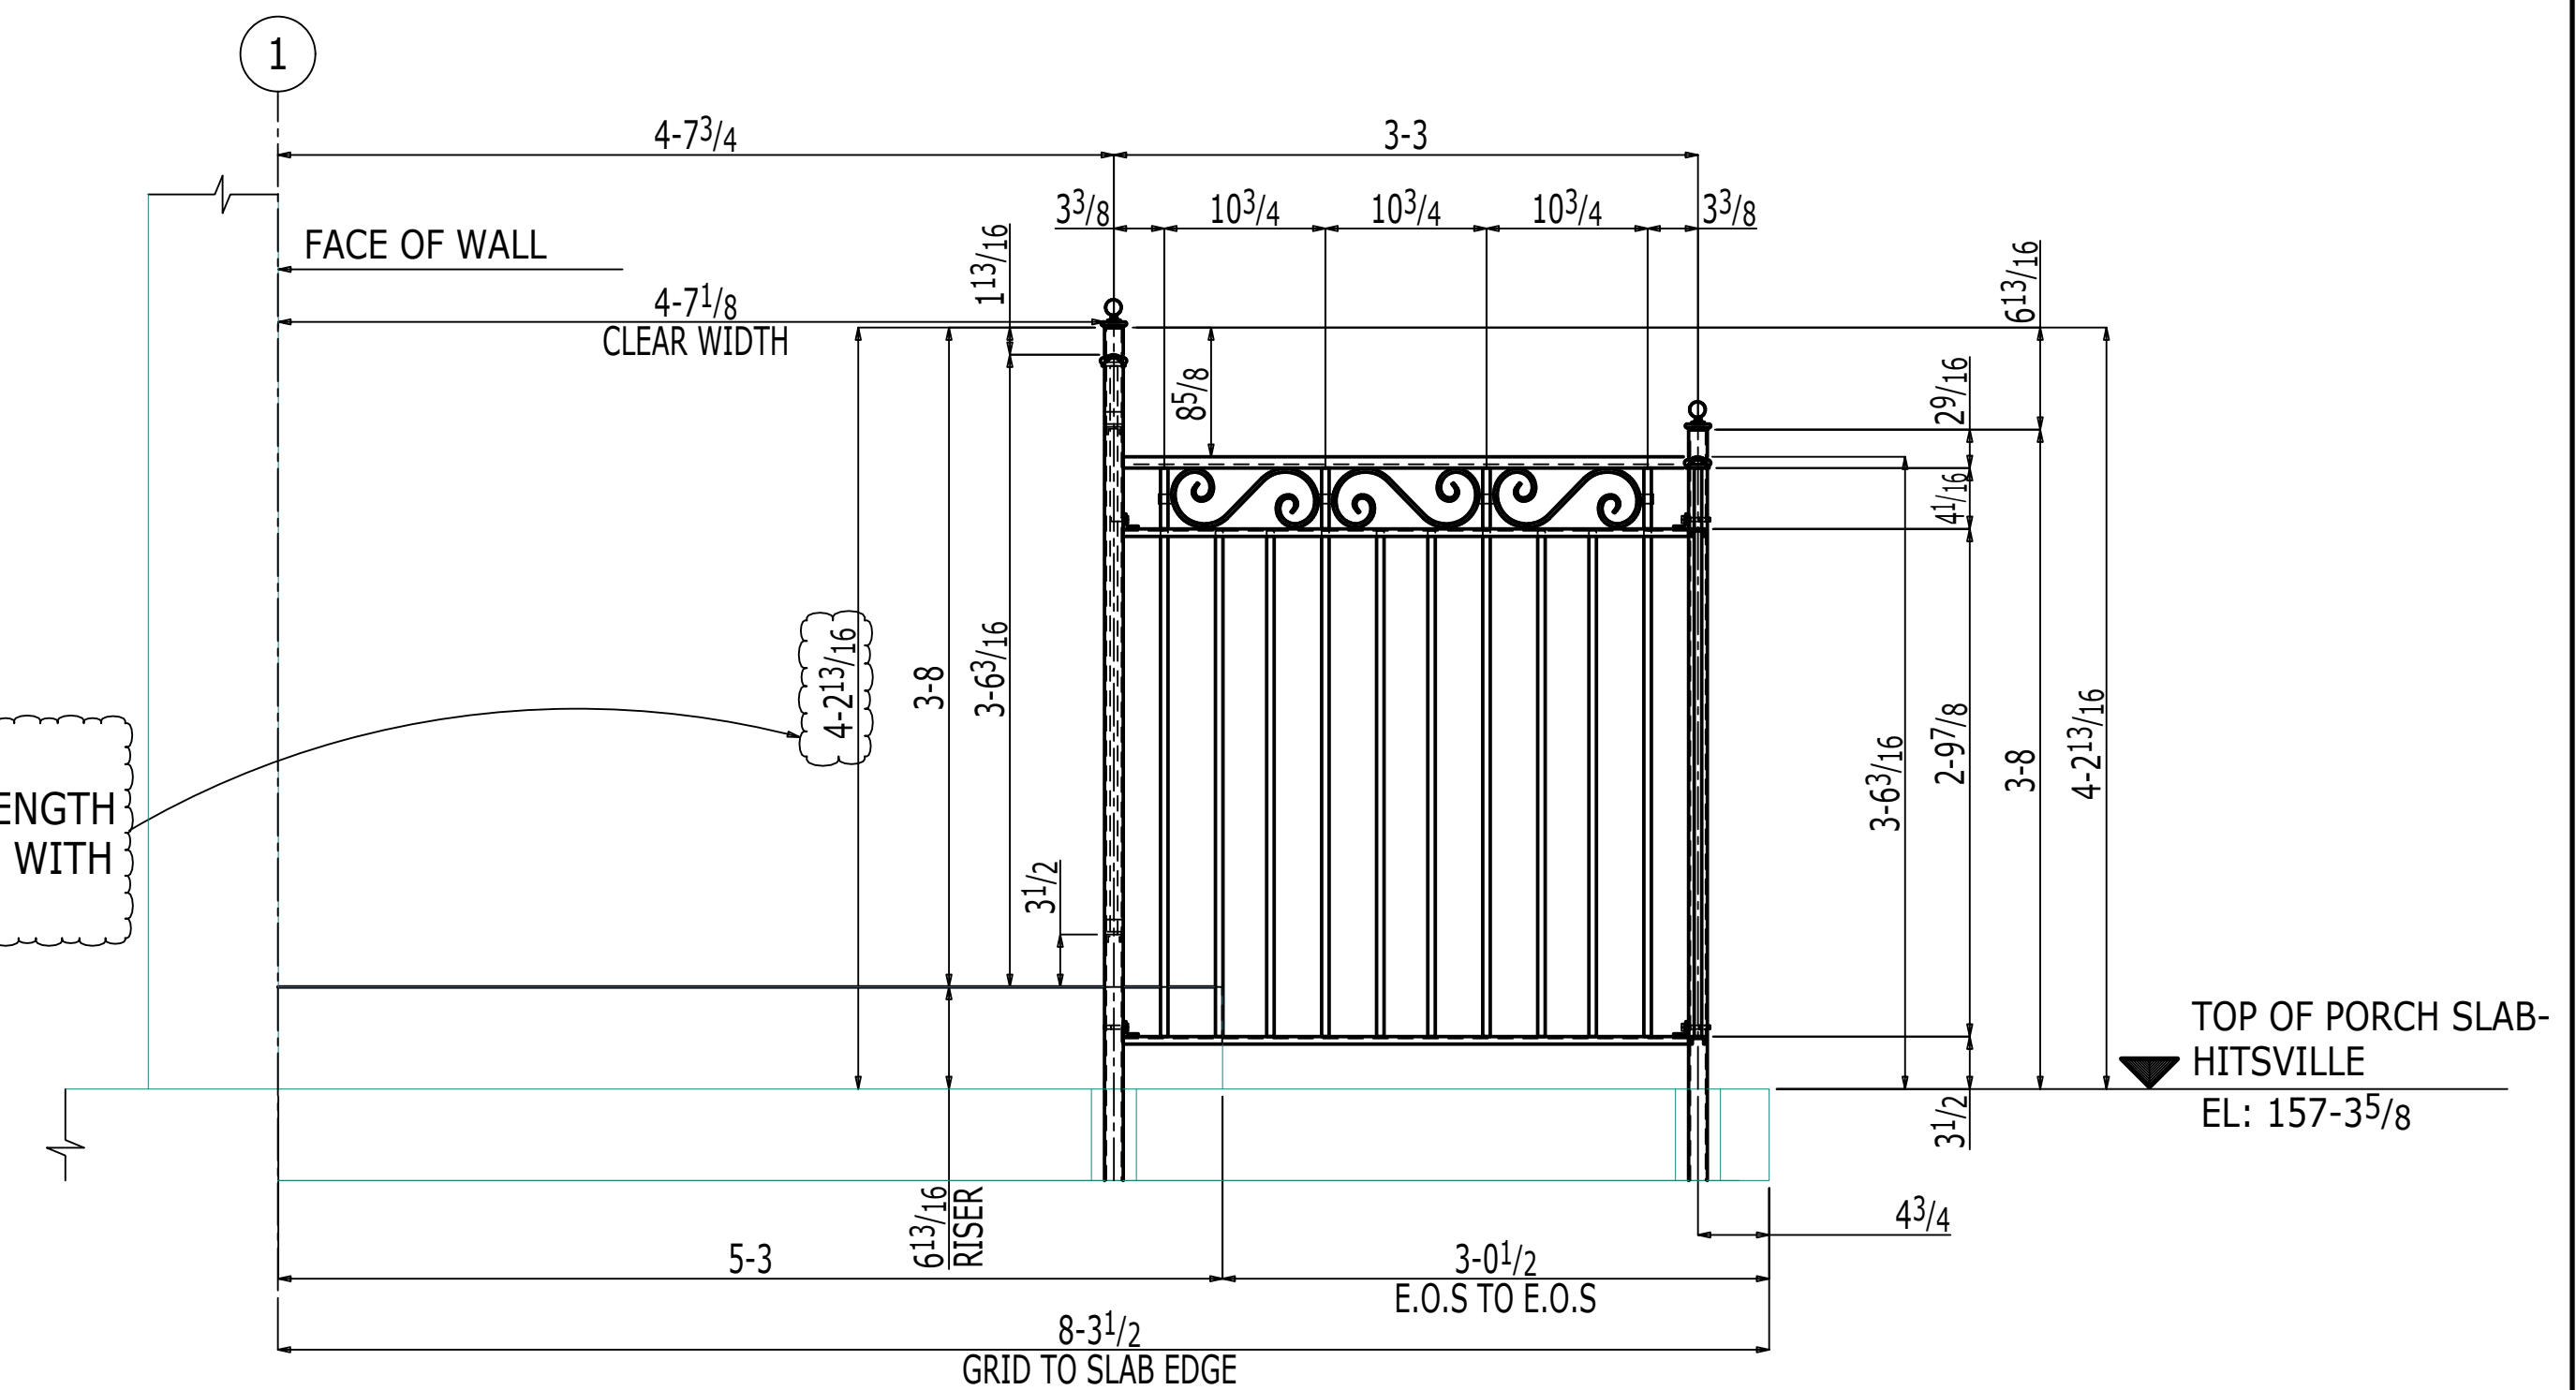

2 SECTION VIEW
E7

TYPICAL APPROVER NOTE:
CONFIRM/ELSE ADVISE ON ALL MATERIALS, DIMENSIONS, ELEVATIONS AND CONNECTION DETAILS. THINGS WHICH WERE NOT COMMENTED WHILE APPROVAL RETURNS, WILL BE CONSIDERED AS APPROVED, AS SHOWN.

NOT FOR CONSTRUCTION			
BY:		09-09-2022	REVISED AS MARKED
DATE:		07-06-2022	FOR RE-APPROVAL
		06-10-2022	FOR APPROVAL
			DESCRIPTION

DRAWING NOTES:
 ◆ ADD ADDITIONAL NOTES HERE (IF REQ'D)
 MATERIAL: STEEL A53, A500 & A36 U.N.O.
 HOLES: 13/16" U.N.O.
 ELECTRODES: PER AWS D1.1 U.N.O.
 WELD FINISH: NOMMA #3 U.N.O.
 REF-BRMG REF: A01.1, A1.1, A3.1, A3.2, A3.3, A4.1, ASG-2203144



FUTURE FABRICATING
 P: 586.755.7080 • F: 586.755.7456 • www.futurefabricating.com

DRAWING REVIEW / APPROVAL:
 THESE DRAWINGS REPRESENT FUTURE FABRICATING'S INTERPRETATION OF THE INTENT OF THE CONTRACT DOCUMENTS. EVERY EFFORT HAS BEEN MADE TO ENSURE THAT THEY ARE ACCURATE AND COMPLETE. APPROVAL BY THE AUTHORIZED PARTIES SHALL CONSTITUTE ACCEPTANCE AND ANY POST APPROVAL CHANGES WILL BE CONSIDERED TO BE CHANGES TO FUTURE FABRICATING'S CONTRACT.

DRAWN BY:	CHECKED BY:	FIELD MEASURED:
MSK	ARS	
DATE:	DATE:	DATE:
06-03-2022	06-03-2022	
JOB NUMBER:	REV:	
22-2089		








PROJECT NAME: MOTOWN MUSEUM EXPANSION-PHASE 2
 CUSTOMER: L.S.BRINKER

SHEET NUMBER: E7

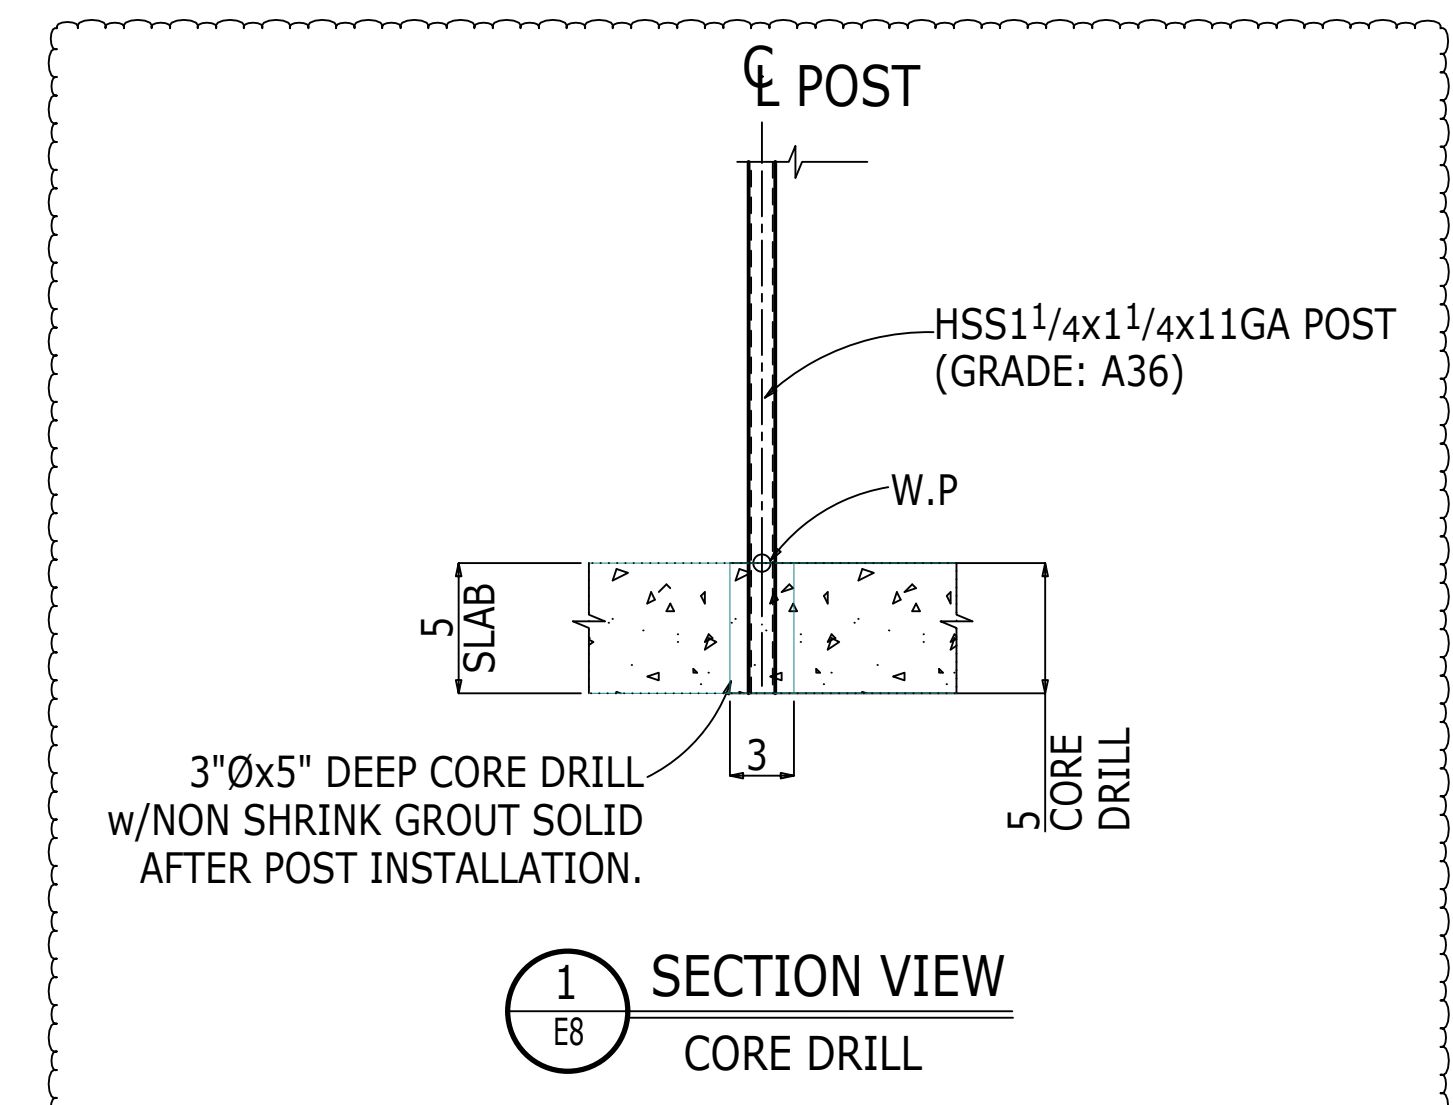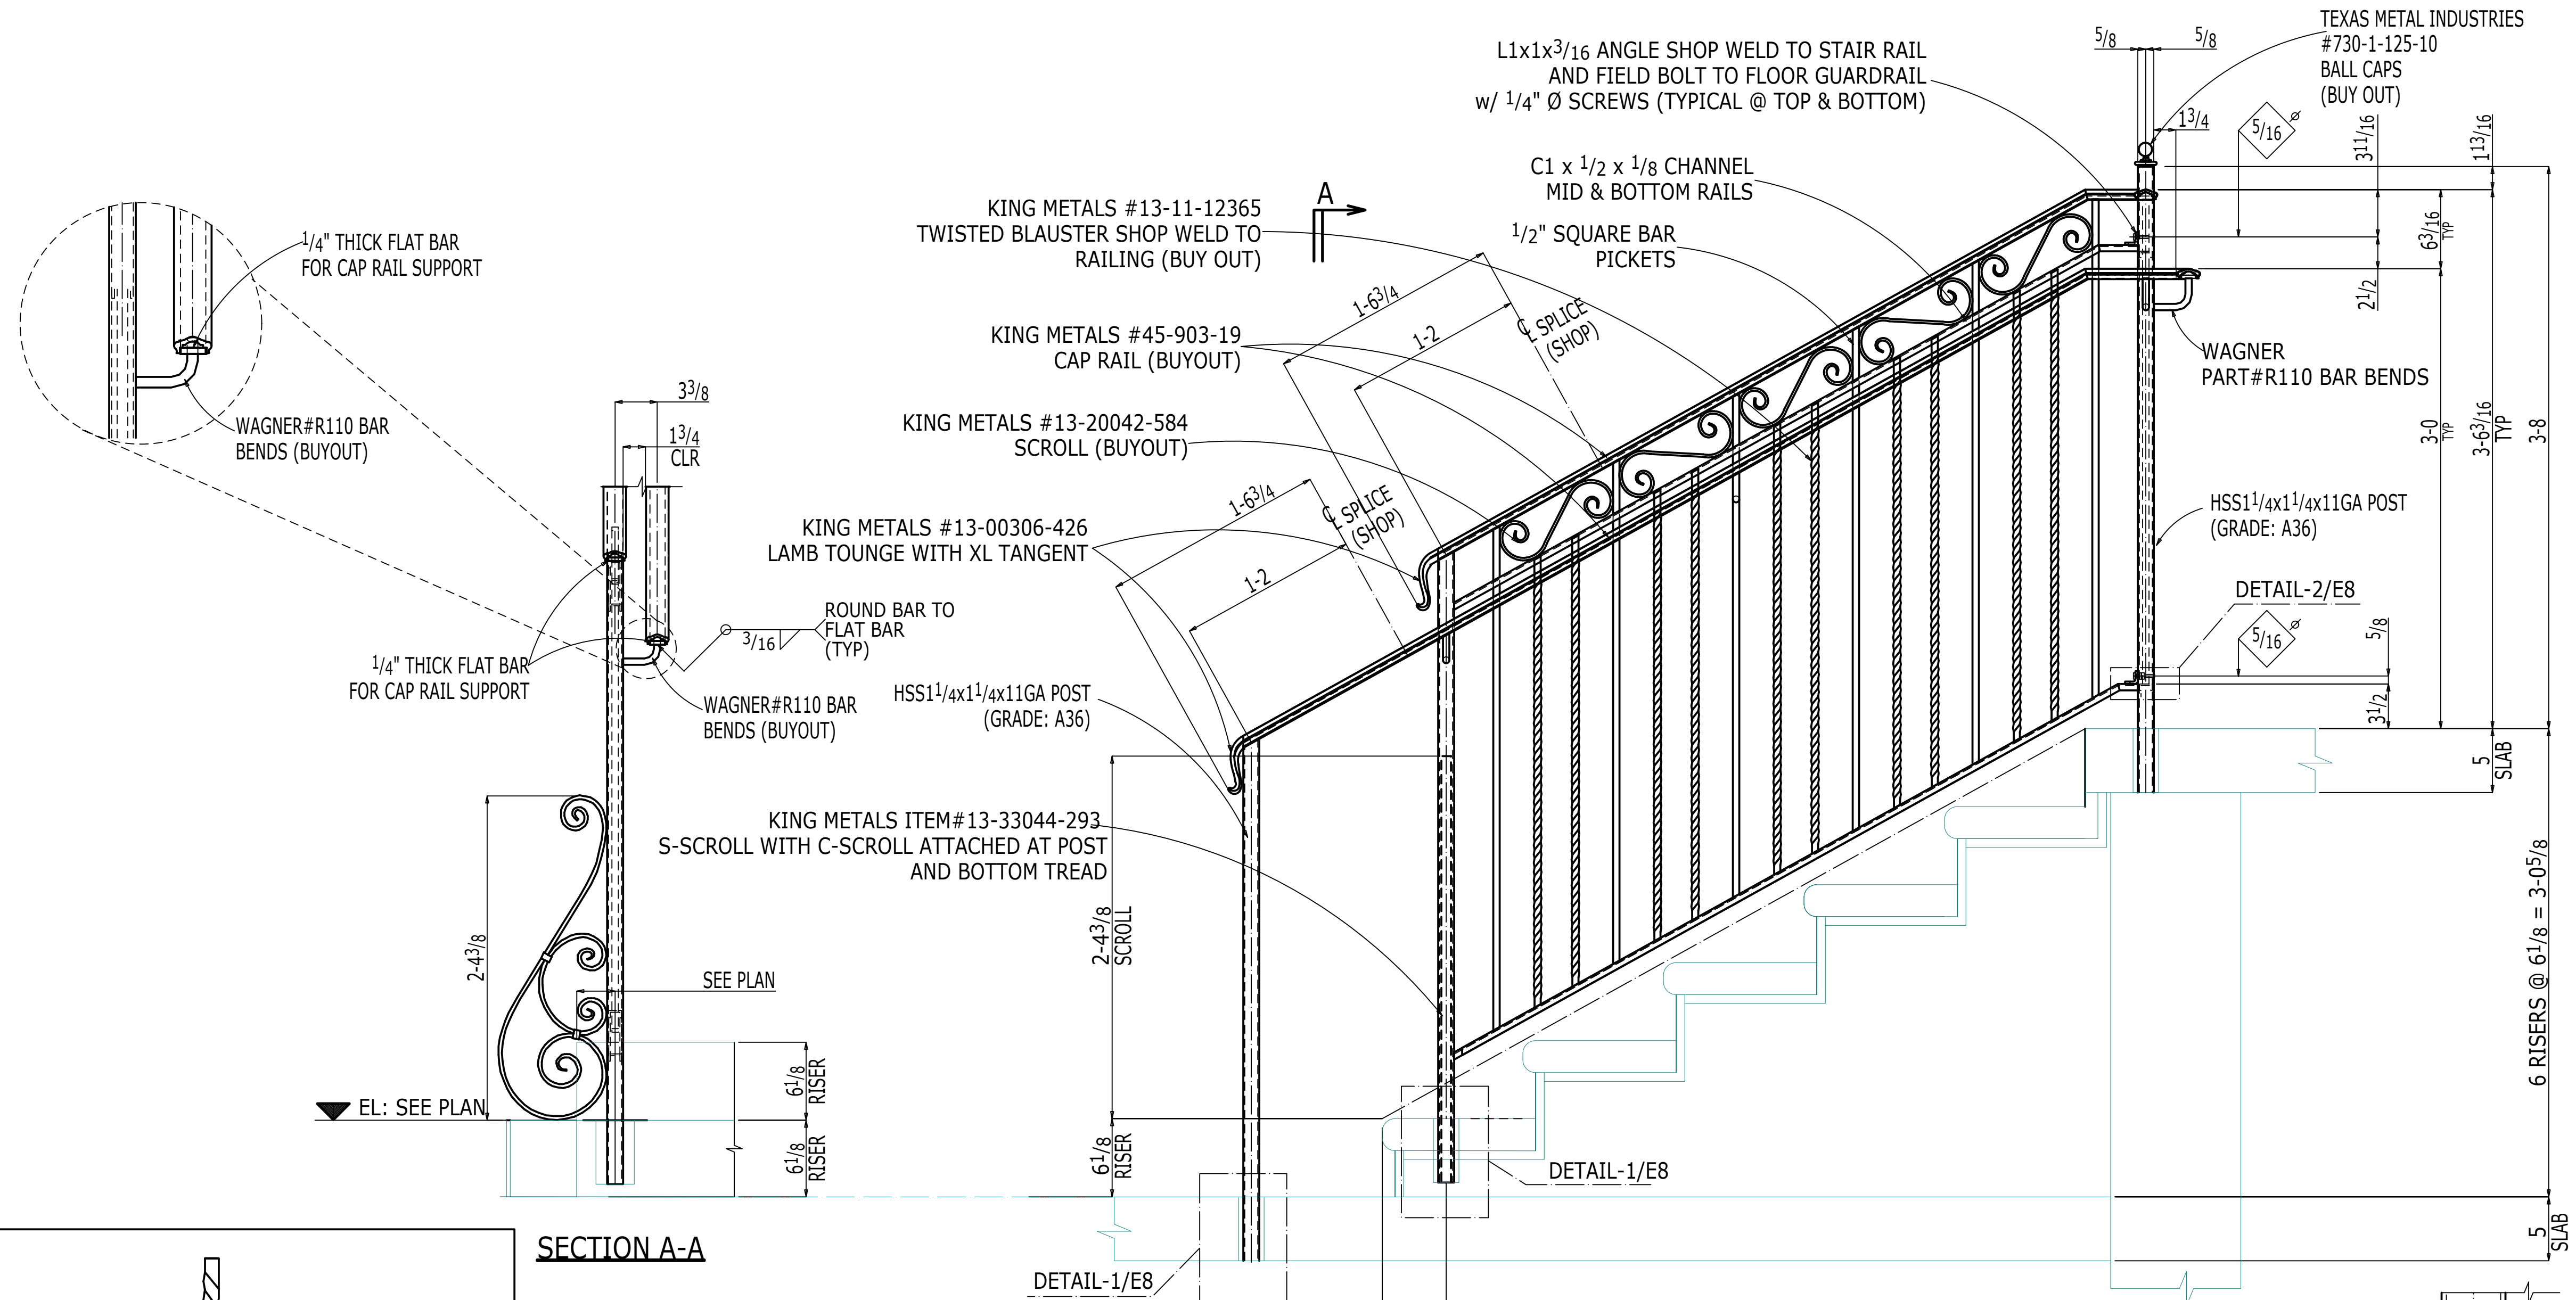

TYPICAL APPROVER NOTE:
 CONFIRM/ELSE ADVISE ON ALL MATERIALS, DIMENSIONS, ELEVATIONS AND CONNECTION DETAILS. THINGS WHICH WERE NOT COMMENTED WHILE APPROVAL RETURNS, WILL BE CONSIDERED AS APPROVED, AS SHOWN.

TYPICAL RAILING DETAIL @ STAIR
 (REF DWG: ASK-220314A & SEC:6/A1.1)

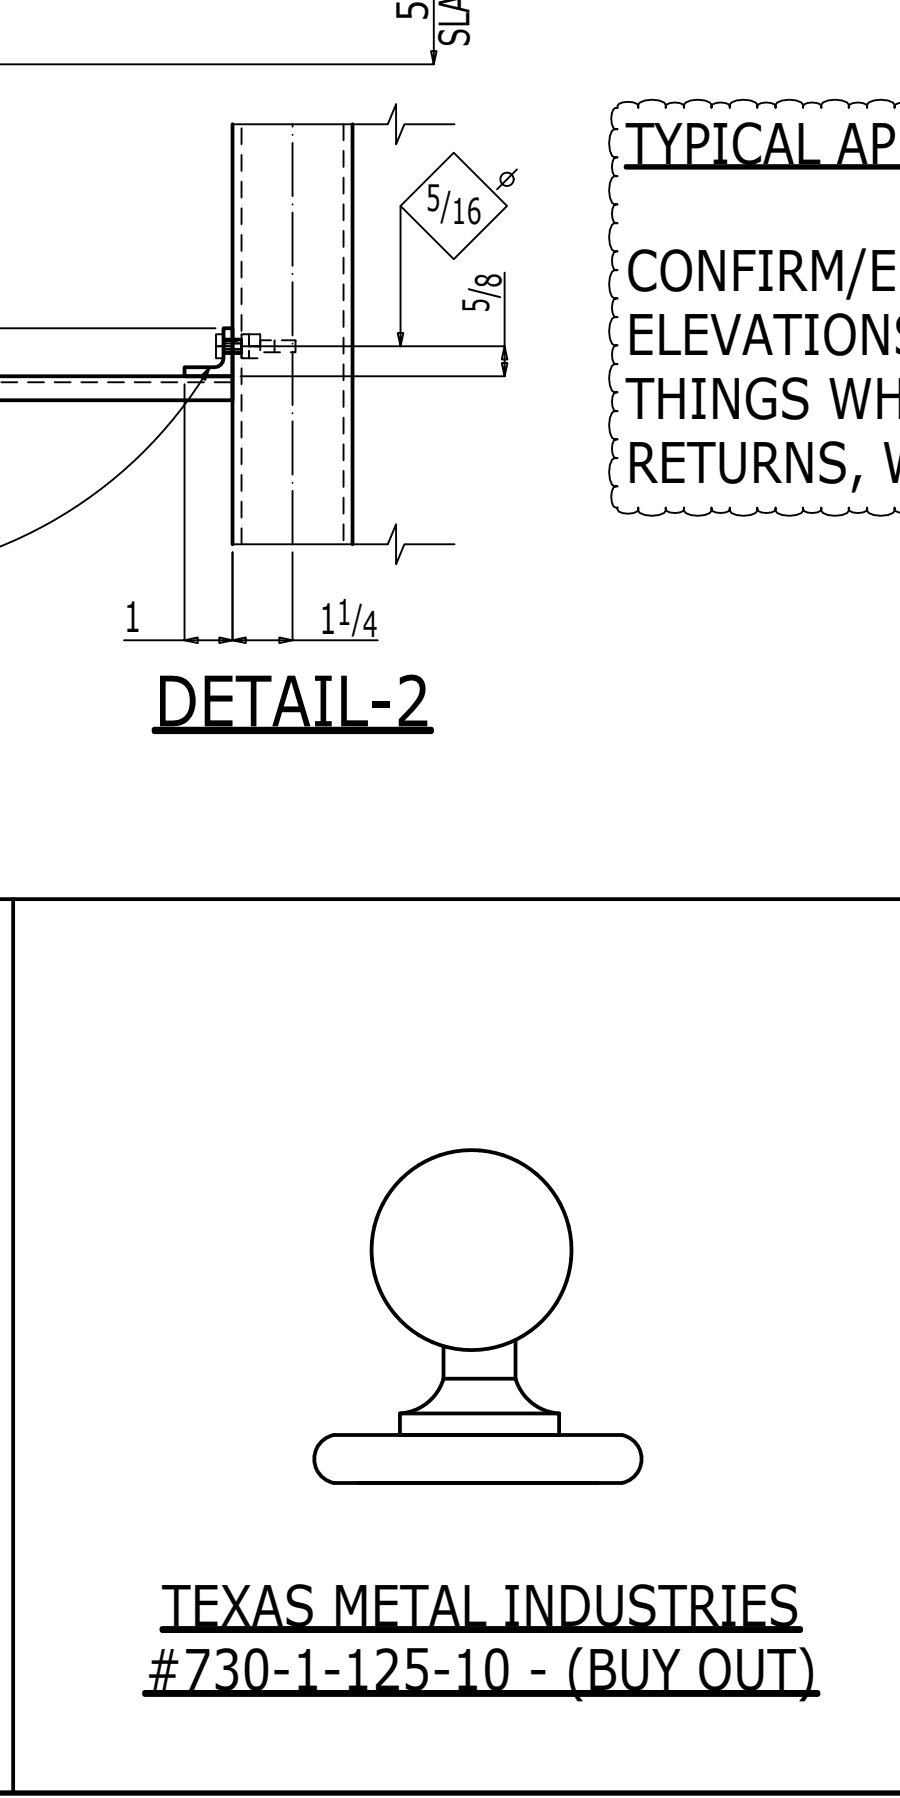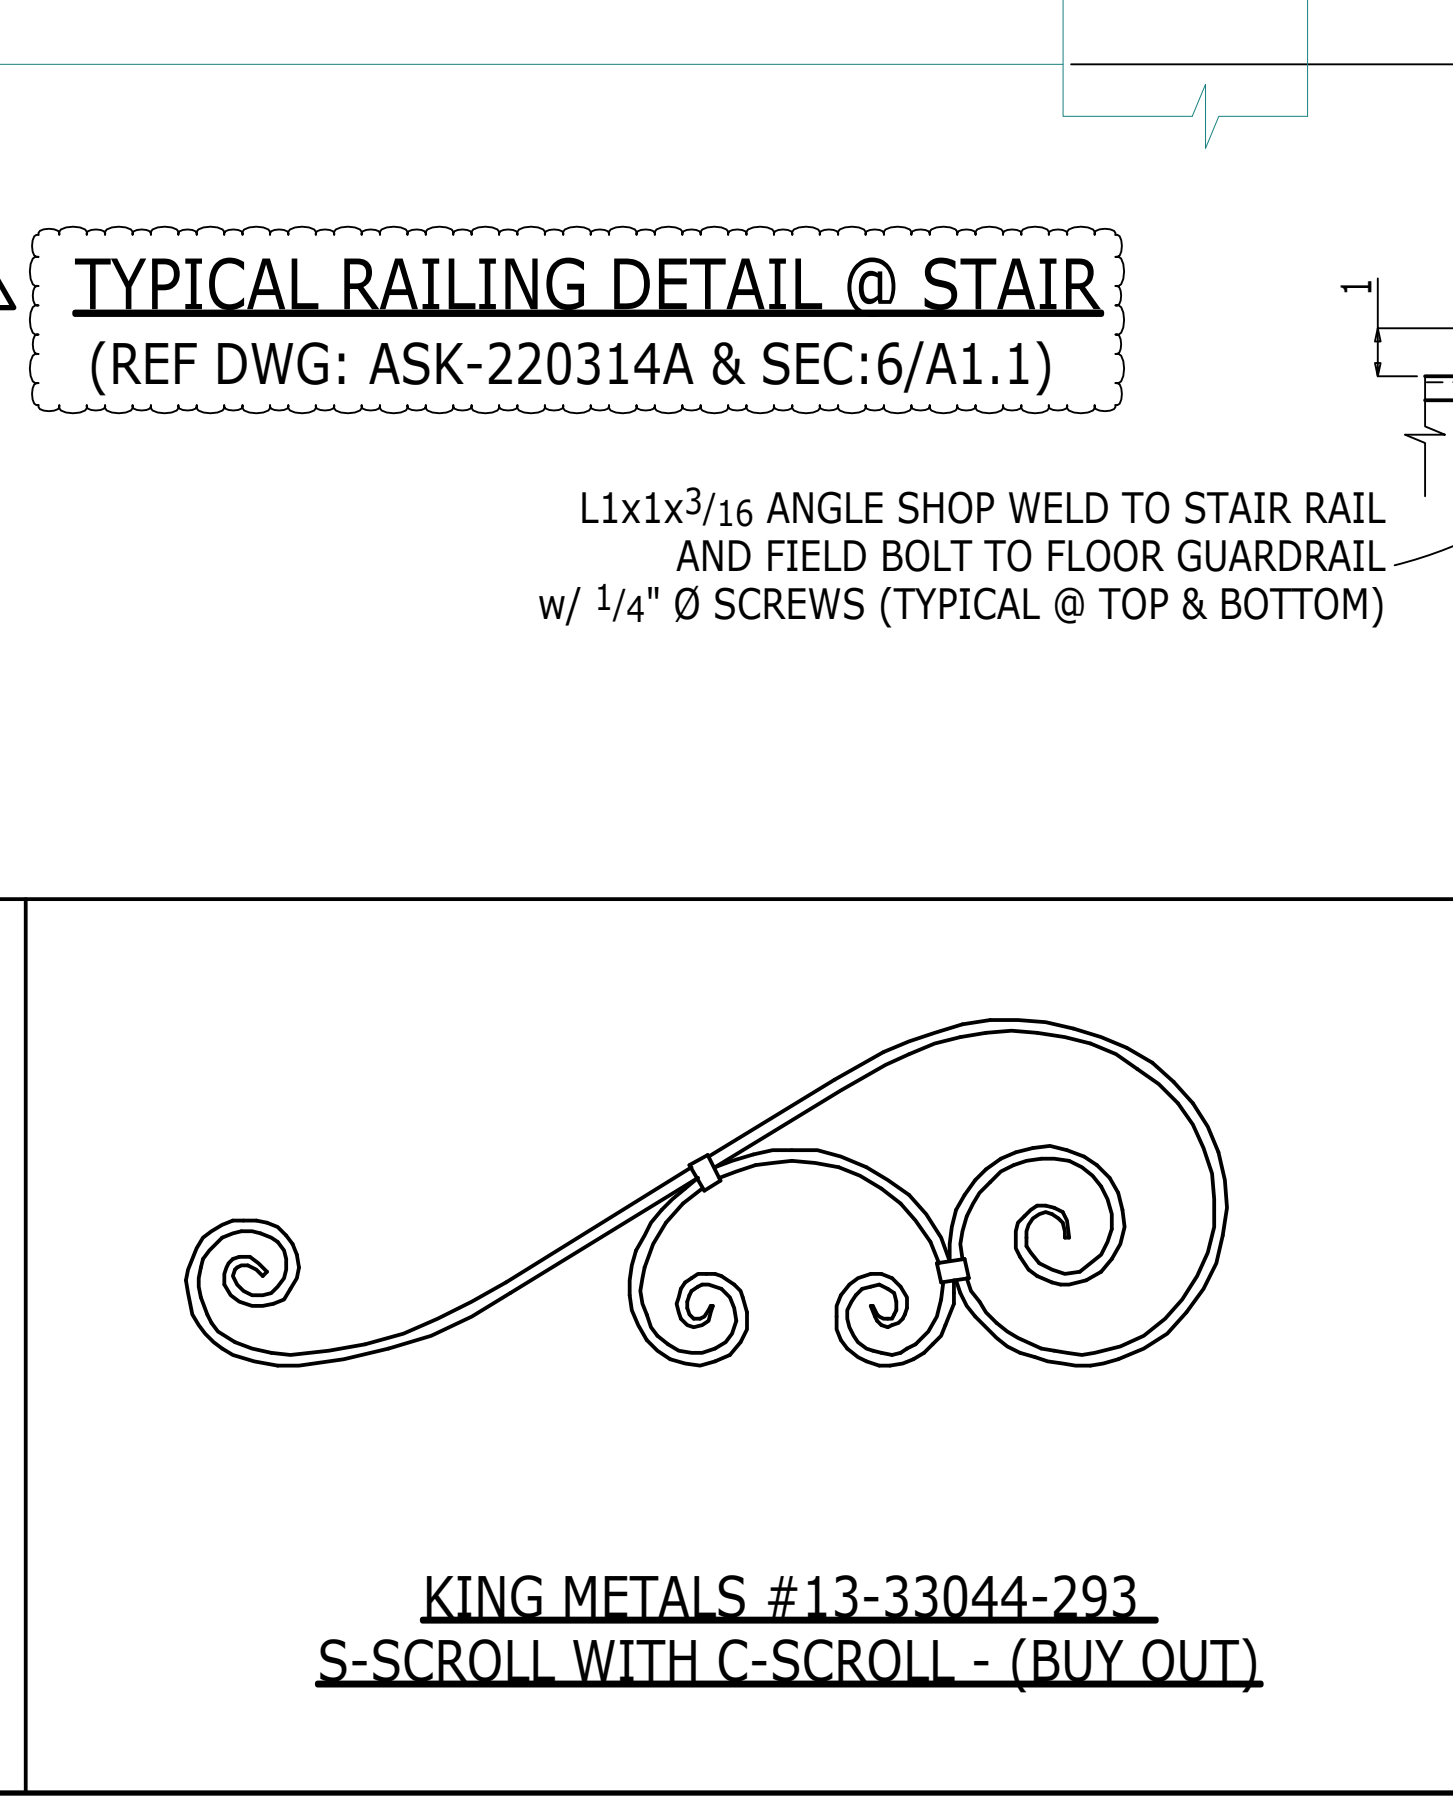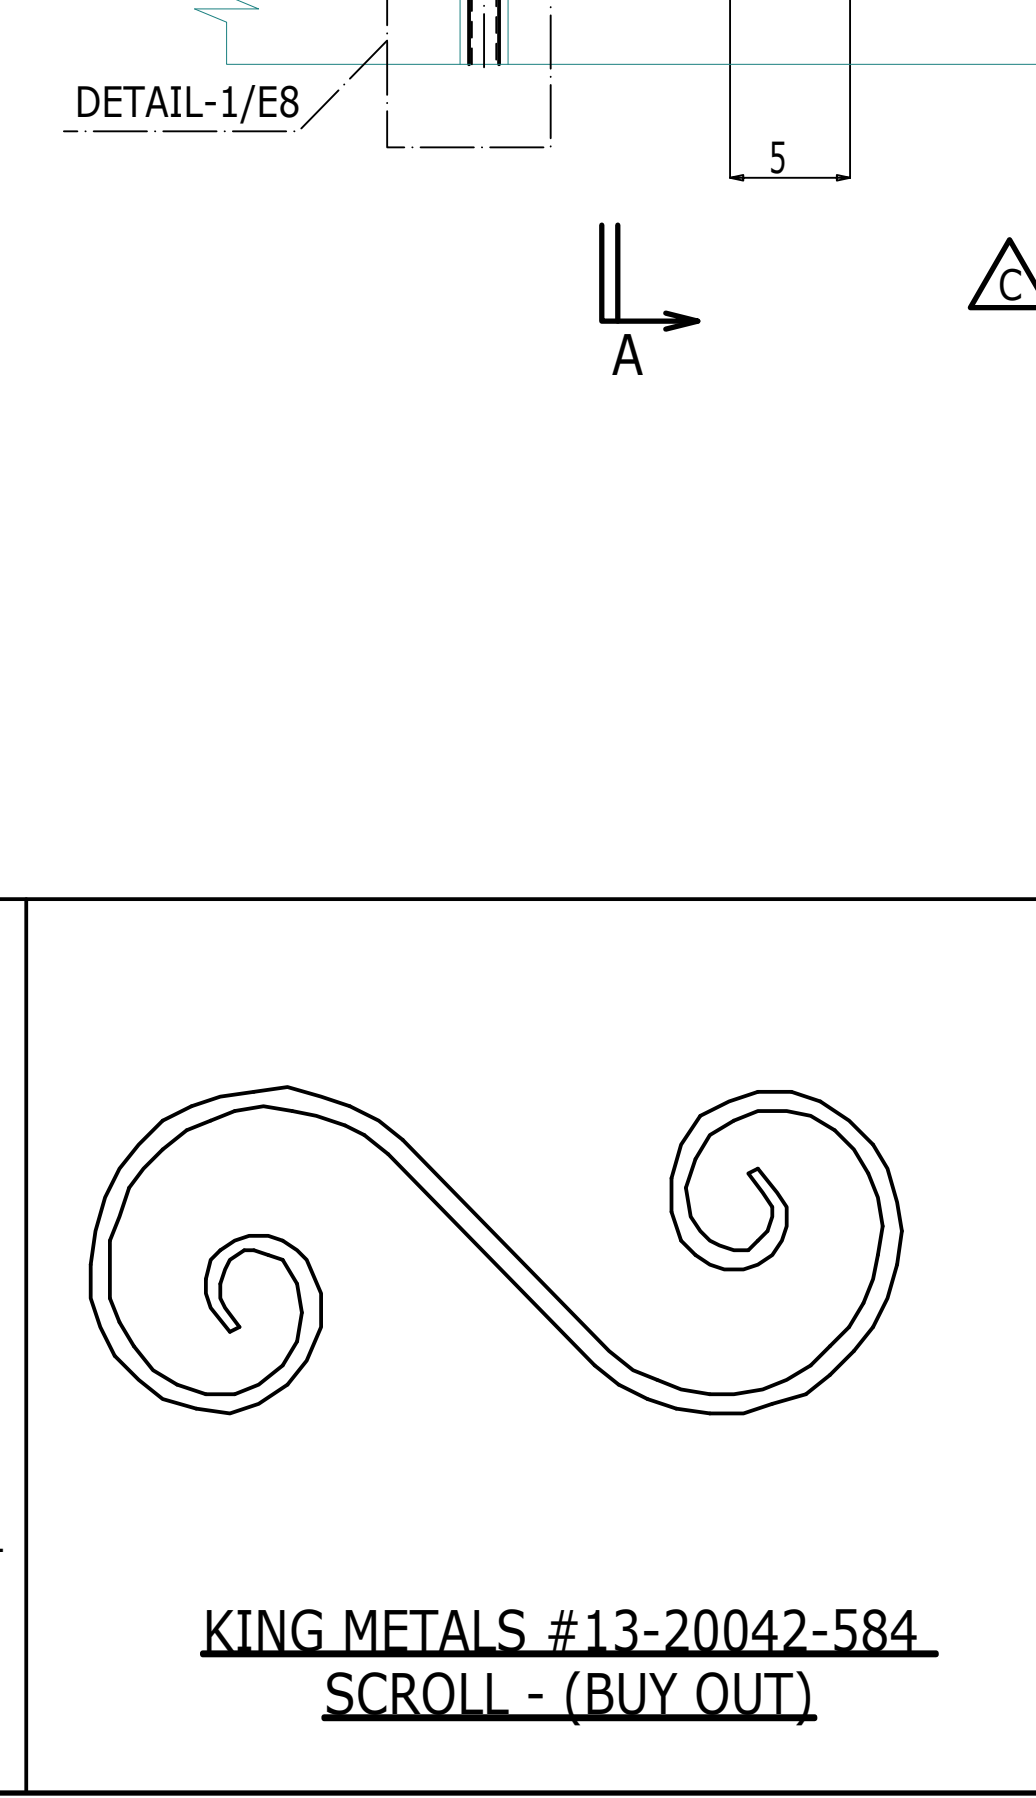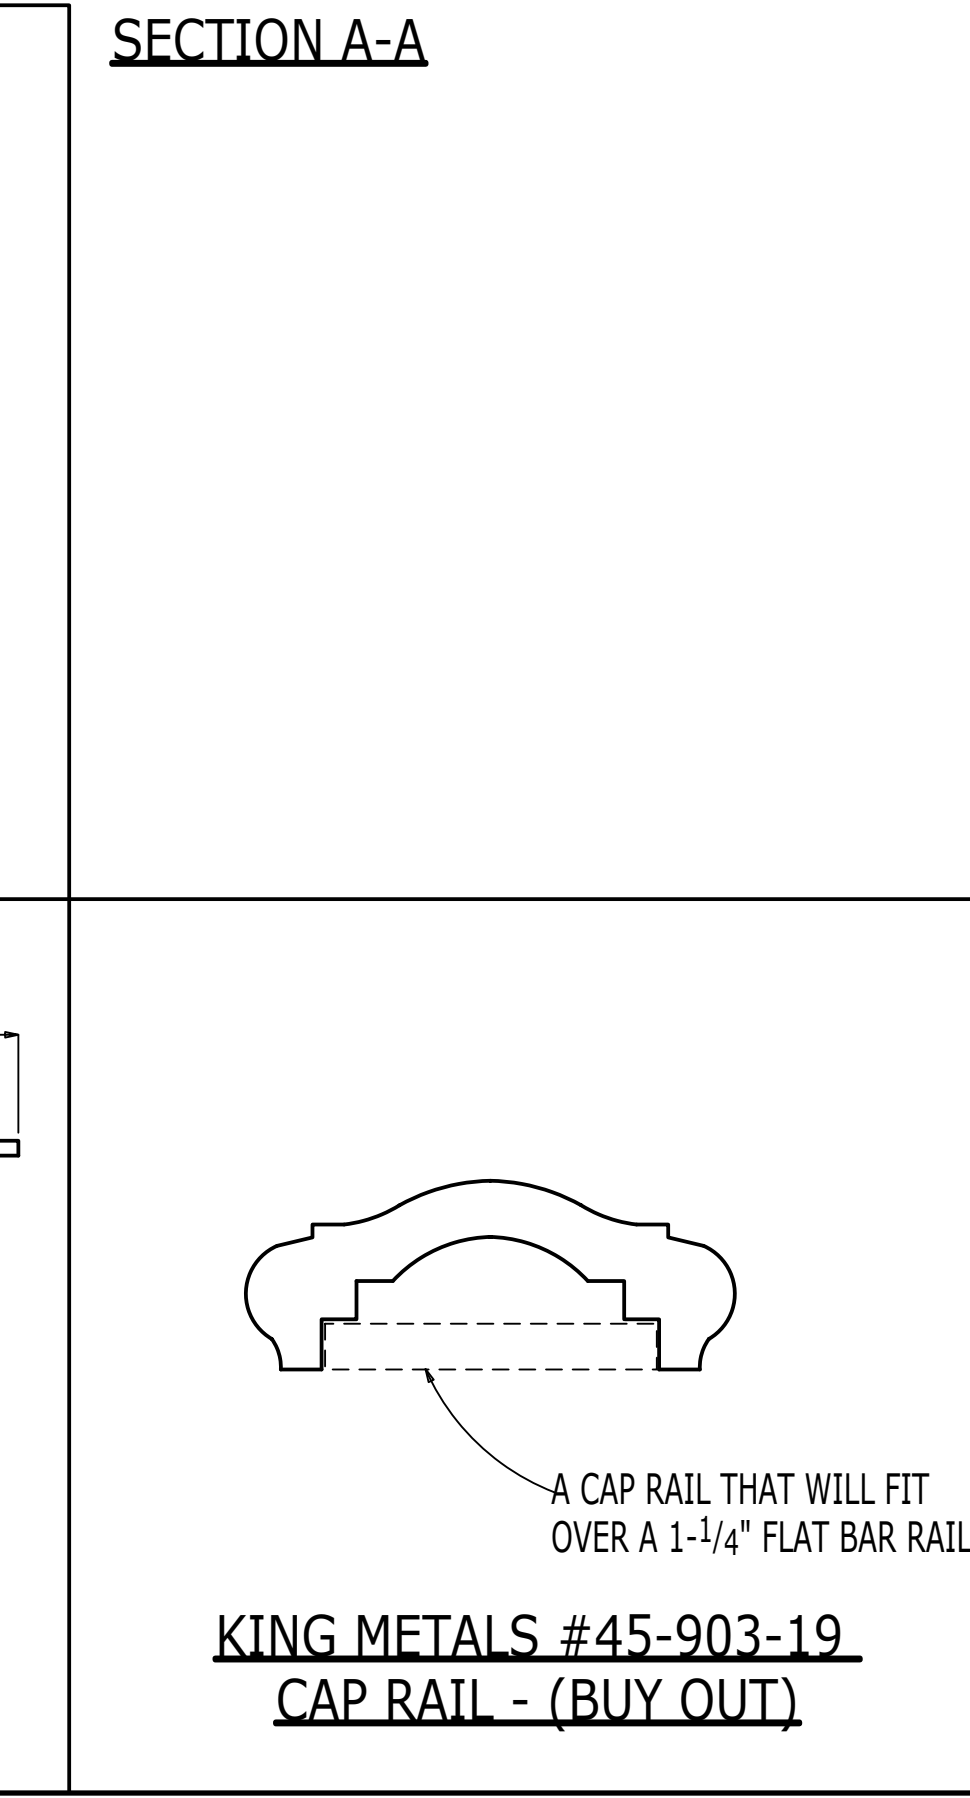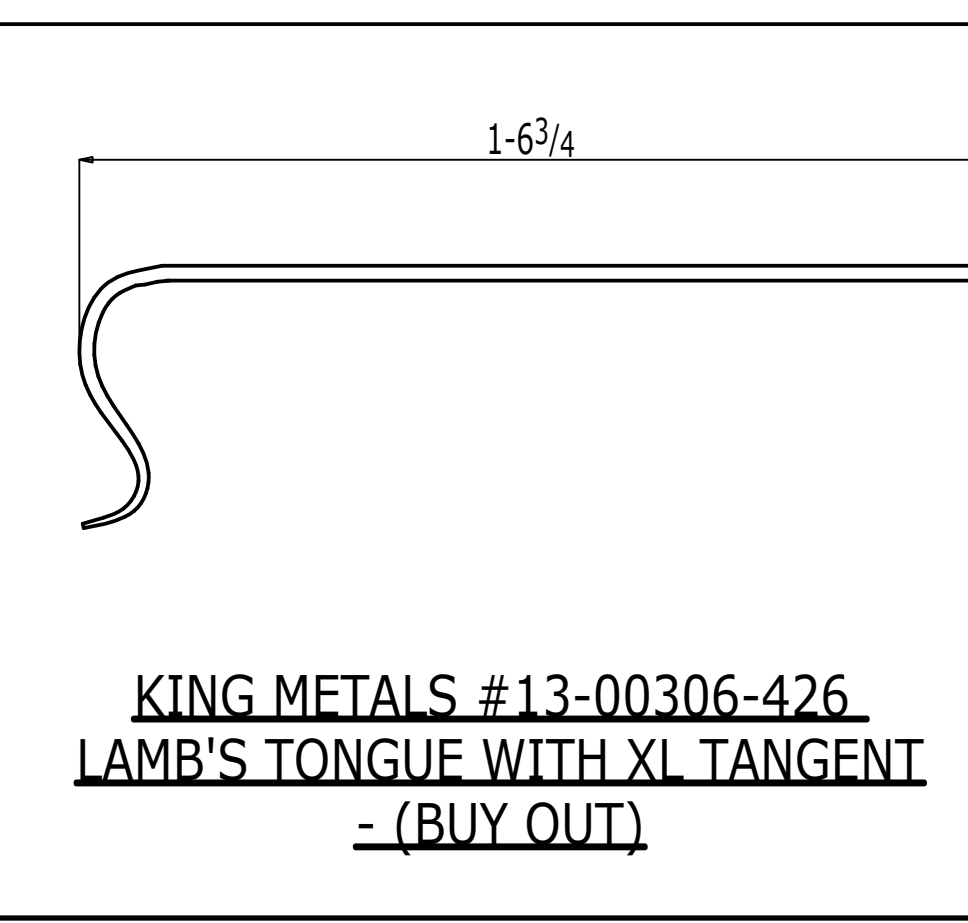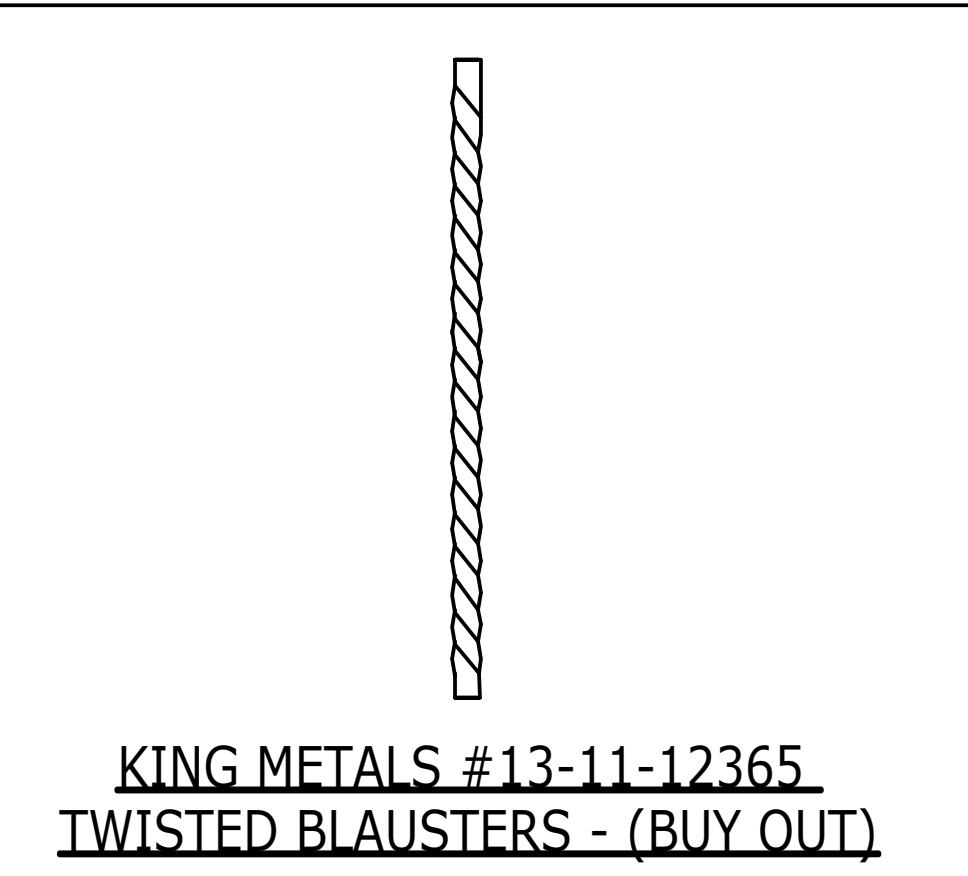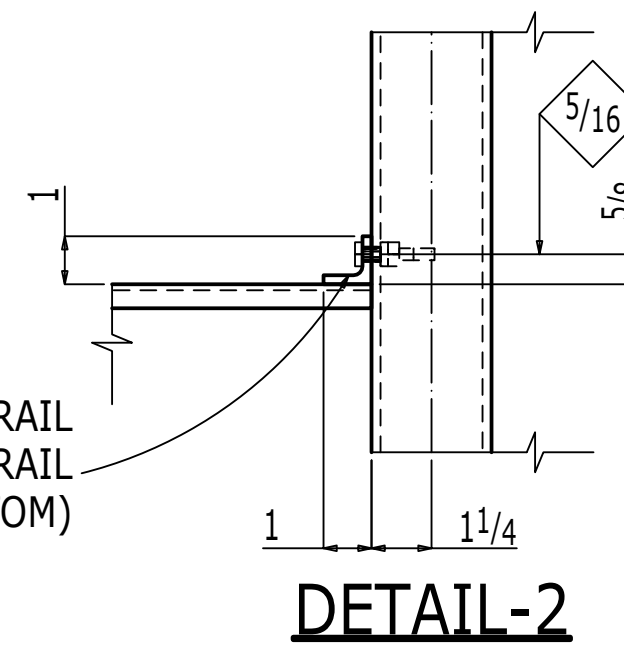

NOT FOR CONSTRUCTION

BY:	DATE:	REVISION	DESCRIPTION
		09-09-2022	REVISED AS MARKED
		07-06-2022	FOR RE-APPROVAL
		06-10-2022	FOR APPROVAL

DRAWING NOTES:
 ♦ ADD ADDITIONAL NOTES HERE (IF REQ'D)

MATERIAL: STEEL A53, A500 & A36 U.N.B.
 HOLES: 13/16" U.N.B.
 ELECTRODES: PER AWS D1.1 U.N.B.
 WELD FINISH: NOMMA #3 U.N.B.
 REF-DWG REF: AFD.1, A3.1, A3.2, A3.3, A4.1, ASG-220314A

FUTURE FABRICATING
 P: 586.755.7080 • F: 586.755.7456 • www.futurefabricating.com


DRAWING REVIEW / APPROVAL:
 THESE DRAWINGS REPRESENT FUTURE FABRICATING'S INTERPRETATION OF THE INTENT OF THE CONTRACT DOCUMENTS. EVERY EFFORT HAS BEEN MADE TO ENSURE THAT THEY ARE ACCURATE AND COMPLETE. APPROVAL BY THE AUTHORIZED PARTIES SHALL CONSTITUTE ACCEPTANCE AND ANY POST APPROVAL CHANGES WILL BE CONSIDERED TO BE CHANGES TO FUTURE FABRICATING'S CONTRACT.

DRAWN BY:	CHECKED BY:	FIELD MEASURED:
MSK	ARS	
DATE:	DATE:	DATE:
06-03-2022	06-03-2022	

JOB NUMBER: 22-2089
 SHEET NUMBER: E8


HANDRAILS AT NEW PRECAST STAIR - DETAILS
 PROJECT NAME: MOTOWN MUSEUM EXPANSION-PHASE 2
 CUSTOMER: L.S.BRINKER

TYPICAL APPROVER NOTE:
 CONFIRM/ELSE ADVISE ON ALL MATERIALS, DIMENSIONS, ELEVATIONS AND CONNECTION DETAILS. THINGS WHICH WERE NOT COMMENTED WHILE APPROVAL RETURNS, WILL BE CONSIDERED AS APPROVED, AS SHOWN.






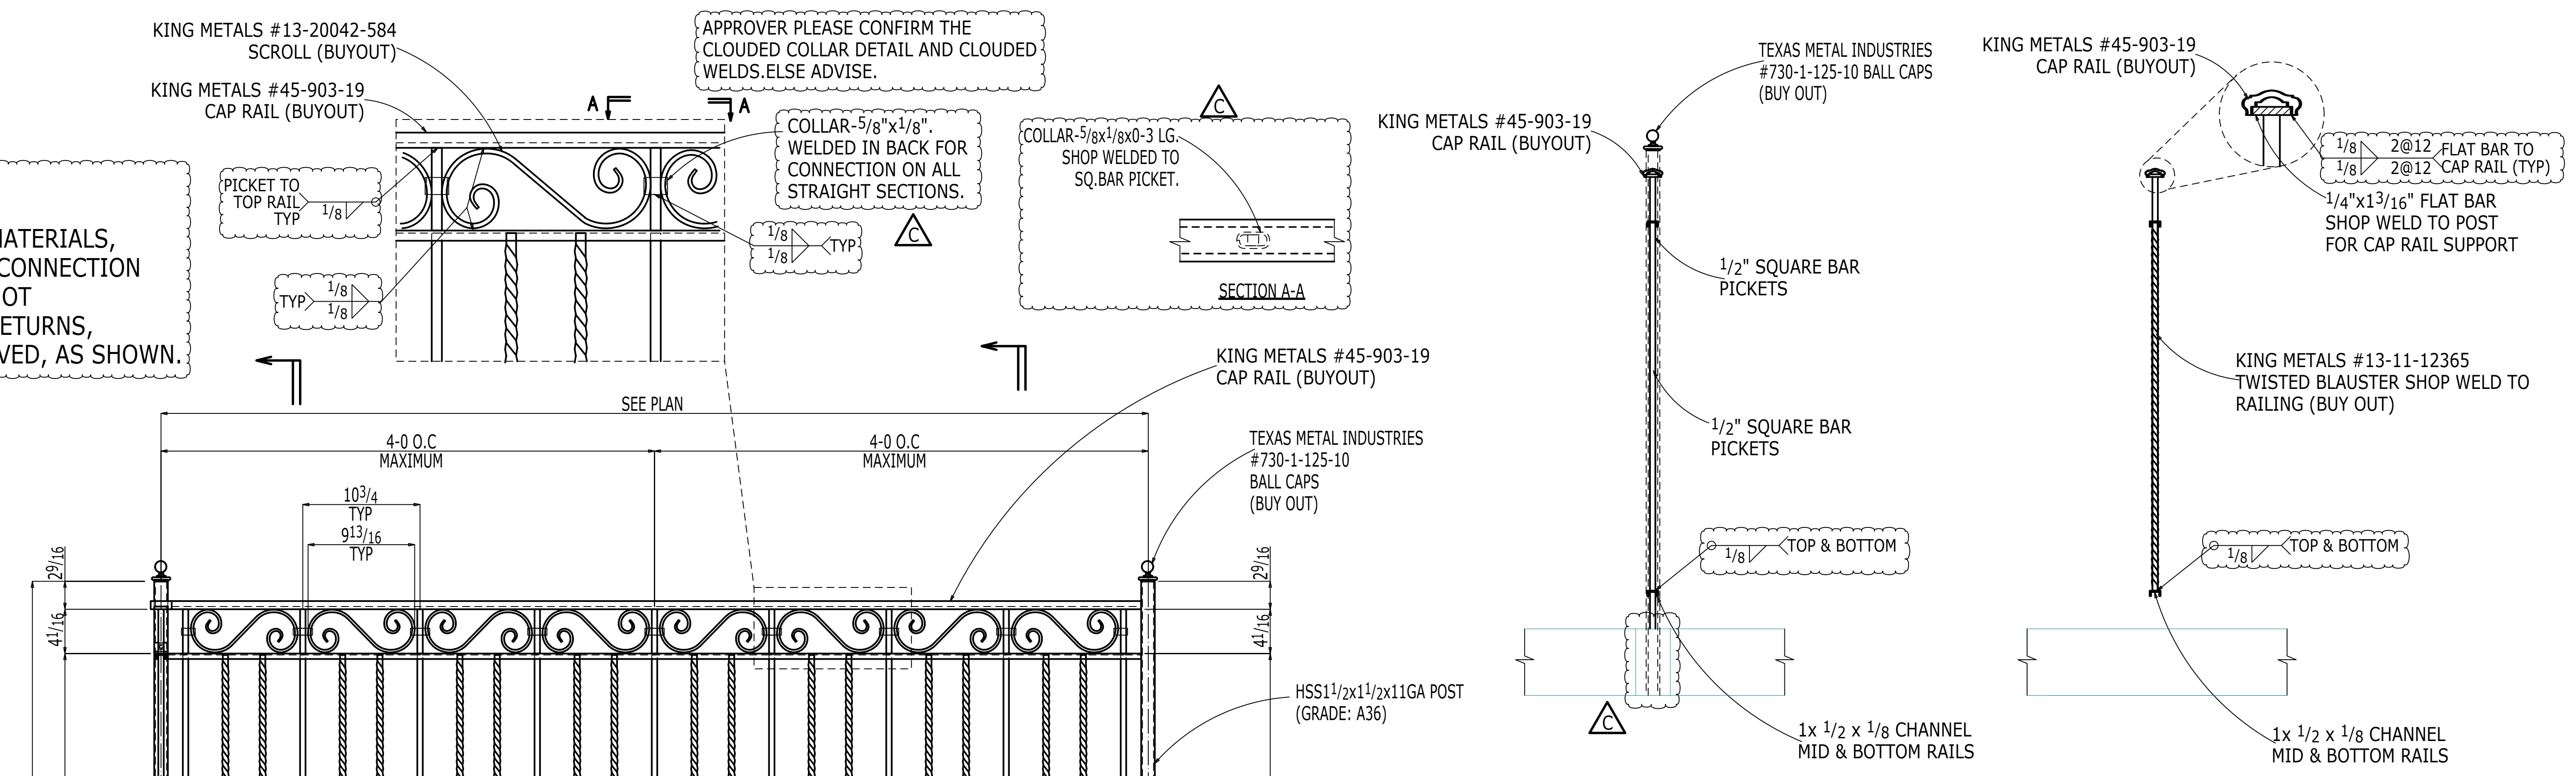


TYPICAL RAILING DETAIL @ SQUARE PICKET

TYPICAL RAILING DETAIL @ TWISTED BALUSTER

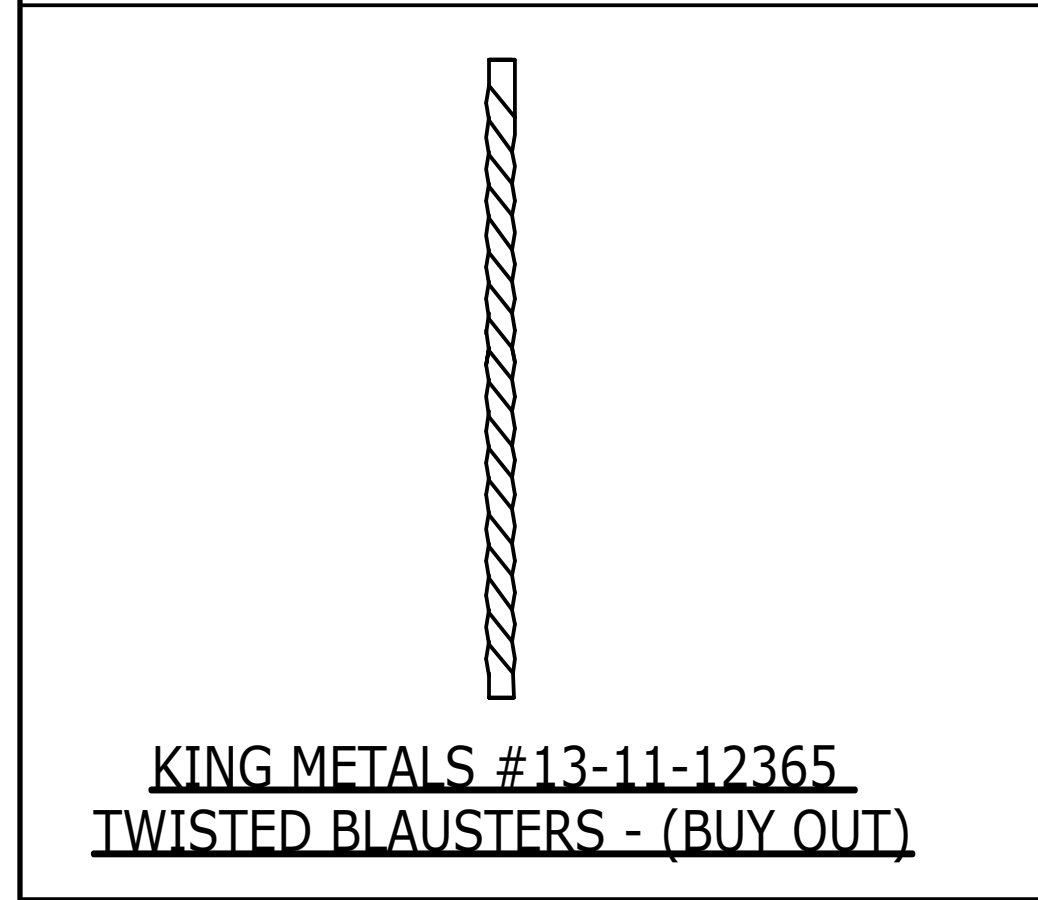

TYPICAL RAILING DETAIL @ GUARDRAIL
 (REF DWG: ASK-220314A & SEC:6/A1.1)

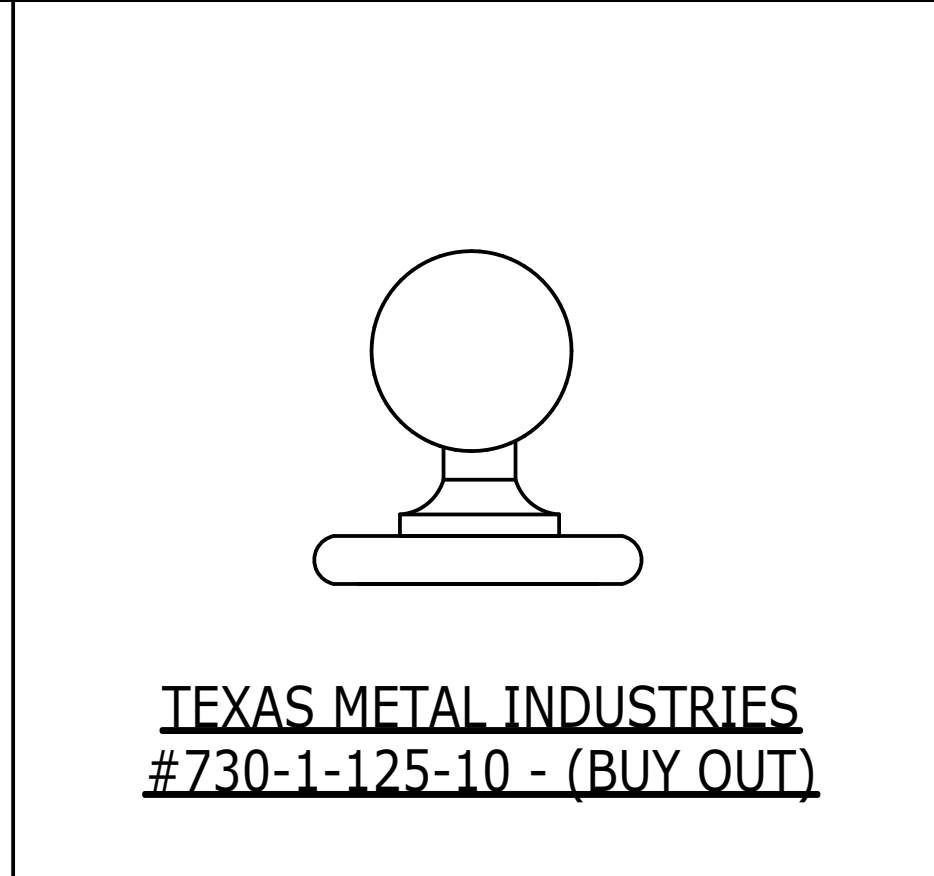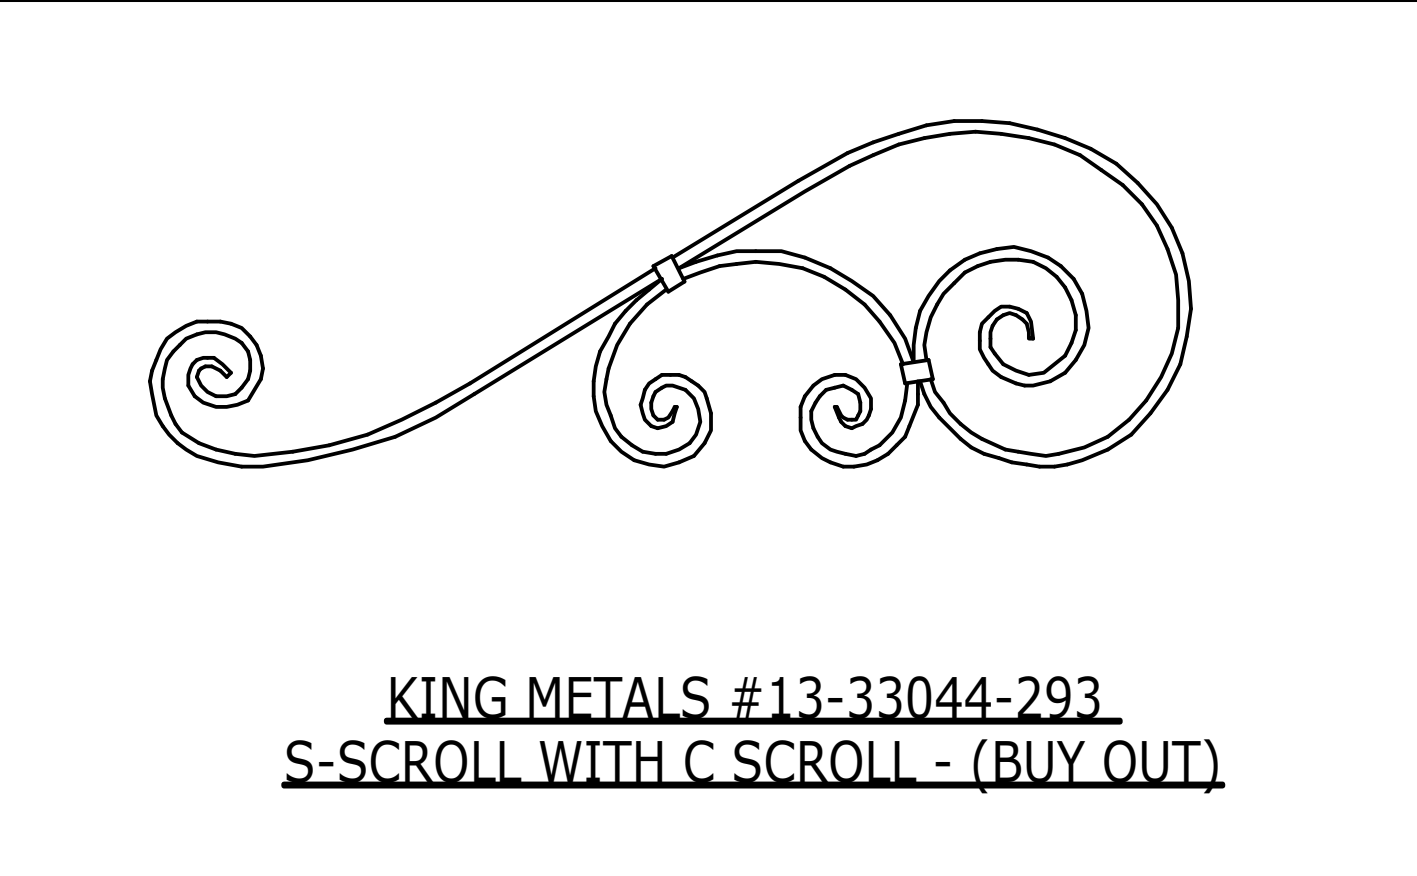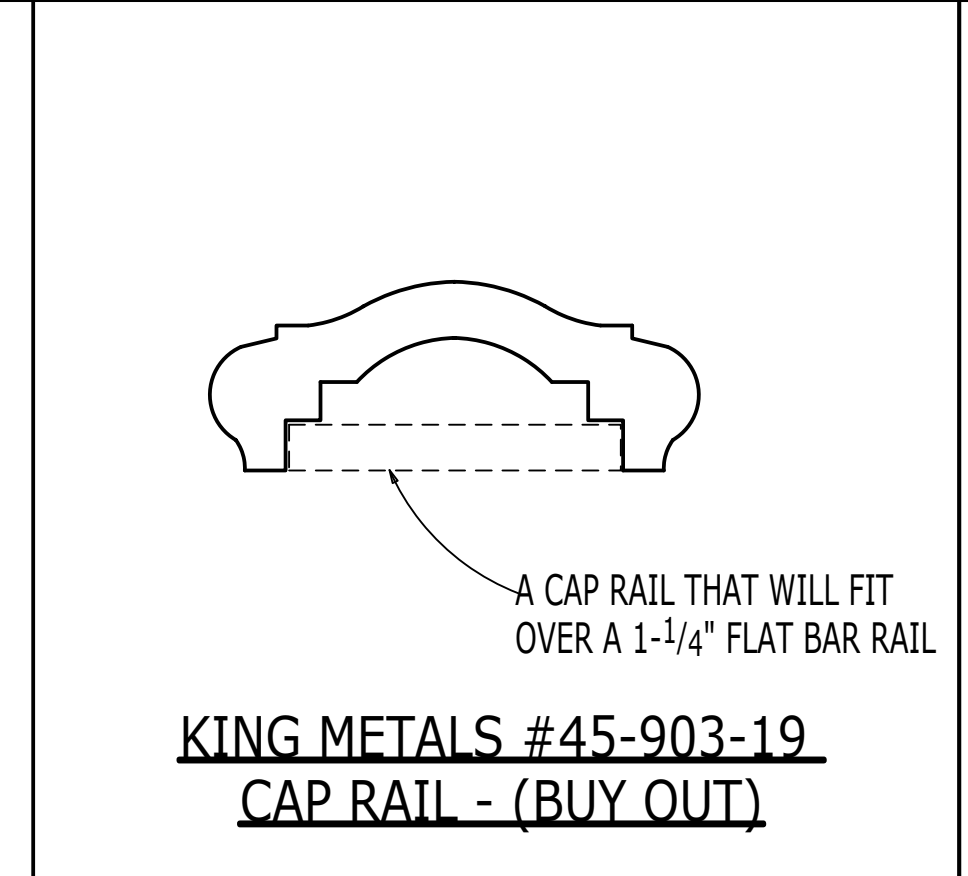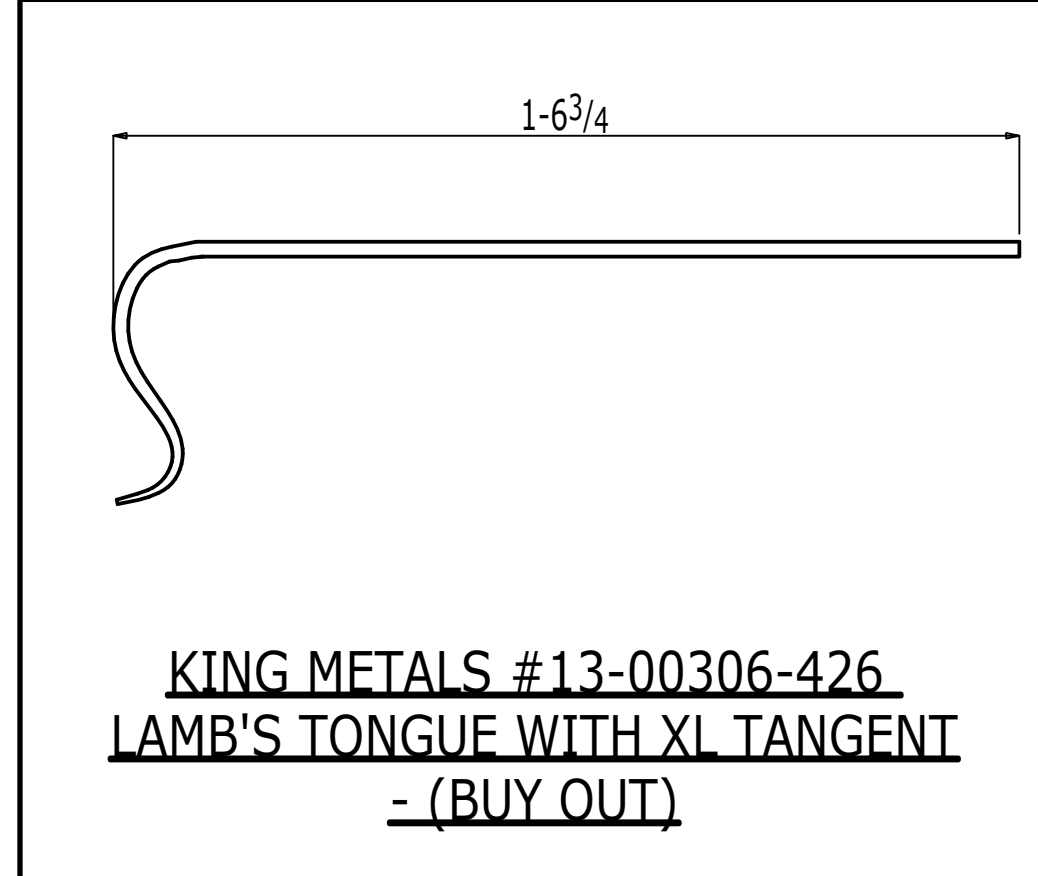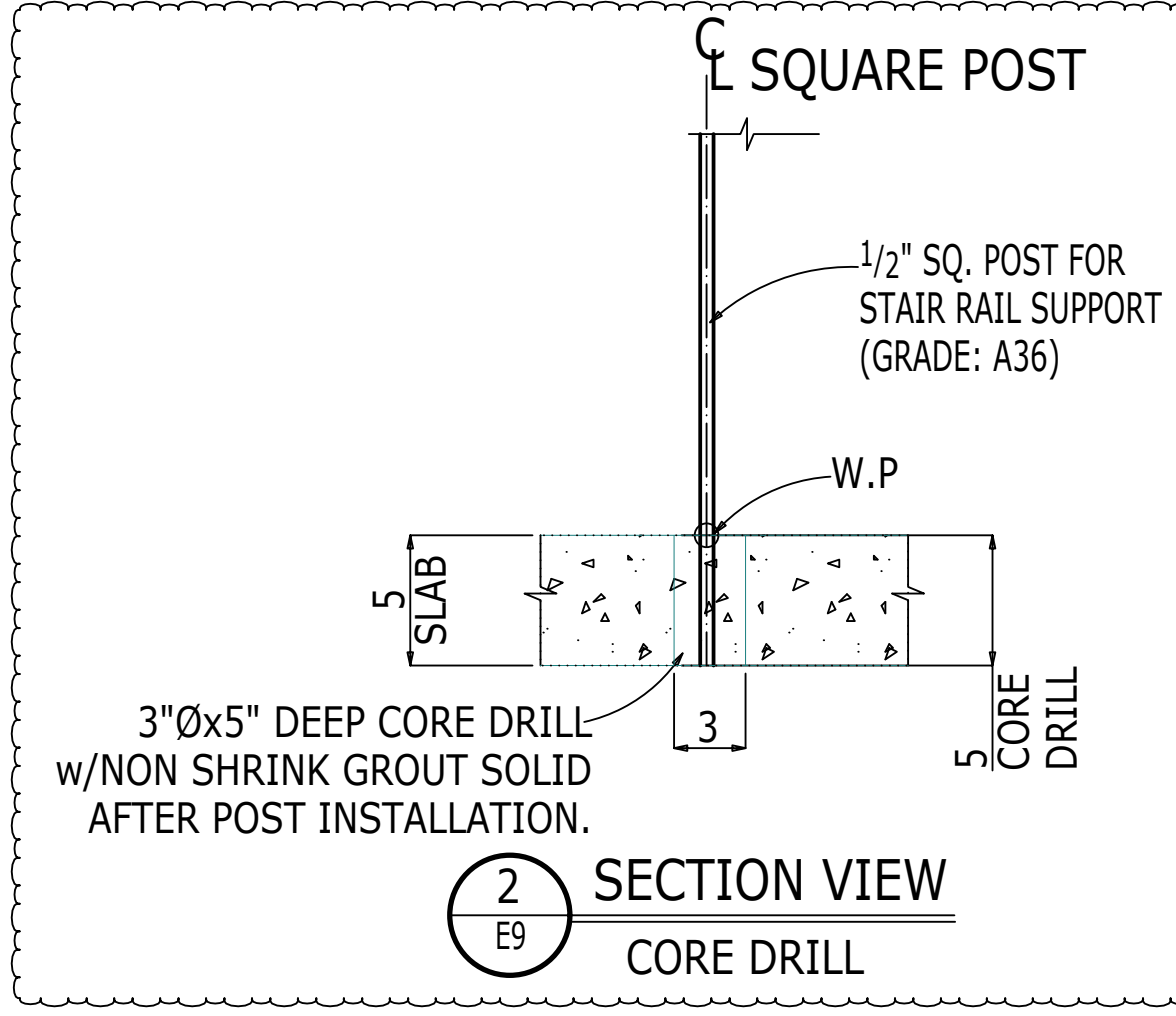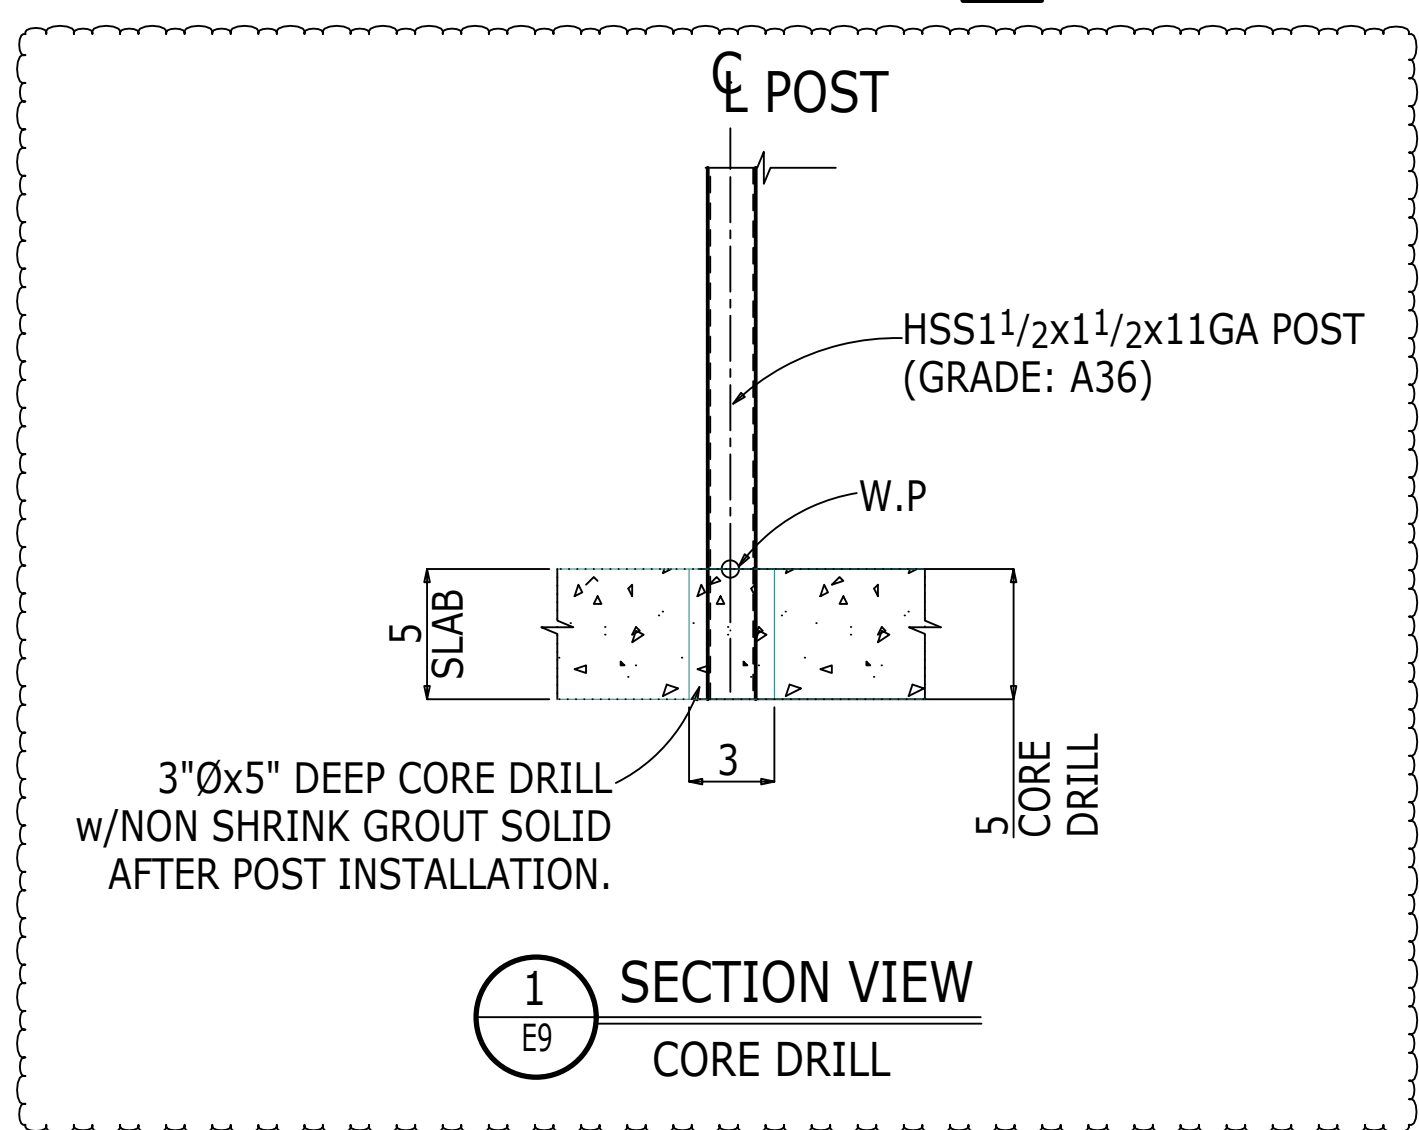

NOT FOR CONSTRUCTION			
BY:		09-09-2022	REVISED AS MARKED
DATE:		07-06-2022	FOR RE-APPROVAL
		06-10-2022	FOR APPROVAL

FUTURE FABRICATING
 P: 586.755.7080 • F: 586.755.7456 • www.futurefabricating.com

DRAWING REVIEW / APPROVAL:		
THESE DRAWINGS REPRESENT FUTURE FABRICATING'S INTERPRETATION OF THE INTENT OF THE CONTRACT DOCUMENTS. EVERY EFFORT HAS BEEN MADE TO ENSURE THAT THEY ARE ACCURATE AND COMPLETE. APPROVAL BY THE AUTHORIZED PARTIES SHALL CONSTITUTE ACCEPTANCE AND ANY POST APPROVAL CHANGES WILL BE CONSIDERED TO BE CHANGES TO FUTURE FABRICATING'S CONTRACT.		
DRAWN BY:	CHECKED BY:	FIELD MEASURED:
DATE: MSK	DATE: ARS	DATE:
06-03-2022	06-03-2022	
JOB NUMBER:		REV:
22-2089		
HANDRAILS AT NEW PRECAST STAIR - DETAILS		
PROJECT NAME:		
MOTOWN MUSEUM EXPANSION-PHASE 2		
CUSTOMER:		
L.S.BRINKER		
SHEET NUMBER:		
E9		