Lauren Hood, MCD
Chairperson
Donovan Smith
Vice Chair/Secretary

Marcell R. Todd, Jr. Director

# City of Detroit CITY PLANNING COMMISSION

208 Coleman A. Young Municipal Center Detroit, Michigan 48226 Phone: (313) 224-6225 Fax: (313) 224-4336

e-mail: cpc@detroitmi.gov

Brenda Goss Andrews Kenneth R. Daniels David Esparza, AIA, LEED Ritchie Harrison Gwen Lewis Melanie Markowicz Frederick E. Russell, Jr.

March 23, 2023

#### HONORABLE CITY COUNCIL

**RE:** Request of Mariners' Church of Detroit for PC (Public Center) Special District Review of proposed exterior alterations to 170 East Jefferson Avenue – Mariners' Church of Detroit

(RECOMMEND APPROVAL WITH CONDITIONS)

#### **REOUEST**

The City Planning Commission (CPC) has received a request from Thomas Roberts Architect on behalf of Mariners' Church for PC (Public Center) Special District Review of proposed exterior alterations to 170 East Jefferson Avenue – Mariners' Church of Detroit. This request is being made consistent with the provisions of Section 50-3-225 of the Zoning Ordinance. Section 50-3-225 states that whether or not site plan review is required for a project in the PC District, the exterior design, appearance, and location of exterior alterations shall be reviewed by the CPC and the Planning and Development Department (PDD) and require the authorization of Your Honorable Body.

#### Site Plan Review

In accordance with the provisions of Section 50-3-113, CPC staff finds that site plan review is not required based on the extent of proposed exterior modifications. Specifically, 50-3-113(5) does not apply as the Board of Zoning Appeals (BZA) is not "the body of first jurisdiction" for the PC District based on Section 50-3-225. Therefore, the CPC and the PDD shall review this request in accordance with Section 50-11-67 PC District review criteria.

#### **BACKGROUND & PROPOSAL**


From the Detroit Historical Society's Encyclopedia of Detroit:

Mariners' Church was established in 1842 with money willed by Julia Ann Anderson, the widow of Fort Detroit commander Colonel John Anderson. She specified that her lot on the corner of Woodward Avenue and Woodbridge Street in Detroit become "a site for a Mariners' Church..." specifically to watch over the spiritual well-being of sailors and the greater community. These sailors were often marginalized and treated as outsiders, so she also specified that it be a stone church, with "forever free" pews. Since sailors often could not afford pew rentals or give sufficient tithes to maintain the parish, the will stipulated that stores be designated for the ground floor to provide rental revenue. The plans and drawings of the "Perpendicular Gothic" building were made by C.N. Otis, a Buffalo, New York architect, and in 1849 the Gothic Revival stone structure was constructed on the site of Anderson's mansion. Scattered throughout the church are paintings, photographs and ship models that symbolize its maritime history. The various stained glass windows, by the J & R Lamb Studios, depict mariners and symbols of the Great Lakes. In 1955, Detroit's plans for a new civic center called for the demolition of the church. Instead, the 3000-ton building was moved 880 feet east to its current location. During the move, workers discovered a tunnel under the building from its days as a stop on the Underground Railroad. The Episcopal Church sought to


overturn Mariners' continuous legal independence free of denominational ties in the 1980s but was defeated twice. Mariners' has continuously served the community as a church in the Anglican tradition, governed independently.



1890's Image of Previous Location and Pinnacles – Twitter: @detroitstreetvu

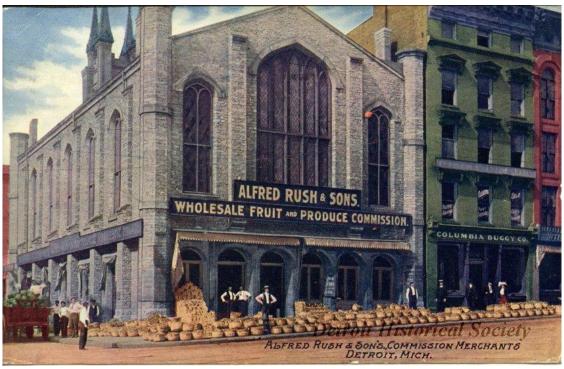

1910 Postcard Image of Previous Location – Detroit Historical Society

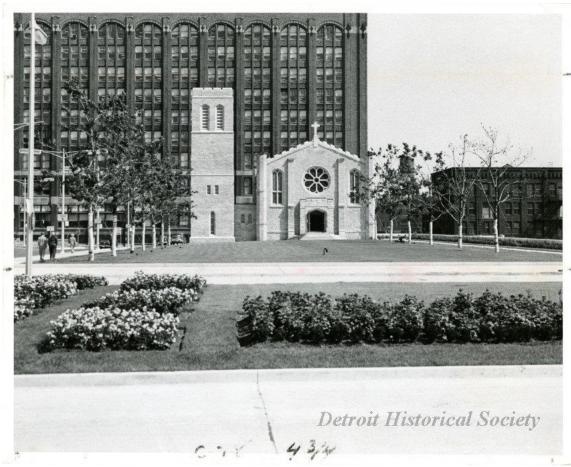

1960 Image of Current Location Looking East from Hart Plaza – Detroit Historical Society

## **Proposed Exterior Alterations:**

- 1. Pinnacles. Reconstructing new pinnacles at the top of existing turrets located at each of the four corners of the building. Each of the four pinnacles would be approximately 18 feet tall and designed to mimic pinnacles that were previously present on the building as shown in a historic image provided on sheet A7 of the church's Master Plan. Page notes indicate that the color and finish of the pinnacles would be to match existing stone coping, and dimensions and profiles would be to match historic drawings and photographs as best as possible.
- 2. Up-lighting. Focused up-lighting is proposed to highlight building architecture of all four facades, the tower, and the four reconstructed pinnacles. No lighting is proposed on the south façade wall facing the Detroit-Windsor Tunnel. Up-lighting is also proposed for the existing statue and flag located along East Jefferson Avenue that are separate from the building.
  - a. Section 50-14-418 states that all reasonable measures shall be taken to ensure that off-site spillover of light and nightglow are minimized to the greatest extent possible.
  - b. CPC staff finds that the revised Site Lighting plan dated July 28, 2022, would take reasonable measures to limit light spillover and nightglow as illuminance levels depicted on sheets A106, A108, and A110 indicate that the highest levels of illuminance would be focused on building facades, the tower, and pinnacles, and would not be focused off-site or directly into the sky. Additionally, there are numerous examples of buildings, especially churches, located within the Central Business District that have similar focused up-lighting provided.
- 3. Signage. Sometime during early-to-mid 2022, the existing readerboard type pole sign facing East Jefferson Avenue was removed from the site, see the below images for verification. It is our understanding that the church plans to replace this sign in the near future, potentially with

an upgraded digital sign similar to the removed sign. At this time, the applicant is not seeking approval of a replacement sign in order to proceed with more urgent building improvements, and the Master Plan indicates that the construction of any replacement sign in this location would be performed under a separate sign review and permit. Therefore, staff recommends that City Council delegate PC District review authority for any replacement sign to the City Planning Commission so that it can be reviewed administratively, along with the permitting authority BSEED. If City Council does not wish to delegate this authority to CPC, the applicant may pursue this replacement sign later as part of another PC District review.



August 2021 Google Streetview of Removed Pole Sign



October 2022 Staff Photo of Removed Sign Location

- 4. Niches. Masonry infill in two locations on the west façade (facing Hart Plaza) is proposed to be removed at original building openings. A new glass fiber reinforced cast niche is proposed for the display of statues by the owner. Details of the statues were not provided.
- 5. Additional improvements include: relocating the existing historic marker facing East Jefferson Avenue to the northeast corner of the site, removal of existing foundation plantings along the north side of the building, removal of concrete near the sign that has been removed

and concrete leading to the south and west facades, the addition of decorative metal screens for existing air conditioner units, cleaning and tuckpointing maintenance of the existing partial height walls along the north and east façades, and maintenance of the stone coping along the east and west façade rooflines and also the existing Mariners' stone sign to remain.

#### **REVIEW & ANALYSIS**

## Nonconforming Uses

Mariners' Church is considered a nonconforming use as "religious institutions", which is the specific land use term for churches, are not permitted as a by-right or conditional use in the PC District. However, the proposed exterior alterations to the nonconforming church use do not fall under the requirements of Section 50-15-26, which requires a public hearing at the Board of Zoning Appeals for expansion or intensification of a nonconforming use. Specifically, Section 50-15-26(2) does not apply as there is no proposed change to the site plan involving a structure. Therefore, as the BZA is not "the body of first jurisdiction" for the PC District based on Section 50-3-225, staff finds that the current request may proceed with CPC review in accordance with Section 50-11-67 PC District review criteria.

#### PC District Review Criteria

There are eighteen PC District Review Criteria listed in Section 50-11-67 of the Zoning Ordinance. As stated in Section 50-3-225, the purpose of this design review "is to ensure harmony with the Public Center and for consistency with the spirit, intent, and purpose of the Zoning Ordinance." Criteria that are most applicable to the proposed exterior alterations include:

(3) The proposed development should be compatible with surrounding development in terms of land use, general appearance and function and should not adversely affect the value of adjacent properties.

The proposed changes are minor and should not adversely affect adjacent properties.

(11) Signage and graphics should be tastefully designed to be visually appealing and in character with surrounding development; they should provide needed information, direction and orientation in a clear and concise manner.

Staff recommends that City Council delegate PC District review authority for any replacement sign to the City Planning Commission so that it can be reviewed administratively, along with the permitting authority BSEED. If City Council does not wish to delegate this authority to CPC, the applicant may pursue this replacement sign at a later date as part of another PC District review.

- (13) Barrier-free access and public safety features should be carefully planned. Existing barrier-free access to the church building south entrance would be maintained and does not appear to be impacted by the removal of small portions of concrete areas as these areas are not within the path of building entrances.
- (14) Preservation/restoration of buildings having architectural or historic value should be considered a primary objective.

A primary objective of the proposal is to preserve and restore the existing building of high architectural and historic value.

(15) Urban design elements of form and character should be carefully considered; such elements include, but are not limited to: richness/interest of public areas through the provision of storefronts, window displays, landscaping, and artwork; color, texture and quality of structural materials; enclosure of public spaces; variations in scale; squares, plazas and/or "vest pocket parks" where appropriate; continuity of experience, visual activity and interest; articulation and highlighting important visual features; preservation/enhancement of important views and vistas.

The reconstruction of the historic building pinnacles and the addition of niches for sculptures would add important elements to the site that would improve building richness/interest of public areas adjacent to the site, improve visual activity and interest of the building, and the proposed up-lighting would address articulation and highlight important visual features of the building.

## Design

The Planning & Development Department supports the requested improvements contained in the Mariner's Church Master Plan. The proposed changes and upgrades make the site more visually appealing and accentuate the unique character of the building through lighting, screening, and use of quality materials that should withstand deterioration over the years.

#### RECOMMENDATION

CPC staff recommends approval of the proposed exterior modifications to 170 East Jefferson Avenue as detailed in the attached Master Plan and with the following conditions:

- 1. That final site plans, elevations, landscape, and lighting plans be submitted for City Planning Commission staff approval prior to making application for applicable permits.
- 2. That City Council delegate PC review and approval authority of any future replacement sign as indicated in this report and the Master Plan to the City Planning Commission for review of a sign that complies with Chapter 4 of the 2019 Detroit City Code. City Planning Commission approval shall be required prior to BSEED granting a sign permit.
- 3. That written permission by the Michigan Historical Commission be obtained and submitted to BSEED for verification prior to removing and relocating the existing historic marker in accordance with Public Act 10 of 1955.

Respectfully submitted,

Marcell R. Todd, Jr., Director

Marvel R. LMJ.

Eric Fazzini, Staff

Attachments: 1. Mariners' Church Master Plan dated 3/6/2023

2. Mariners' Church Site Lighting dated 7/28/2022

3. P&DD Recommendation Letter dated 6/9/2022

4. Resolution

cc: Antoine Bryant, Director, PDD

Greg Moots, PDD

David Bell, Director, BSEED

Eric Johnson, BSEED

Conrad Mallett, Corp. Counsel, Law

Dan Arking, Law

Russell Beaver, RB Construction Company (applicant)

Thomas Roberts, AIA (architect)

# A RESOLUTION AUTHORIZING ALTERATIONS IN A PC ZONING DISTRICT AT MARINERS' CHURCH, 170 EAST JEFFERSON AVE.

BY COUNCIL MEMBER	

WHEREAS, Mariners' Church proposes exterior alterations at 170 East Jefferson Avenue; and

**WHEREAS**, Mariners' Church at 170 East Jefferson Avenue is located within an established PC (Public Center) zoning district; and

**WHEREAS**, work to be performed within a PC zoning district requires Special District Review and the purpose of the PC zoning district classification is provided for in Section 50-11-51 of the Zoning Ordinance as follows:

The PC Public Center District includes areas used or to be used for governmental, recreational, and cultural purposes of particular or special civic importance. All construction or other improvement within this district requires that the Planning and Development Department and the City Planning Commission review and make recommendation to City Council, as provided for in Article III, Division 6, of this chapter so as to ensure a completely harmonious, pleasing, and functional public center; and

WHEREAS, the City Council has received the CPC staff recommendation and concurrent support of the Planning and Development Department in the CPC report dated March 8, 2023.

**NOW, THEREFORE, BE IT RESOLVED**, that the Detroit City Council hereby approves the proposed exterior alterations depicted in drawings prepared by Thomas Roberts Architect and dated 3/6/2023 (Master Plan) and dated 7/28/2022 (Site Lighting), referenced in the staff report, with the following conditions:

- 1. That final site plans, elevations, landscape, and lighting plans be submitted for City Planning Commission staff approval prior to making application for applicable permits.
- 2. That City Council delegate PC review and approval authority of any future replacement sign as indicated in this report and the Master Plan to the City Planning Commission for review of a sign that complies with Chapter 4 of the 2019 Detroit City Code. City Planning Commission approval shall be required prior to BSEED granting a sign permit.
- 3. That written permission by the Michigan Historical Commission be obtained and submitted to BSEED for verification prior to removing and relocating the existing historic marker in accordance with Public Act 10 of 1955.

Coleman A. Young Municipal Center 2 Woodward Avenue, Suite 808 Detroit, Michigan 48226 Phone 313•224•1339 www.detroitmi.gov

Marcell R. Todd Jr., Director Detroit City Planning Commission 208 CAYMC Detroit, MI 48226

June 9, 2022

#### Dear Director Todd:

Following is the review by the Planning and Development Department (PDD) of the Mariner's Church Master Plan for 170 E Jefferson Ave. (BSEED Permit number BLD2022-02014). The church was listed on the National Register of Historic of Historic Places in 1971. As the property is zoned PC (Public Center), this review is required under Sec. 50-11-96 of the City of Detroit Zoning Ordinance.

The relevant PC criteria from Sec. 50-11-67 of the Zoning Ordinance are followed by our analysis in italics:

Criterion 9: Appropriate buffering and screening of service, loading, refuse collection, mechanical and electrical equipment and parking areas should be provided; Decorative metal screening of air conditioning units will create a more visually appealing treatment for service equipment. New trench drains and grate covers in existing sidewalk in the rear of building will provide for better drainage that is less intrusive for pedestrian traffic.

Criterion 11: Signage and Graphics should be tastefully designed to be visually appealing and in character with surrounding development, they should provide needed information, direction and orientation in a clear and concise manner; Relocation and 90 degree rotation of the sign, converting to a 2' X 5' double-sided digital display along Jefferson Ave. (north elevation) and restoring the grass under the relocated sign on the north elevation, relocating sign on the south elevation adjacent to entrance doors will be more accessible by pedestrians while still visible to vehicular traffic.

Criterion 14 Preservation/restoration of buildings having architectural or historic value should be considered a primary objective; Relocating of Historic marker to the corner on the west elevation tuckpointing of masonry walls, drainage updates, up lighting to bring attention to architectural detail of the north, east and west elevations building, removal of light pole on the west elevation, restoration of pinnacles on all elevations of the building by matching historical precedent, modifying niches for the display of statues on the west elevation by removing masonry infill, and appears appropriate.

Criterion 15: Urban design elements of form and character should be carefully considered; such elements include, but are not limited to: richness/ interest of public areas through the provision of storefronts, window displays, landscaping, and artwork; color, texture and quality of structural

materials; enclosure of public spaces; variations in scale; squares, plazas and/or "vest pocket parks" where appropriate; continuity of experience, visual activity and interest; articulation and highlighting of important visual features; preservation/enhancement of important views and vistas; Use of like colors and materials for the replacement of stone coping and sealant should retain the existing visual character of the building. Replacement of cement with grass and planting beds surrounding both signs on the south elevation provide visual interest and less hardscape for pedestrian foot-traffic.

PDD supports the requested improvements contained in the Mariner's Church Master Plan. The Master plan has included appropriate materials and new sign technology within a historic context. The proposed changes and upgrades make the site more visually appealing and accentuate the unique character of the building through lighting, screening and use of quality materials that should withstand deterioration over the years.

Our support of the double-sided digital display along Jefferson Ave. is contingent upon the sign meeting all Federal, State, and City regulations. We conclude that the proposed sign will not significantly negatively impact the character of the surrounding downtown area adjacent to the Public Center.

Respectfully submitted,

**Gregory Moots** 

Lead Planner-Design and Developer Innovation

regun & mooto

Planning and Development Department

CC: Karen Gage

Russell Baltimore



# MASTER PLAN

# for MARINERS' CHURCH OF DETROIT 170 E JEFFERSON AVE, DETROIT, MI 48226

March 6, 2023

#### **GENERAL NOTES**

- A. THIS MASTER PLAN DOCUMENT OUTLINES THE OWNER'S INTENT FOR DESIGN AND PERFORMANCE. WHILE IT MAY BE USED FOR THE PURPOSE OF A CONTRACTOR'S ORDER OF MAGNITUDE COST ESTIMATE, THIS DOCUMENT SHALL NOT BE USED FOR PERMITS AND / OR CONSTRUCTION.
- B. THE SPECIFIC SCOPE OF WORK WILL BE DETERMINED AND PROVIDED AT A LATER DATE; INCLUDING DIMENSIONS, DETAILS, SCHEDULES, ETC.
- C. THE MEANS AND METHODS OF CONSTRUCTION ARE THE RESPONSIBILITY OF THE CONTRACTOR; INCLUDING BUT NOT LIMITED TO POWER AND LIGHTING ELECTRICAL SERVICE AND CIRCUITING.

**REVIEWING AGENCIES:** 

CITY OF DETROIT BUILDING AND SAFETY

REFERENCED CODES/ORDINANCES:

BUILDING: 2015 MICHIGAN REHABILITATION CODE

FOR EXISTING BUILDINGS 2015 MICHIGAN BUILDING CODE

MECHANICAL: 2015 MICHIGAN MECHANICAL CODE PLUMBING: 2018 MICHIGAN PLUMBING CODE ELECTRICAL: 2017 NATIONAL ELECTRICAL CODE LIFE SAFETY & FIRE: 2015 MICHIGAN BUILDING CODE

2015 NFPA 101 LIFE SAFETY CODE

BARRIER FREE: ICC/ANSI A117.1 (2009) ZONING ORDINANCE: CITY OF DETROIT

Owner: Mariners' Church of Detroit

170 E. Jefferson Ave.

Detroit, MI 48226

313.259.2206

Sheet Index: ---- Cover

A1 Site Plan

A2 North Elevation

A3 East Elevation

A4 South Elevation

A5 West Elevation

A6 Details

A7 Details

A8 Details

A9 Details


Architect: Thomas Roberts Architect

2927 4th Street

Wyandotte, MI 48192


734.250.4032



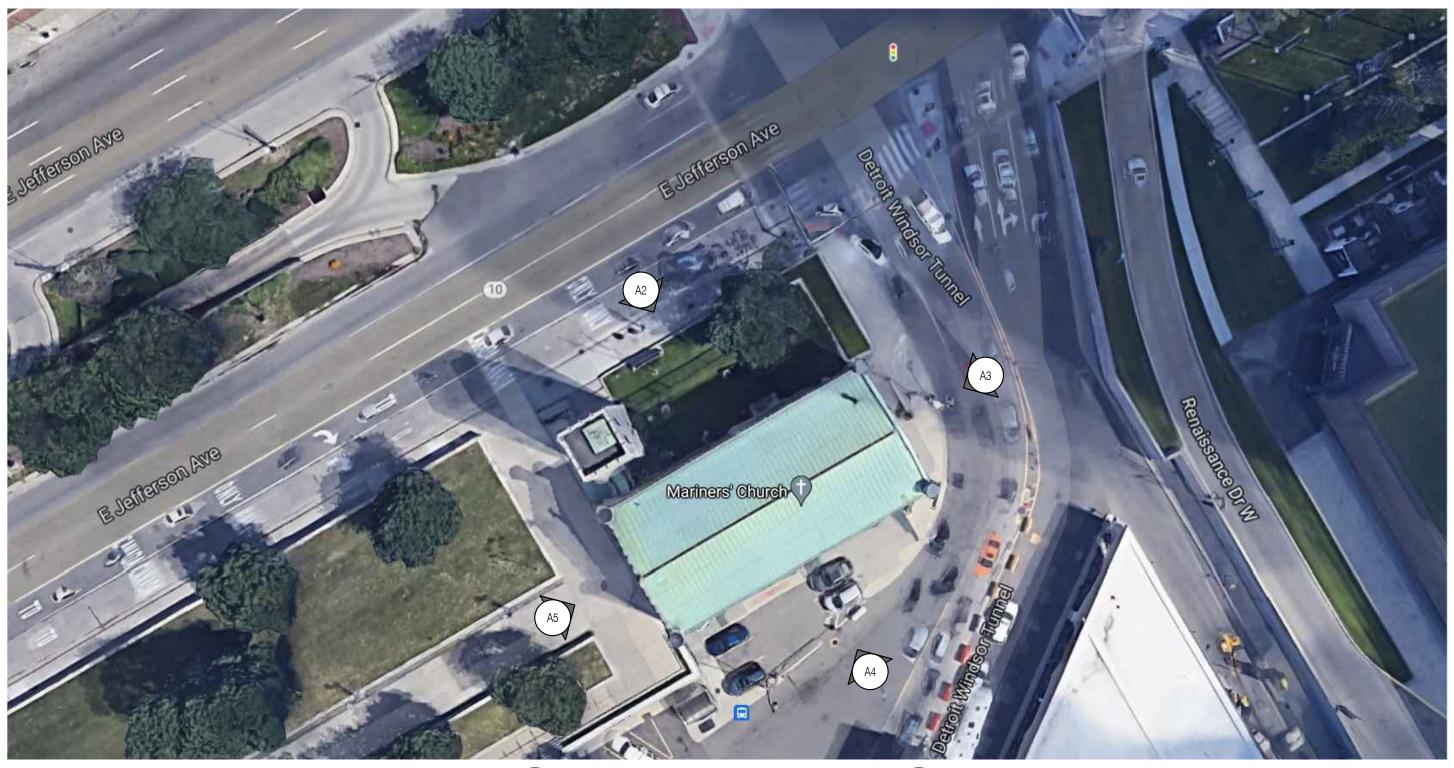






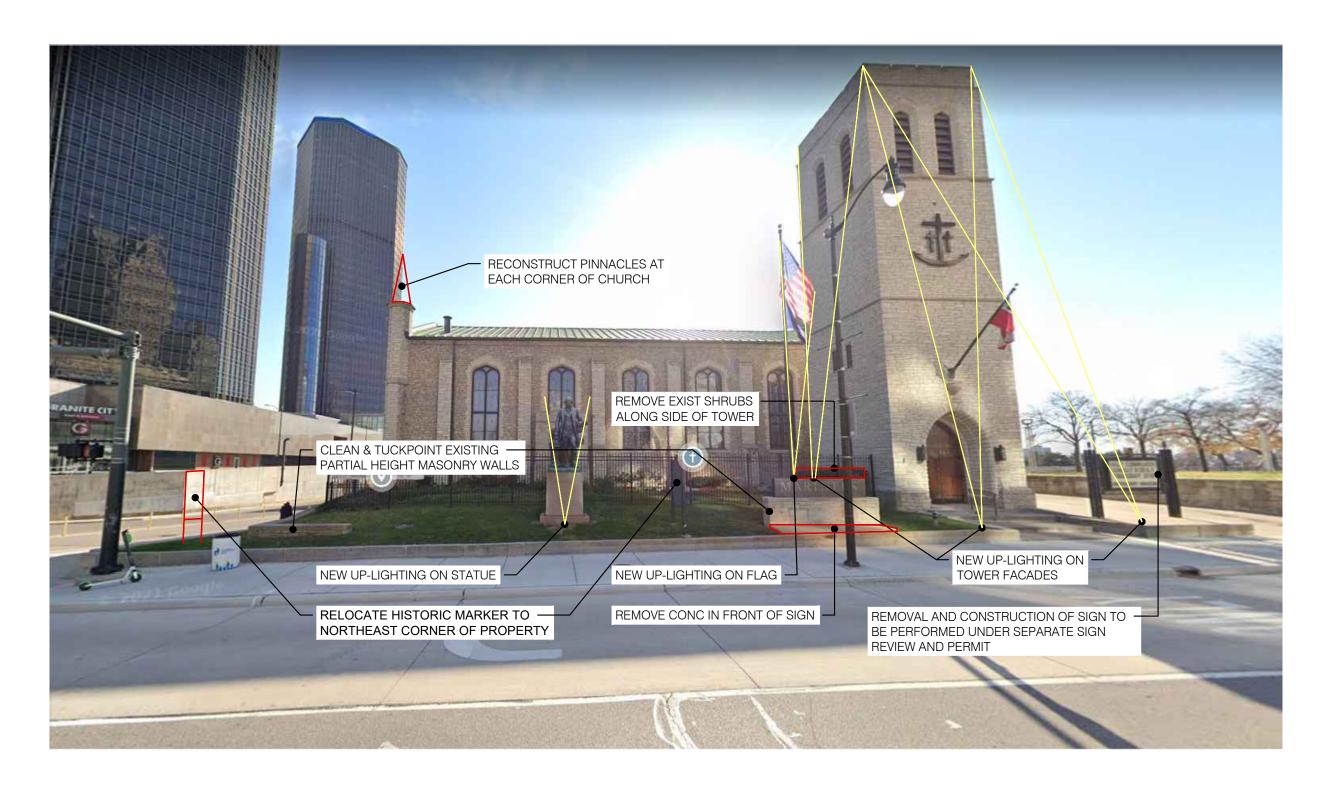


# NORTH ELEVATION




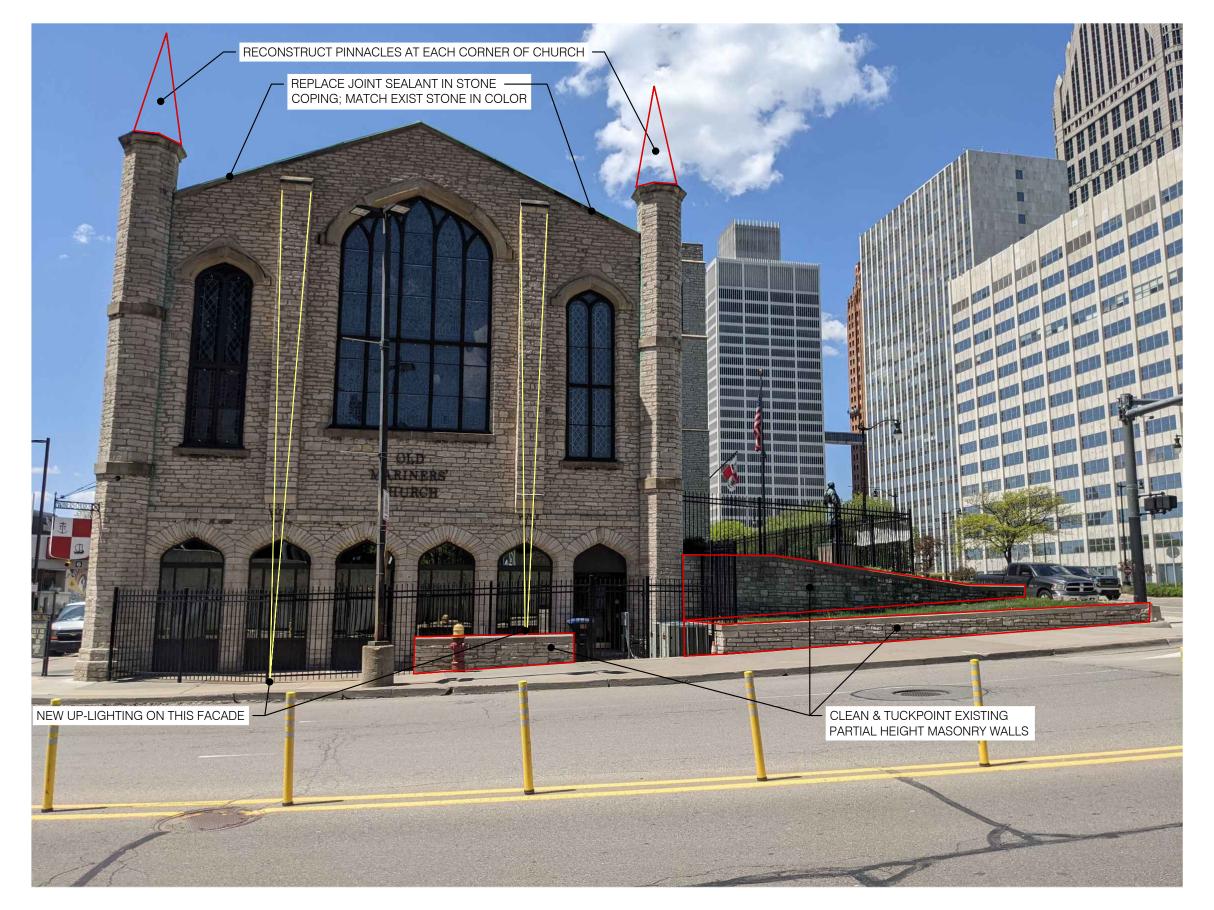



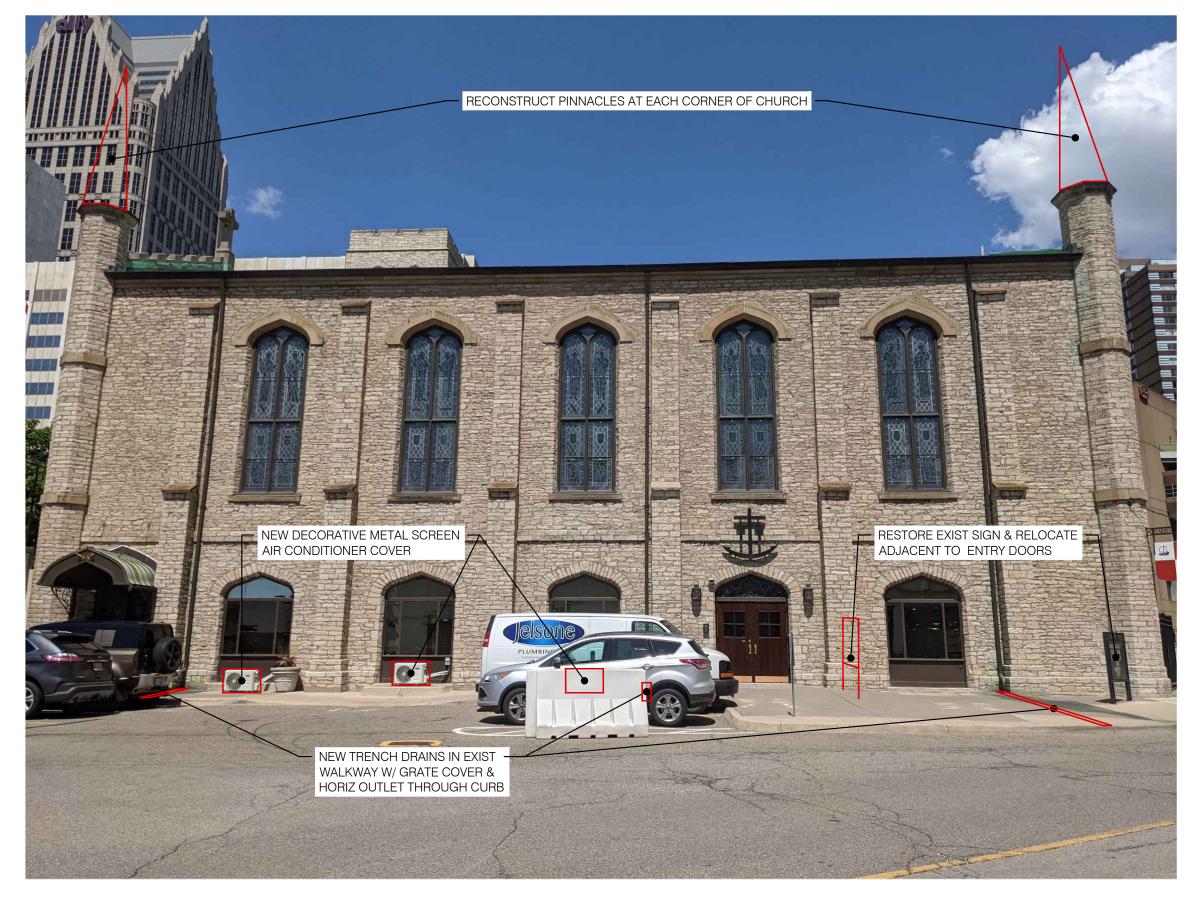




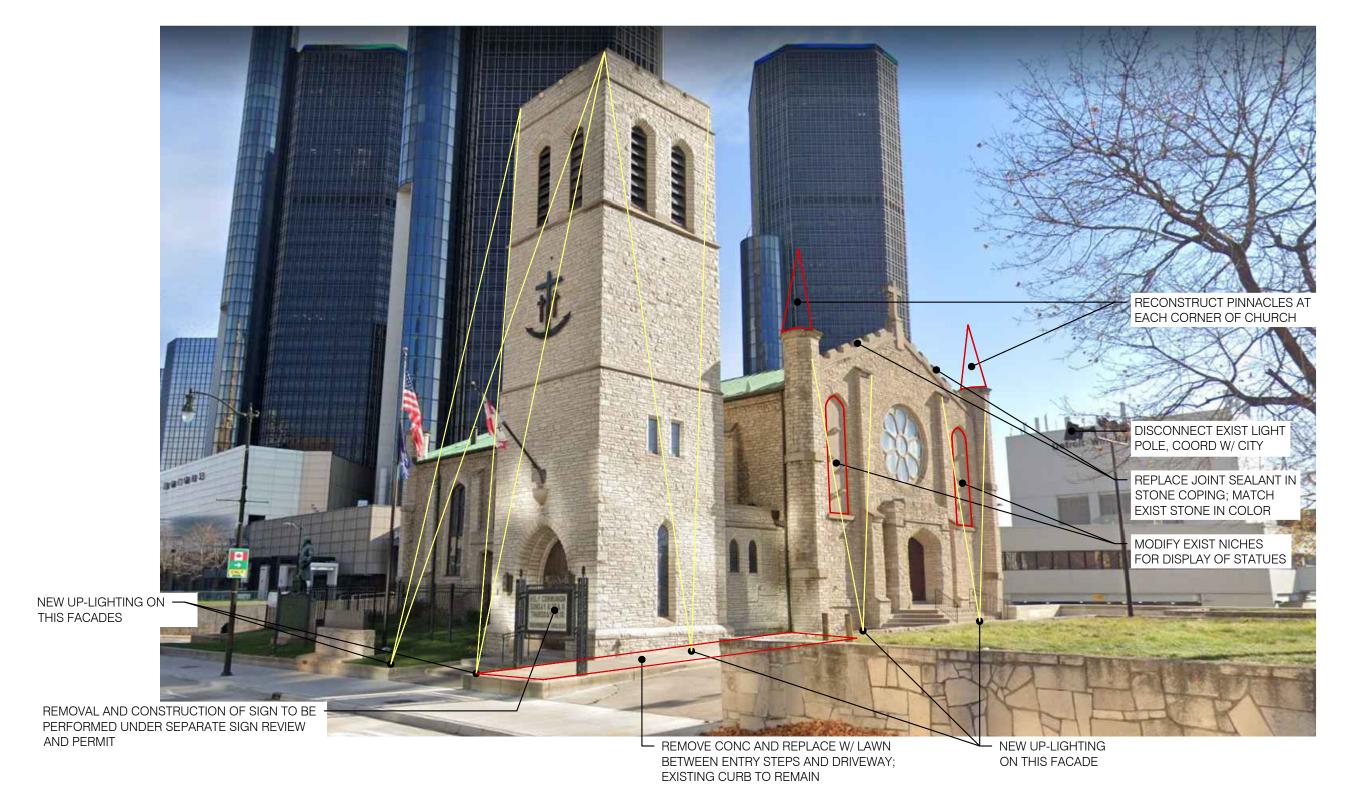


# WEST ELEVATION



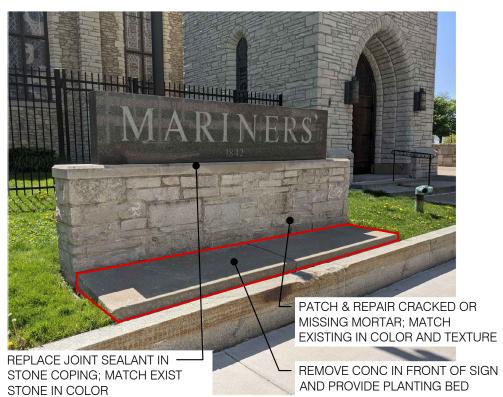


REMOVAL AND CONSTRUCTION OF SIGN TO BE — PERFORMED UNDER SEPARATE SIGN REVIEW AND PERMIT



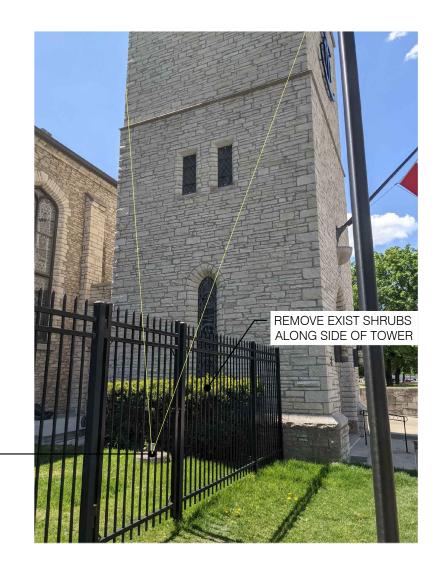



# 

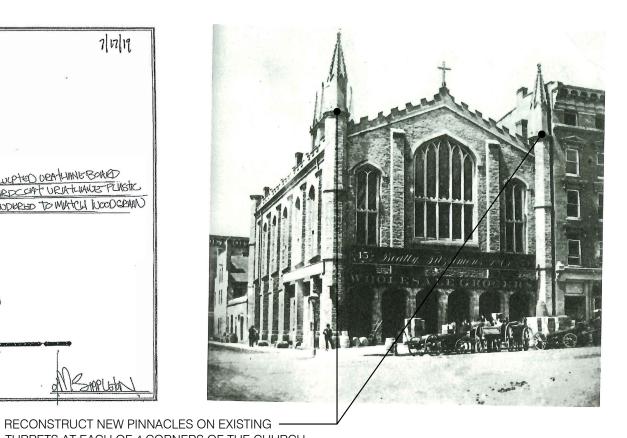


## PRODUCTS:

#### PINNACLES: PROP ART INC. OR EQUAL

- ALUMINUM OR STEEL INTERIOR SQUARE BOX TRUSS FRAMING WITH ONE-PIECE PICK POINT AT TOP
- ANCHORING HARDWARE TBD
- SCULPTED 6 LB. DENSITY URETHANE BOARD ATTACHED TO BOX FRAME; SEALED AND SANDED SEAMS, JOINTS, AND GAPS
- ACCESS PANEL AT BASE
- SPRAY APPLIED URETHANE PLASTIC HARD COAT; COLOR AND FINISH TO MATCH EXISTING STONE COPING
- AUTOMOTIVE GRADE CLEAR URETHANE TOP COAT
- DIMENSIONS AND PROFILES TO MATCH HISTORIC DRAWINGS AND PHOTOGRAPHS AS BEST POSSIBLE


#### LUMINAIRES: LUMENPULSE LUMENBEAM MEDIUM/GRANDE

- MEDIUM 28W FIXTURE FOR COLUMNS, TREES OR OTHER ARCHITECTURAL AND LANDSCAPE FEATURES
- GRANDE 100W FIXTURE FOR ARCHITECTURAL EXTERIORS AND FACADES
- OPTIONS FOR FLOOD OR ACCENT LIGHTING; COLOR TEMPERATURES AND COLORS; MOUNTING; ACCESSORIES; SPREAD LENSES; AND CONTROLS.

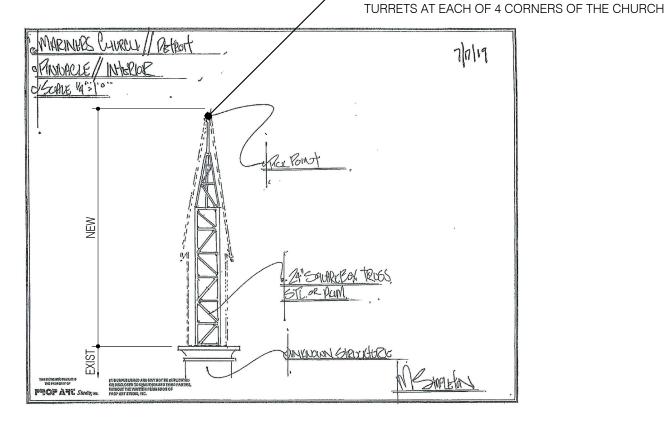

REPLACE JOINT SEALANT IN STONE COPING; MATCH EXISTING STONE IN COLOR

PATCH & REPAIR CRACKED OR — MISSING MORTAR; MATCH EXISTING IN COLOR AND TEXTURE

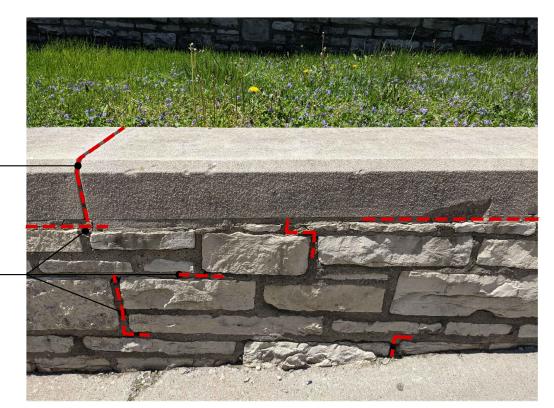



Plan Notes Series Number: PD-2509 (Imperial Star)


- Geltes Number 19-2009 (Imperial Star)


  1. Grates:


  Ductile Iron per ASTM A536-84 Grade 80-55-06 (Uncoated)

  Load Rating: 494 PSI (AASHTO M-306 Test Method)

  Made in the USA
- Concrete: Concrete Thickness and Reinforcement per Structural Engineer's Specification for the Application.

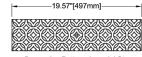

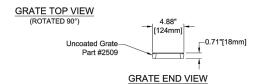

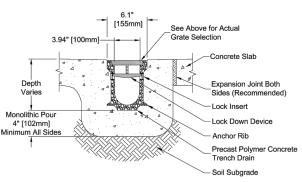

END CROSS SECTION VIEW

# PRODUCTS:

TRENCH DRAIN: ABT, INC. POLYDRAIN OR EQUAL

- MODULAR PRE-ENGINEERED, PRE-SLOPED 4" CHANNEL MADE FROM POLYMER CONCRETE
- ENDPLATES WITH HORIZONTAL OUTLET THROUGH CURB
- ORNAMENTAL DUCTILE IRON SLOTTED GRATING WITH LOCKS


AIR CONDITIONER COVER: TITAN CUT L.L.C. OR EQUAL

- LASER CUT METAL SCREEN PANELS CUSTOM MADE TO ORDER AS 5-SIDED COVER
- 14 GA. MILD STEEL OR ALUMINUM
- POWDERCOAT FINISH IN STANDARD COLOR



(3) NEW DECORATIVE METAL SCREEN AIR CONDITIONER COVERS WITH LOCKABLE ACCESS PANEL FOR MAINTENANCE

SAW CUT EXISTING WALKWAY AND PROVIDE (3) NEW TRENCH DRAINS W/ GRATE COVER & HORIZ OUTLET THROUGH CURB

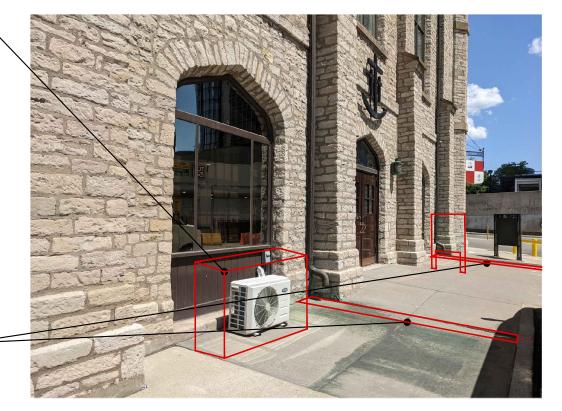



## PRODUCTS:

NICHES: STROMBERG ARCHITECTURAL OR EQUAL


- GLASS FIBER REINFORCED STONE (GFRS): CRUSHED STONE AND RESIN WITH ALKALI RESISTANT GLASS FIBERS MIXED AND SPRAYED INTO A MOLD
- CUSTOM DESIGN: ORNATE CURVES, SCROLLED EDGES AND DESIGNS THAT COMPLEMENT OTHER ARCHITECTURAL ELEMENTS LIKE ENTRYWAYS OR MEDALLIONS
- FINAL PRODUCT HAS THE LOOK OF TRADITIONAL HEAVY STONEWORK BUT AT A FRACTION OF THE WEIGHT



REMOVAL AND CONSTRUCTION OF SIGN TO BE PERFORMED UNDER SEPARATE SIGN REVIEW AND PERMIT

REMOVE CONC AND REPLACE W/
LAWN BETWEEN ENTRY STEPS /
BUILDING AND DRIVEWAY;
WATERPROOF BUILDING
FOUNDATION BELOW GRADE
EXPOSED DURING CONSTRUCTION

REMOVE EXIST MASONRY INFILL -AT ORIGINAL OPENING; INSERT NEW GLASS FIBER REINFORCED CAST NICHE FOR DISPLAY OF STATUES BY OWNER

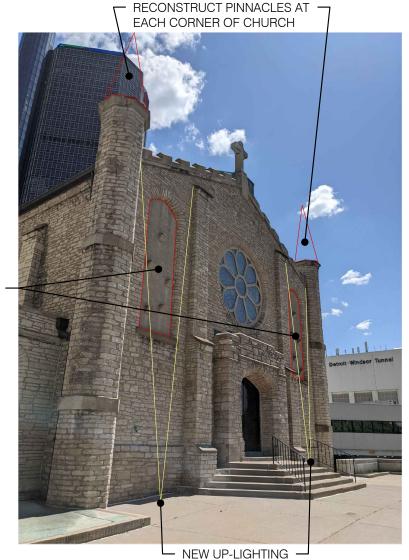

ON THIS FACADE

# MARINER'S CHURCH OF DETROIT

# Site Lighting



# owner

MARINERS CHURCH OF DETROIT

170 E. Jefferson Ave.

Detroit, MI 48226

# architect

THOMAS ROBERTS ARCHITECT, LLC 2927 4th Street Wyandotte, MI 48192 734.250.4032 (t)

# general contractor RB CONSTRUCTION COMPANY

B CONSTRUCTION COMPANY 249 Cass Avenue Mount Clemens, MI 48043 586.264.9478 (t)


# Drawing Index

	Cover Sheet
	Cover Sneet
A101	Lighting Plan
A102	West Elevation
A103	East Elevation
A104	North Elevation
A105	West Isometric Contrast
A106	West Isometric Illuminance
A107	North Isometric Contrast
A108	North Isometric Illuminance
A109	East Isometric Contrast
A110	East Isometric Illuminance
A111	North Isometric Contrast
A112	North Isometric Illuminance
A113	Specification Sheets

170 E. Jefferson Ave. Detroit, MI 48226



Location Map

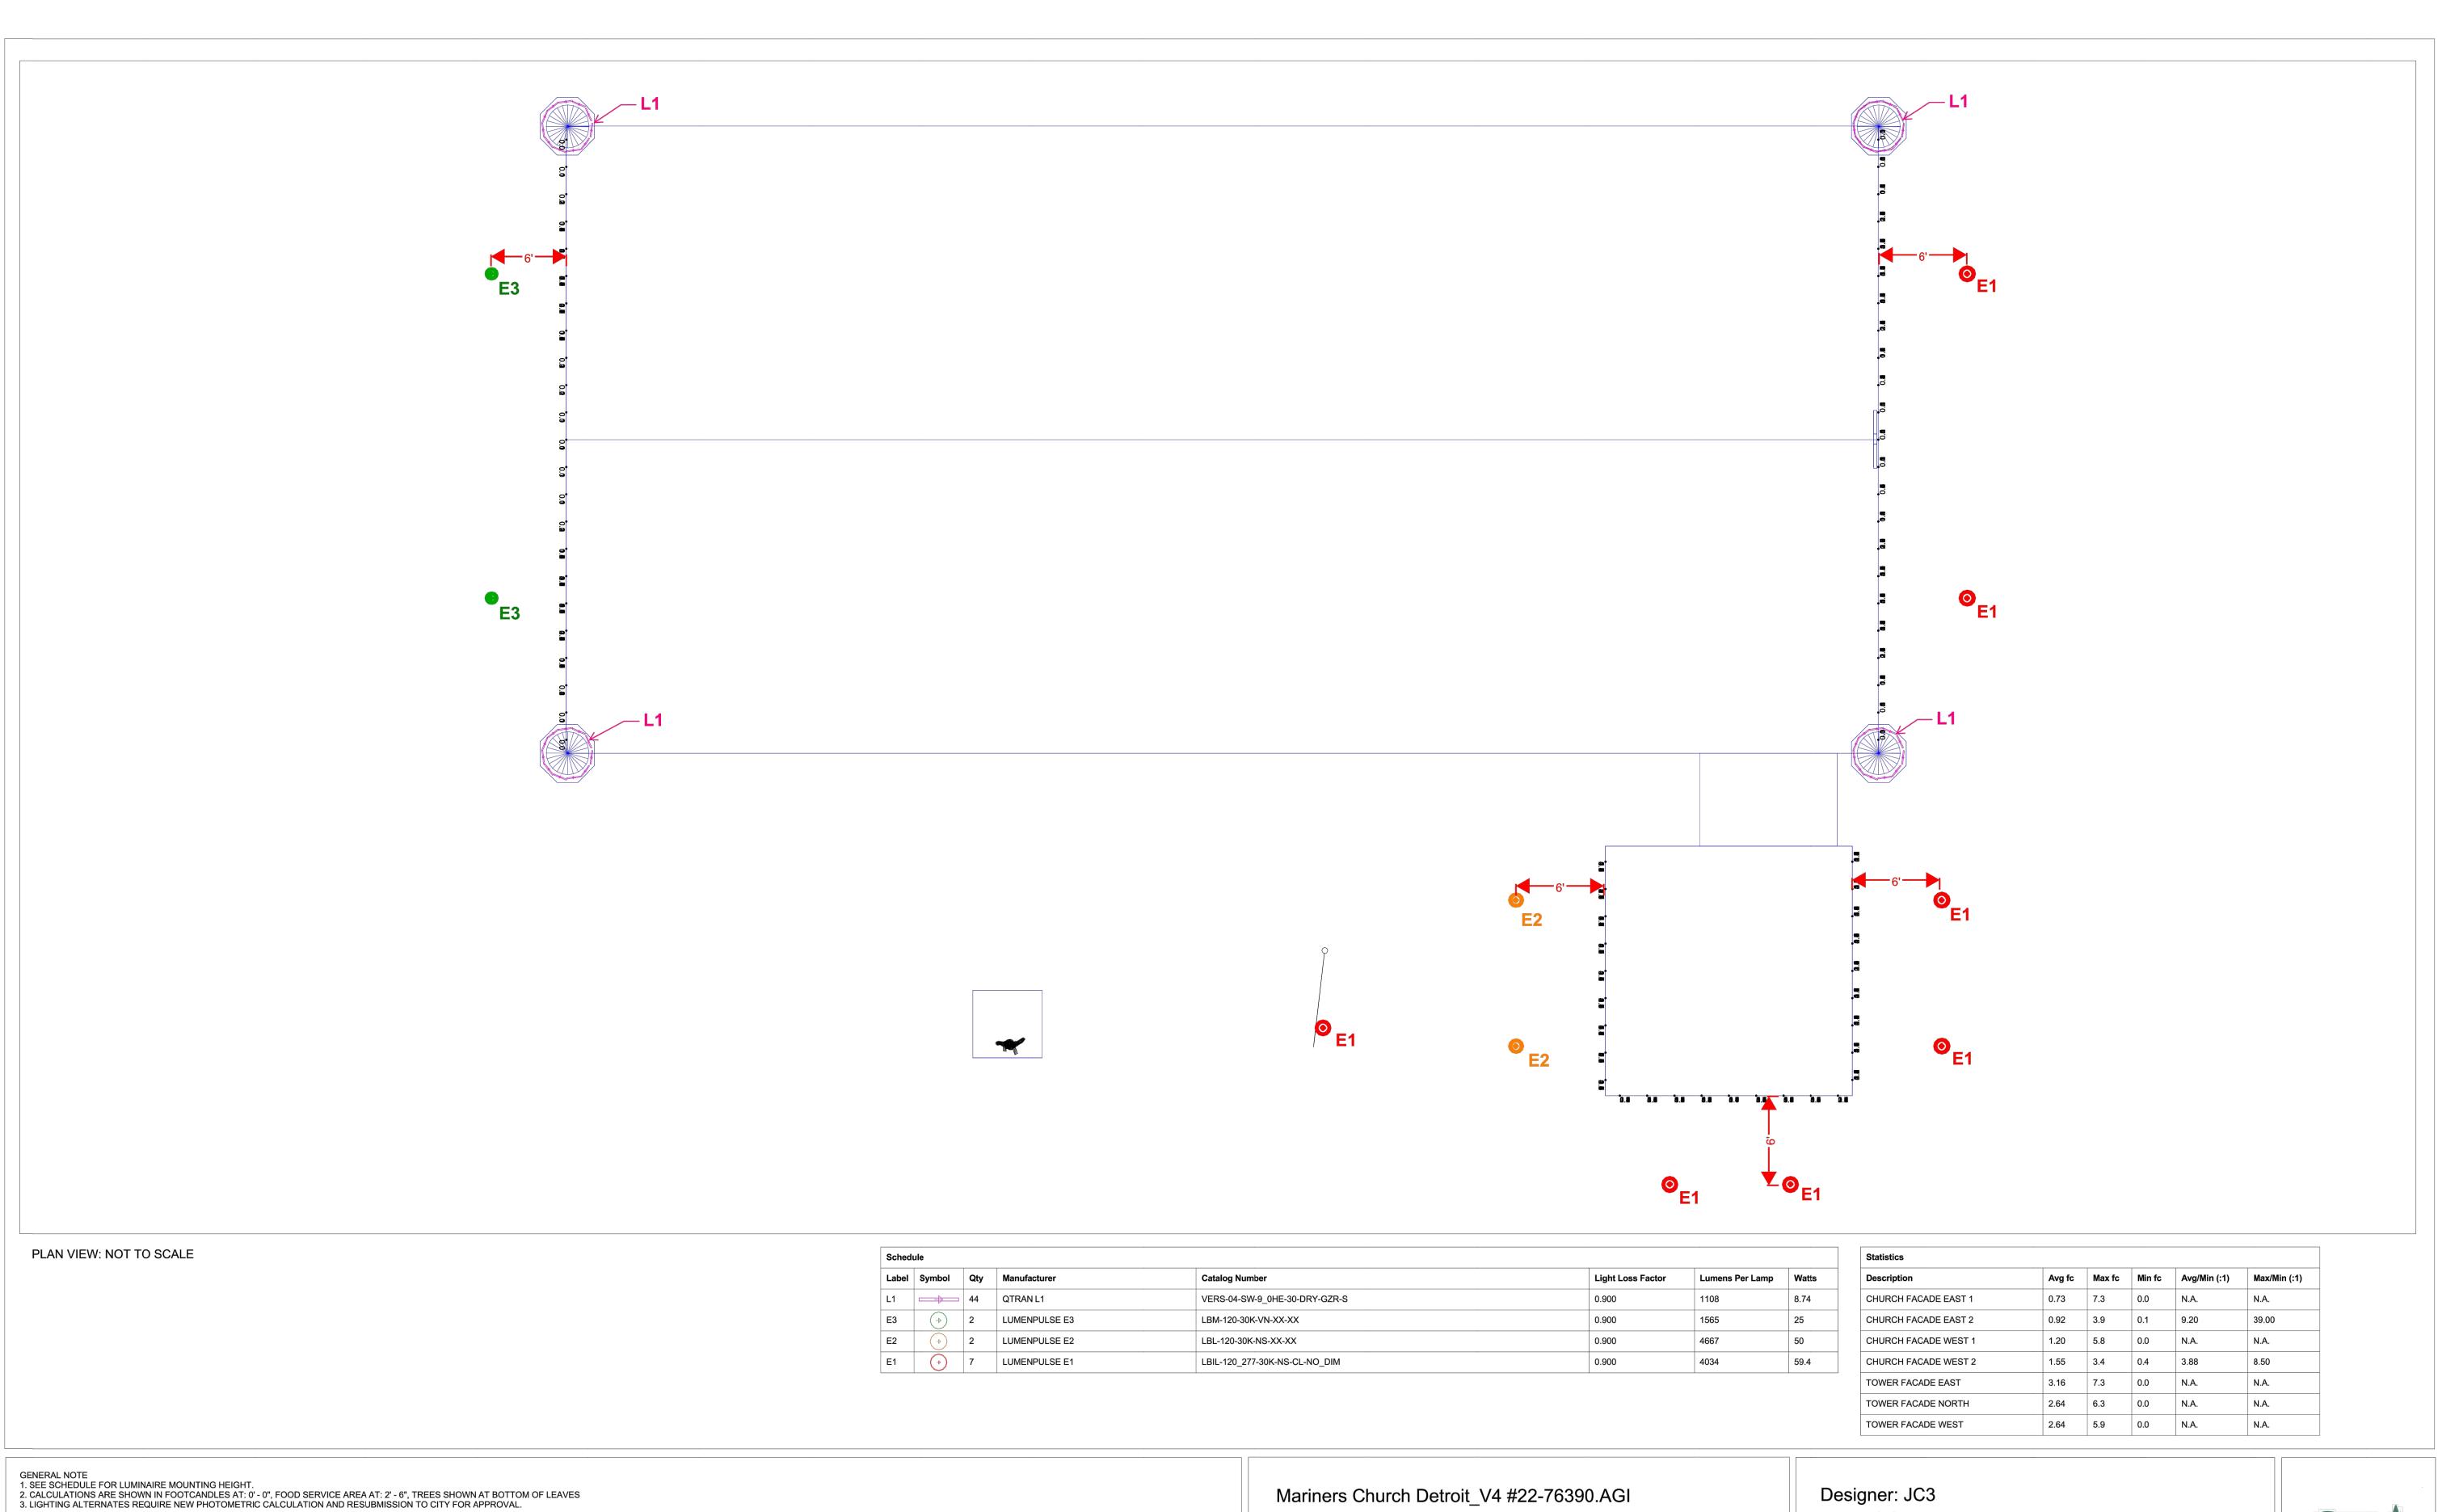

Gasser Bush Associates / Applications

www.gasserbush.com

- THE ENGINEER AND/OR ARCHITECT MUST DETERMINE APPLICABILITY OF THE LAYOUT TO EXISTING / FUTURE FIELD CONDITIONS.
THIS LIGHTING LAYOUT REPRESENTS ILLUMINATION LEVELS CALCULATED FROM LABORATORY DATA TAKEN UNDER CONTROLLED CONDITIONS IN ACCORDANCE WITH ILLUMINATING ENGINEERING SOCIETY APPROVED METHODS.
ACTUAL PERFORMANCE OF ANY MANUFACTURER'S LUMINAIRE MAY VARY DUE TO VARIATION IN ELECTRICAL VOLTAGE, TOLERANCE IN LAMPS, AND OTHER VARIABLE FIELD CONDITIONS. MOUNTING HEIGHTS INDICATED ARE FROM GRADE AND/OR FLOOR UP.

- THESE LIGHTING CALCULATIONS ARE NOT A SUBSTITUTE FOR INDEPENDENT ENGINEERING ANALYSIS OF LIGHTING SYSTEM SUITABILITY AND SAFETY.

THE ENGINEER AND/OR ARCHITECT IS RESPONSIBLE TO REVIEW FOR MICHIGAN ENERGY CODE AND LIGHTING QUALITY COMPLIANCE.

- UNLESS EXEMPT, PROJECT MUST COMPLY WITH LIGHTING CONTROLS REQUIRMENTS DEFINED IN ASHRAE 90.1 2013. FOR SPECIFIC INFORMATION CONTACT GBA CONTROLS GROUP AT ASG@GASSERBUSH.COM OR 734-266-6705.


- FOR ORDERING INQUIRIES CONTACT GASSER BUSH AT QUOTES@GASSERBUSH.COM OR 734-266-6705.

- THIS DRAWING WAS GENERATED FROM AN ELECTRONIC IMAGE FOR ESTIMATION PURPOSE ONLY. LAYOUT TO BE VERIFIED IN FIELD BY OTHERS.

- MOUNTING HEIGHT IS MEASURED FROM GRADE TO FACE OF FIXTURE. POLE HEIGHT SHOULD BE CALCULATED AS THE MOUNTING HEIGHT LESS BASE HEIGHT.

Thomas Roberts Architects

2927 4th Street Wyandotte, MI 48192 thomasrobertsarchitect.com 734.250.4032

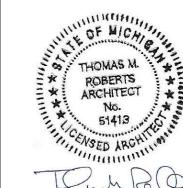

51413 ACO


Mariners Church of Detroit Site Lighting 170 E. Jefferson Ave. Detroit, MI 48226

TR
principal in charge
TR
project manager
TR
project architect
SM
drawn
07.28.2022

22010.00 job number

Date:6/9/2022

Scale: NOT TO SCALE

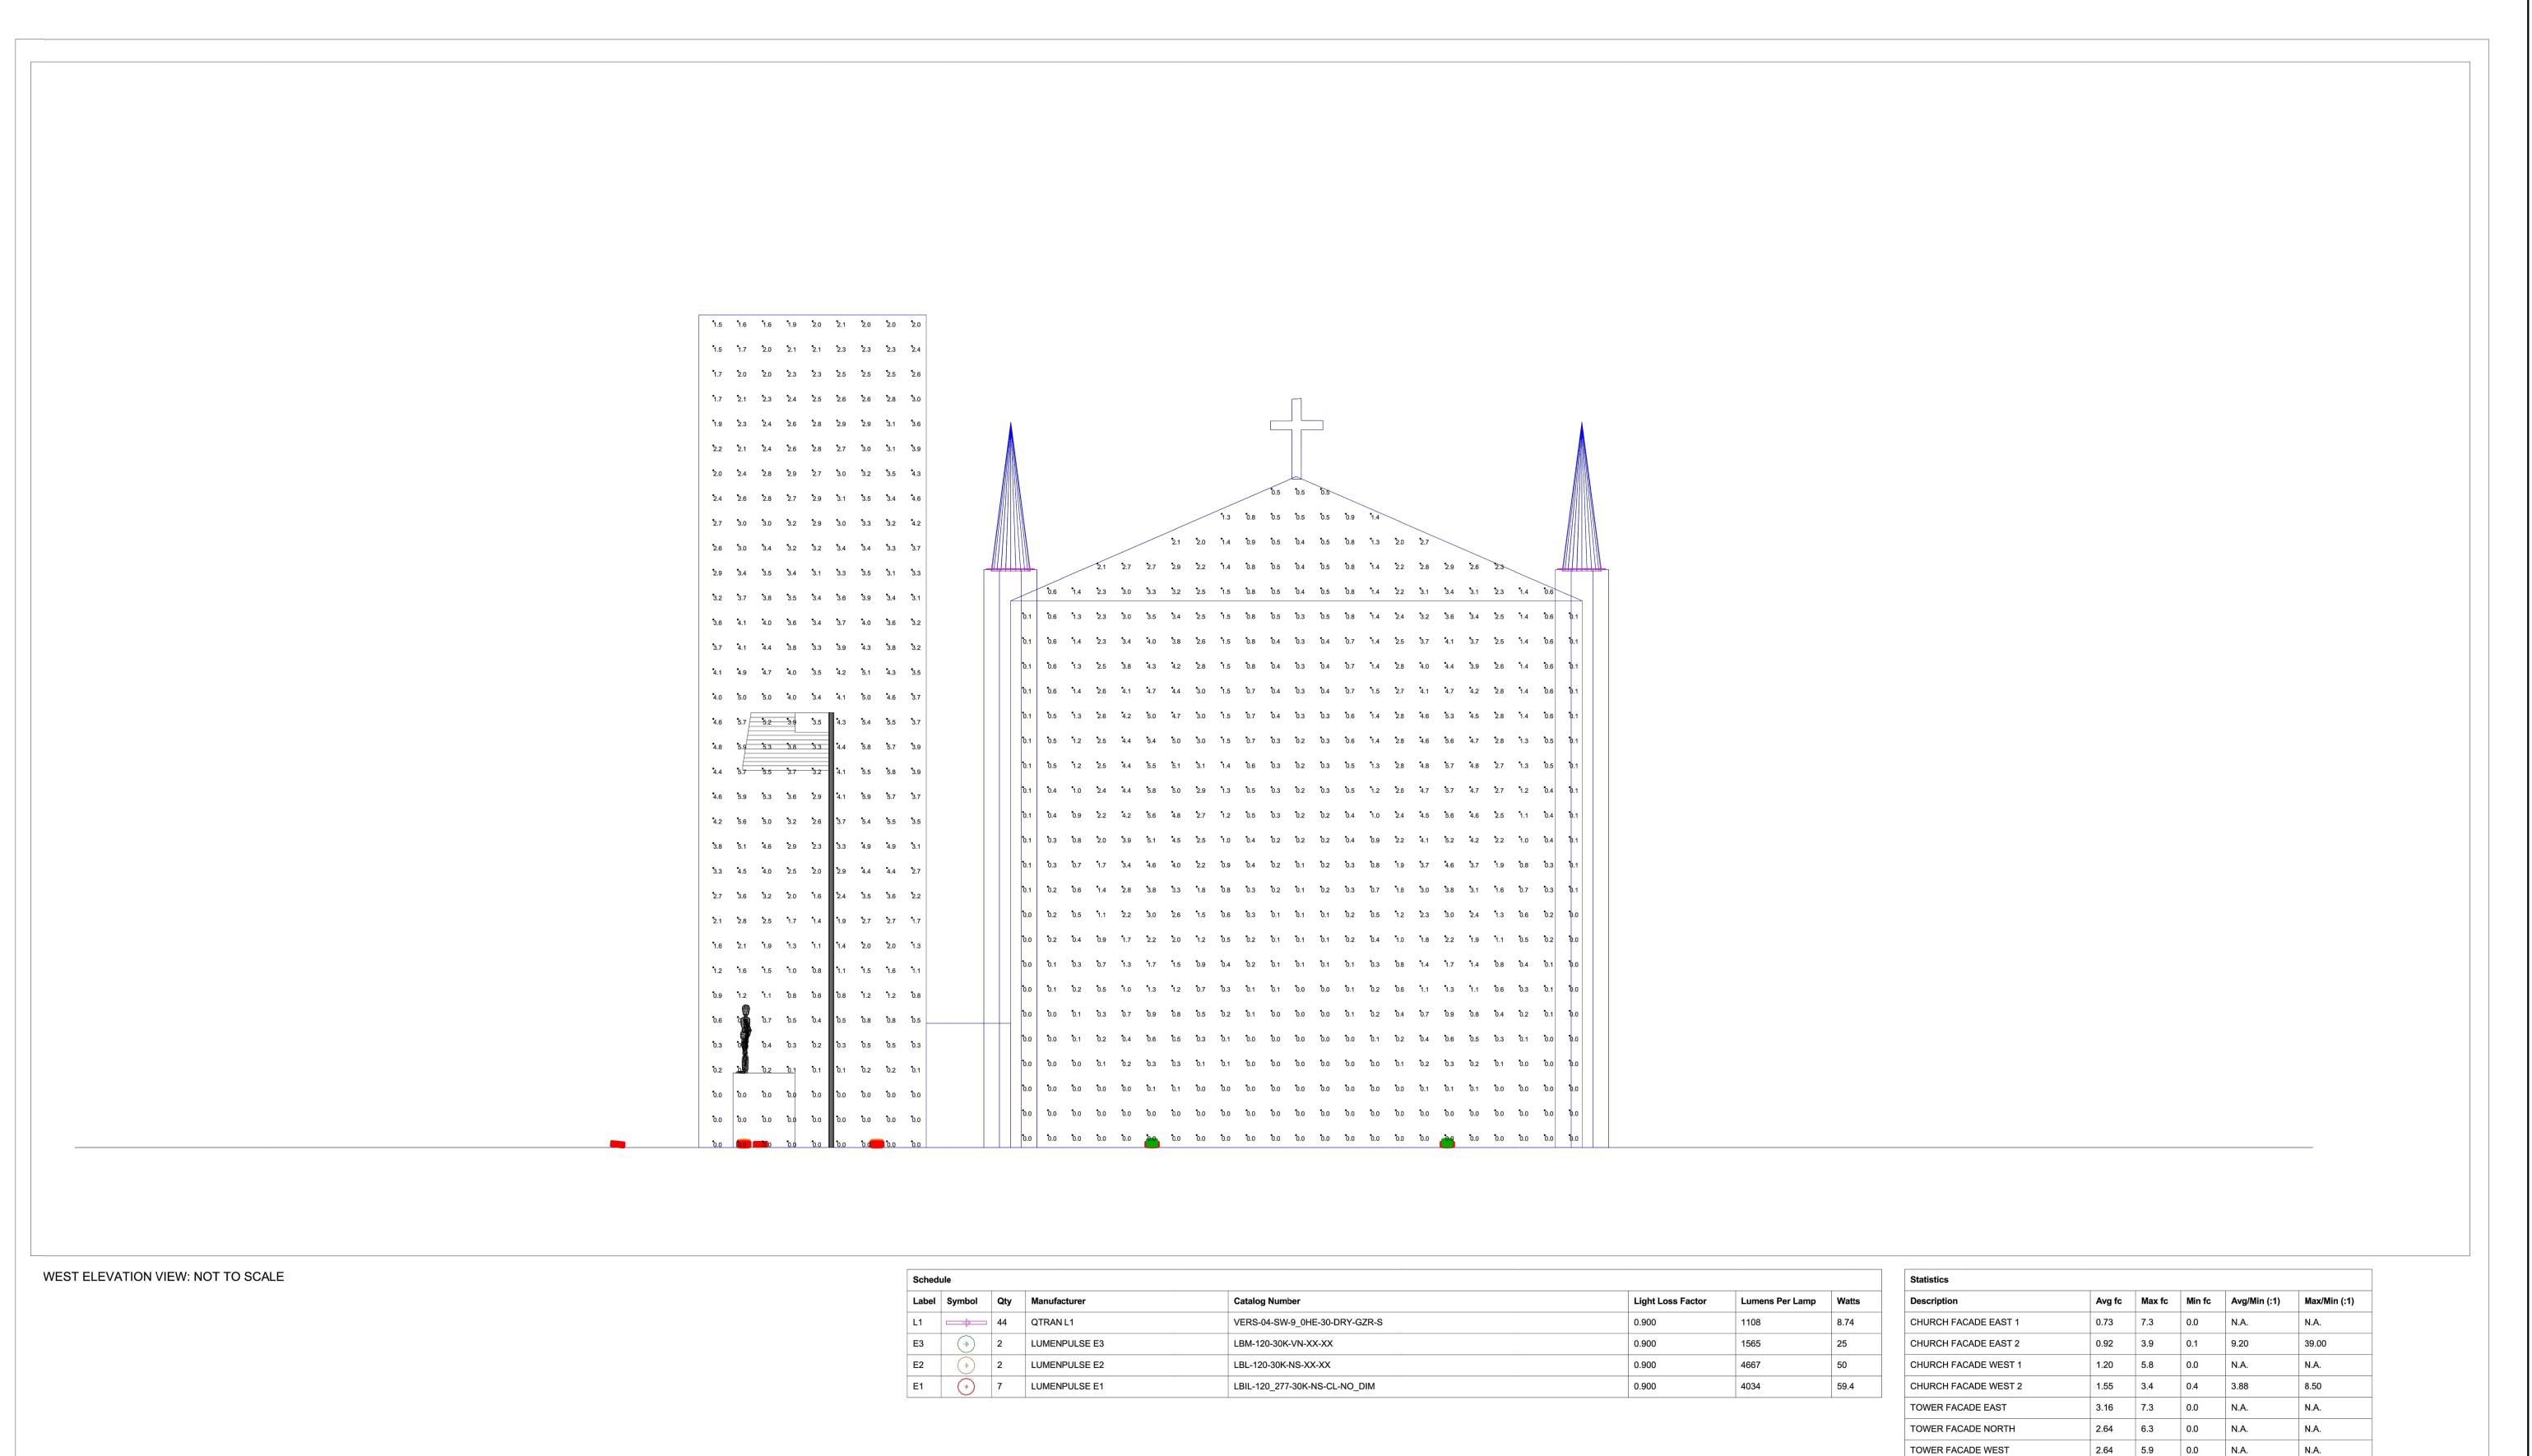

1. SEE SCHEDULE FOR LUMINAIRE MOUNTING HEIGHT.

2. CALCULATIONS ARE SHOWN IN FOOTCANDLES AT: 0' - 0", FOOD SERVICE AREA AT: 2' - 6", TREES SHOWN AT BOTTOM OF LEAVES

3. LIGHTING ALTERNATES REQUIRE NEW PHOTOMETRIC CALCULATION AND RESUBMISSION TO CITY FOR APPROVAL. - THE ENGINEER AND/OR ARCHITECT MUST DETERMINE APPLICABILITY OF THE LAYOUT TO EXISTING / FUTURE FIELD CONDITIONS.

THIS LIGHTING LAYOUT REPRESENTS ILLUMINATION LEVELS CALCULATED FROM LABORATORY DATA TAKEN UNDER CONTROLLED CONDITIONS IN ACCORDANCE WITH ILLUMINATING ENGINEERING SOCIETY APPROVED METHODS. ACTUAL PERFORMANCE OF ANY MANUFACTURER'S LUMINAIRE MAY VARY DUE TO VARIATION IN ELECTRICAL VOLTAGE, TOLERANCE IN LAMPS, AND OTHER VARIABLE FIELD CONDITIONS. MOUNTING HEIGHTS INDICATED ARE FROM GRADE AND/OR FLOOR UP.

THESE LIGHTING CALCULATIONS ARE NOT A SUBSTITUTE FOR INDEPENDENT ENGINEERING ANALYSIS OF LIGHTING SYSTEM SUITABILITY AND SAFETY.

THE ENGINEER AND/OR ARCHITECT IS RESPONSIBLE TO REVIEW FOR MICHIGAN ENERGY CODE AND LIGHTING QUALITY COMPLIANCE. - UNLESS EXEMPT, PROJECT MUST COMPLY WITH LIGHTING CONTROLS REQUIRMENTS DEFINED IN ASHRAE 90.1 2013. FOR SPECIFIC INFORMATION CONTACT GBA CONTROLS GROUP AT ASG@GASSERBUSH.COM OR 734-266-6705.

FOR ORDERING INQUIRIES CONTACT GASSER BUSH AT QUOTES@GASSERBUSH.COM OR 734-266-6705.

- THIS DRAWING WAS GENERATED FROM AN ELECTRONIC IMAGE FOR ESTIMATION PURPOSE ONLY. LAYOUT TO BE VERIFIED IN FIELD BY OTHERS. - MOUNTING HEIGHT IS MEASURED FROM GRADE TO FACE OF FIXTURE. POLE HEIGHT SHOULD BE CALCULATED AS THE MOUNTING HEIGHT LESS BASE HEIGHT. Mariners Church Detroit\_V4 #22-76390.AGI

Gasser Bush Associates / Applications

www.gasserbush.com


Designer: JC3 Date:6/9/2022


Scale: NOT TO SCALE



Thomas Roberts Architects Thomas Roberts Architects Thomas Roberts Architects Wyandotte, MI 48192 734.250.4032


Thomas Roberts Architects Thomas Roberts Architects Thomas Roberts Architects

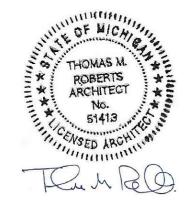

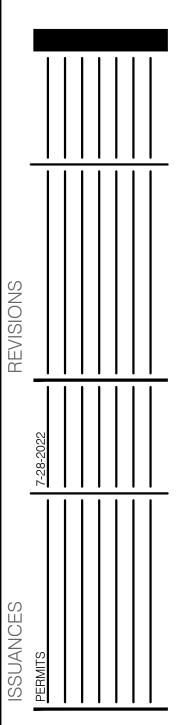

Mariners Church (Site Lighting
170 E. Jefferson Ave.
Detroit, MI 48226

principal in charge project manager project architect 07.28.2022

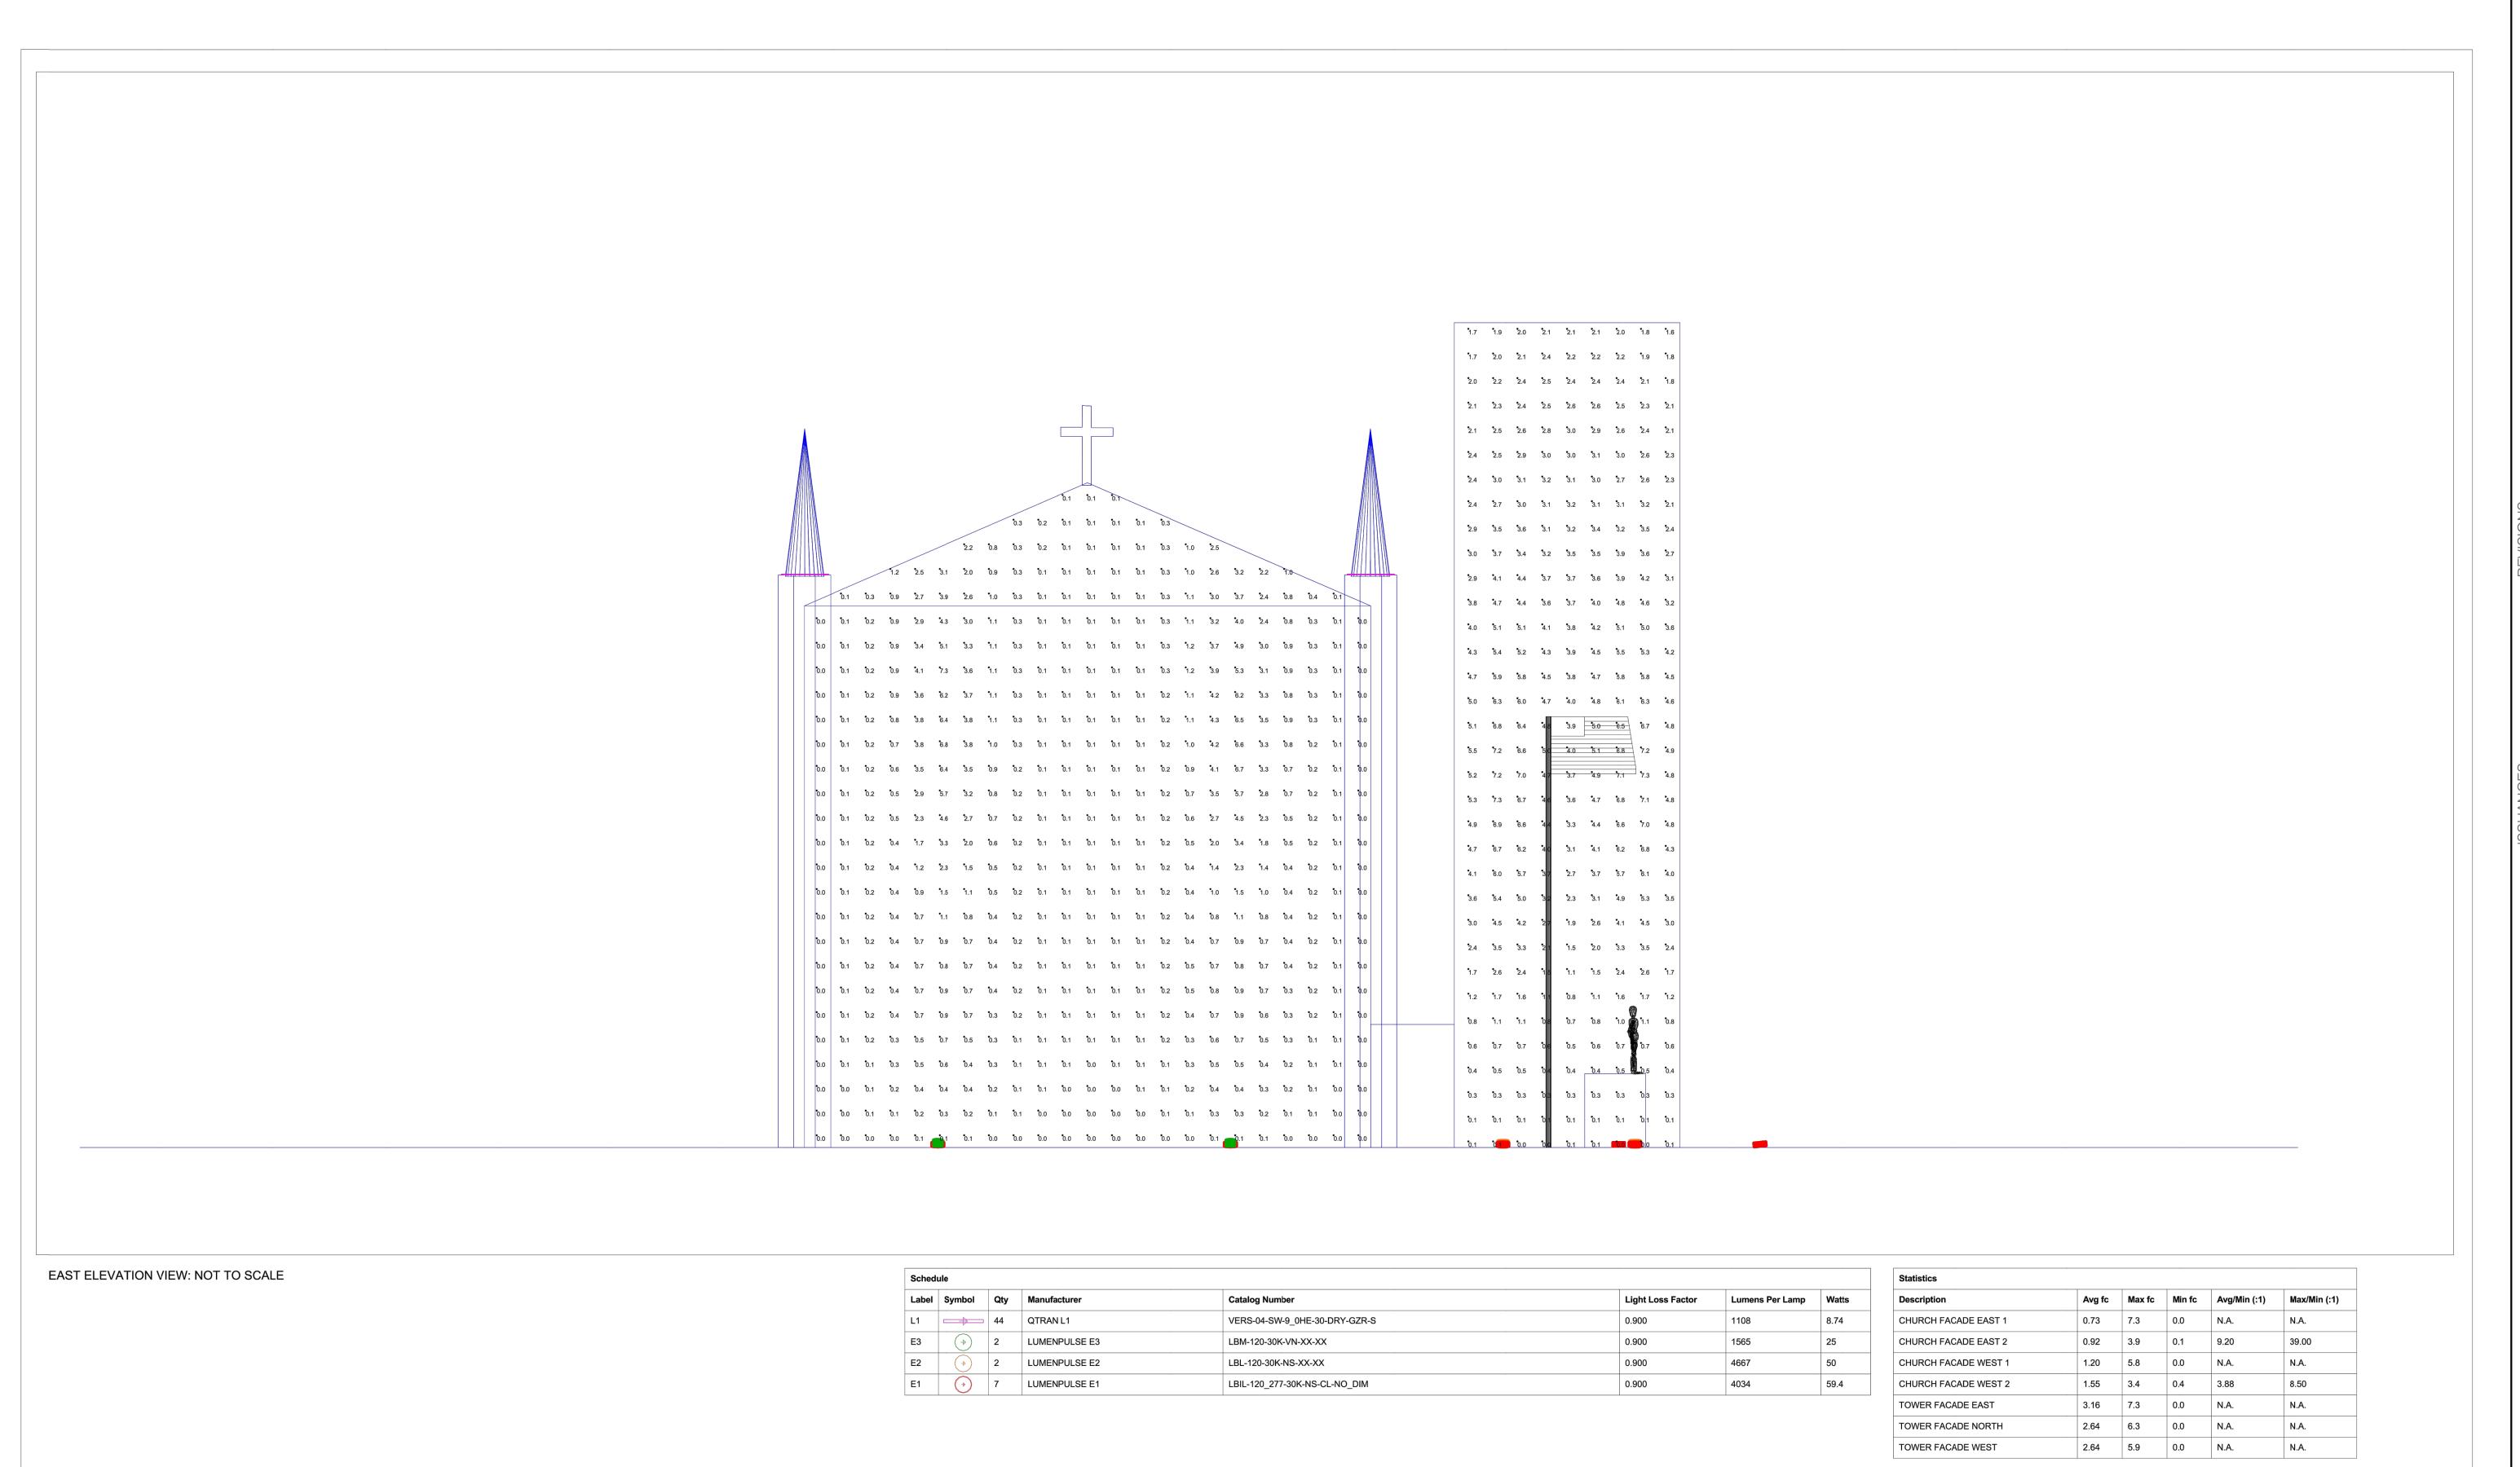

1. SEE SCHEDULE FOR LUMINAIRE MOUNTING HEIGHT.

2. CALCULATIONS ARE SHOWN IN FOOTCANDLES AT: 0' - 0", FOOD SERVICE AREA AT: 2' - 6", TREES SHOWN AT BOTTOM OF LEAVES

3. LIGHTING ALTERNATES REQUIRE NEW PHOTOMETRIC CALCULATION AND RESUBMISSION TO CITY FOR APPROVAL.

- THE ENGINEER AND/OR ARCHITECT MUST DETERMINE APPLICABILITY OF THE LAYOUT TO EXISTING / FUTURE FIELD CONDITIONS. THIS LIGHTING LAYOUT REPRESENTS ILLUMINATION LEVELS CALCULATED FROM LABORATORY DATA TAKEN UNDER CONTROLLED CONDITIONS IN ACCORDANCE WITH ILLUMINATING ENGINEERING SOCIETY APPROVED METHODS. ACTUAL PERFORMANCE OF ANY MANUFACTURER'S LUMINAIRE MAY VARY DUE TO VARIATION IN ELECTRICAL VOLTAGE, TOLERANCE IN LAMPS, AND OTHER VARIABLE FIELD CONDITIONS. MOUNTING HEIGHTS INDICATED ARE FROM GRADE AND/OR FLOOR UP.

THESE LIGHTING CALCULATIONS ARE NOT A SUBSTITUTE FOR INDEPENDENT ENGINEERING ANALYSIS OF LIGHTING SYSTEM SUITABILITY AND SAFETY. THE ENGINEER AND/OR ARCHITECT IS RESPONSIBLE TO REVIEW FOR MICHIGAN ENERGY CODE AND LIGHTING QUALITY COMPLIANCE.

- UNLESS EXEMPT, PROJECT MUST COMPLY WITH LIGHTING CONTROLS REQUIRMENTS DEFINED IN ASHRAE 90.1 2013. FOR SPECIFIC INFORMATION CONTACT GBA CONTROLS GROUP AT ASG@GASSERBUSH.COM OR 734-266-6705. FOR ORDERING INQUIRIES CONTACT GASSER BUSH AT QUOTES@GASSERBUSH.COM OR 734-266-6705.

- THIS DRAWING WAS GENERATED FROM AN ELECTRONIC IMAGE FOR ESTIMATION PURPOSE ONLY, LAYOUT TO BE VERIFIED IN FIELD BY OTHERS. - MOUNTING HEIGHT IS MEASURED FROM GRADE TO FACE OF FIXTURE. POLE HEIGHT SHOULD BE CALCULATED AS THE MOUNTING HEIGHT LESS BASE HEIGHT. Mariners Church Detroit\_V4 #22-76390.AGI

Gasser Bush Associates / Applications

www.gasserbush.com


Designer: JC3 Date:6/9/2022


Scale: NOT TO SCALE



Thomas Roberts Architects Thomas Roberts Architects Thomas Roberts Architects Wyandotte, MI 48192 734.250.4032 THOMAS M.


Thomas Roberts Architects Thomas Roberts Architects Thomas Roberts Architects

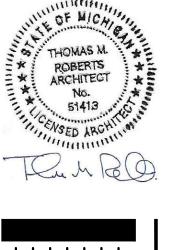

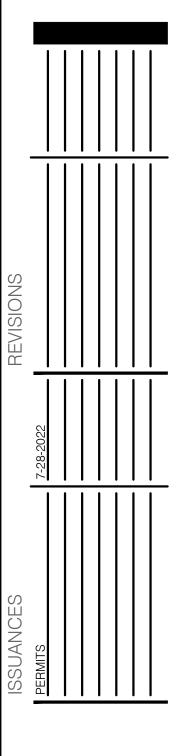

Mariners Church (Site Lighting 170 E. Jefferson Ave.

principal in charge project manager project architect 07.28.2022

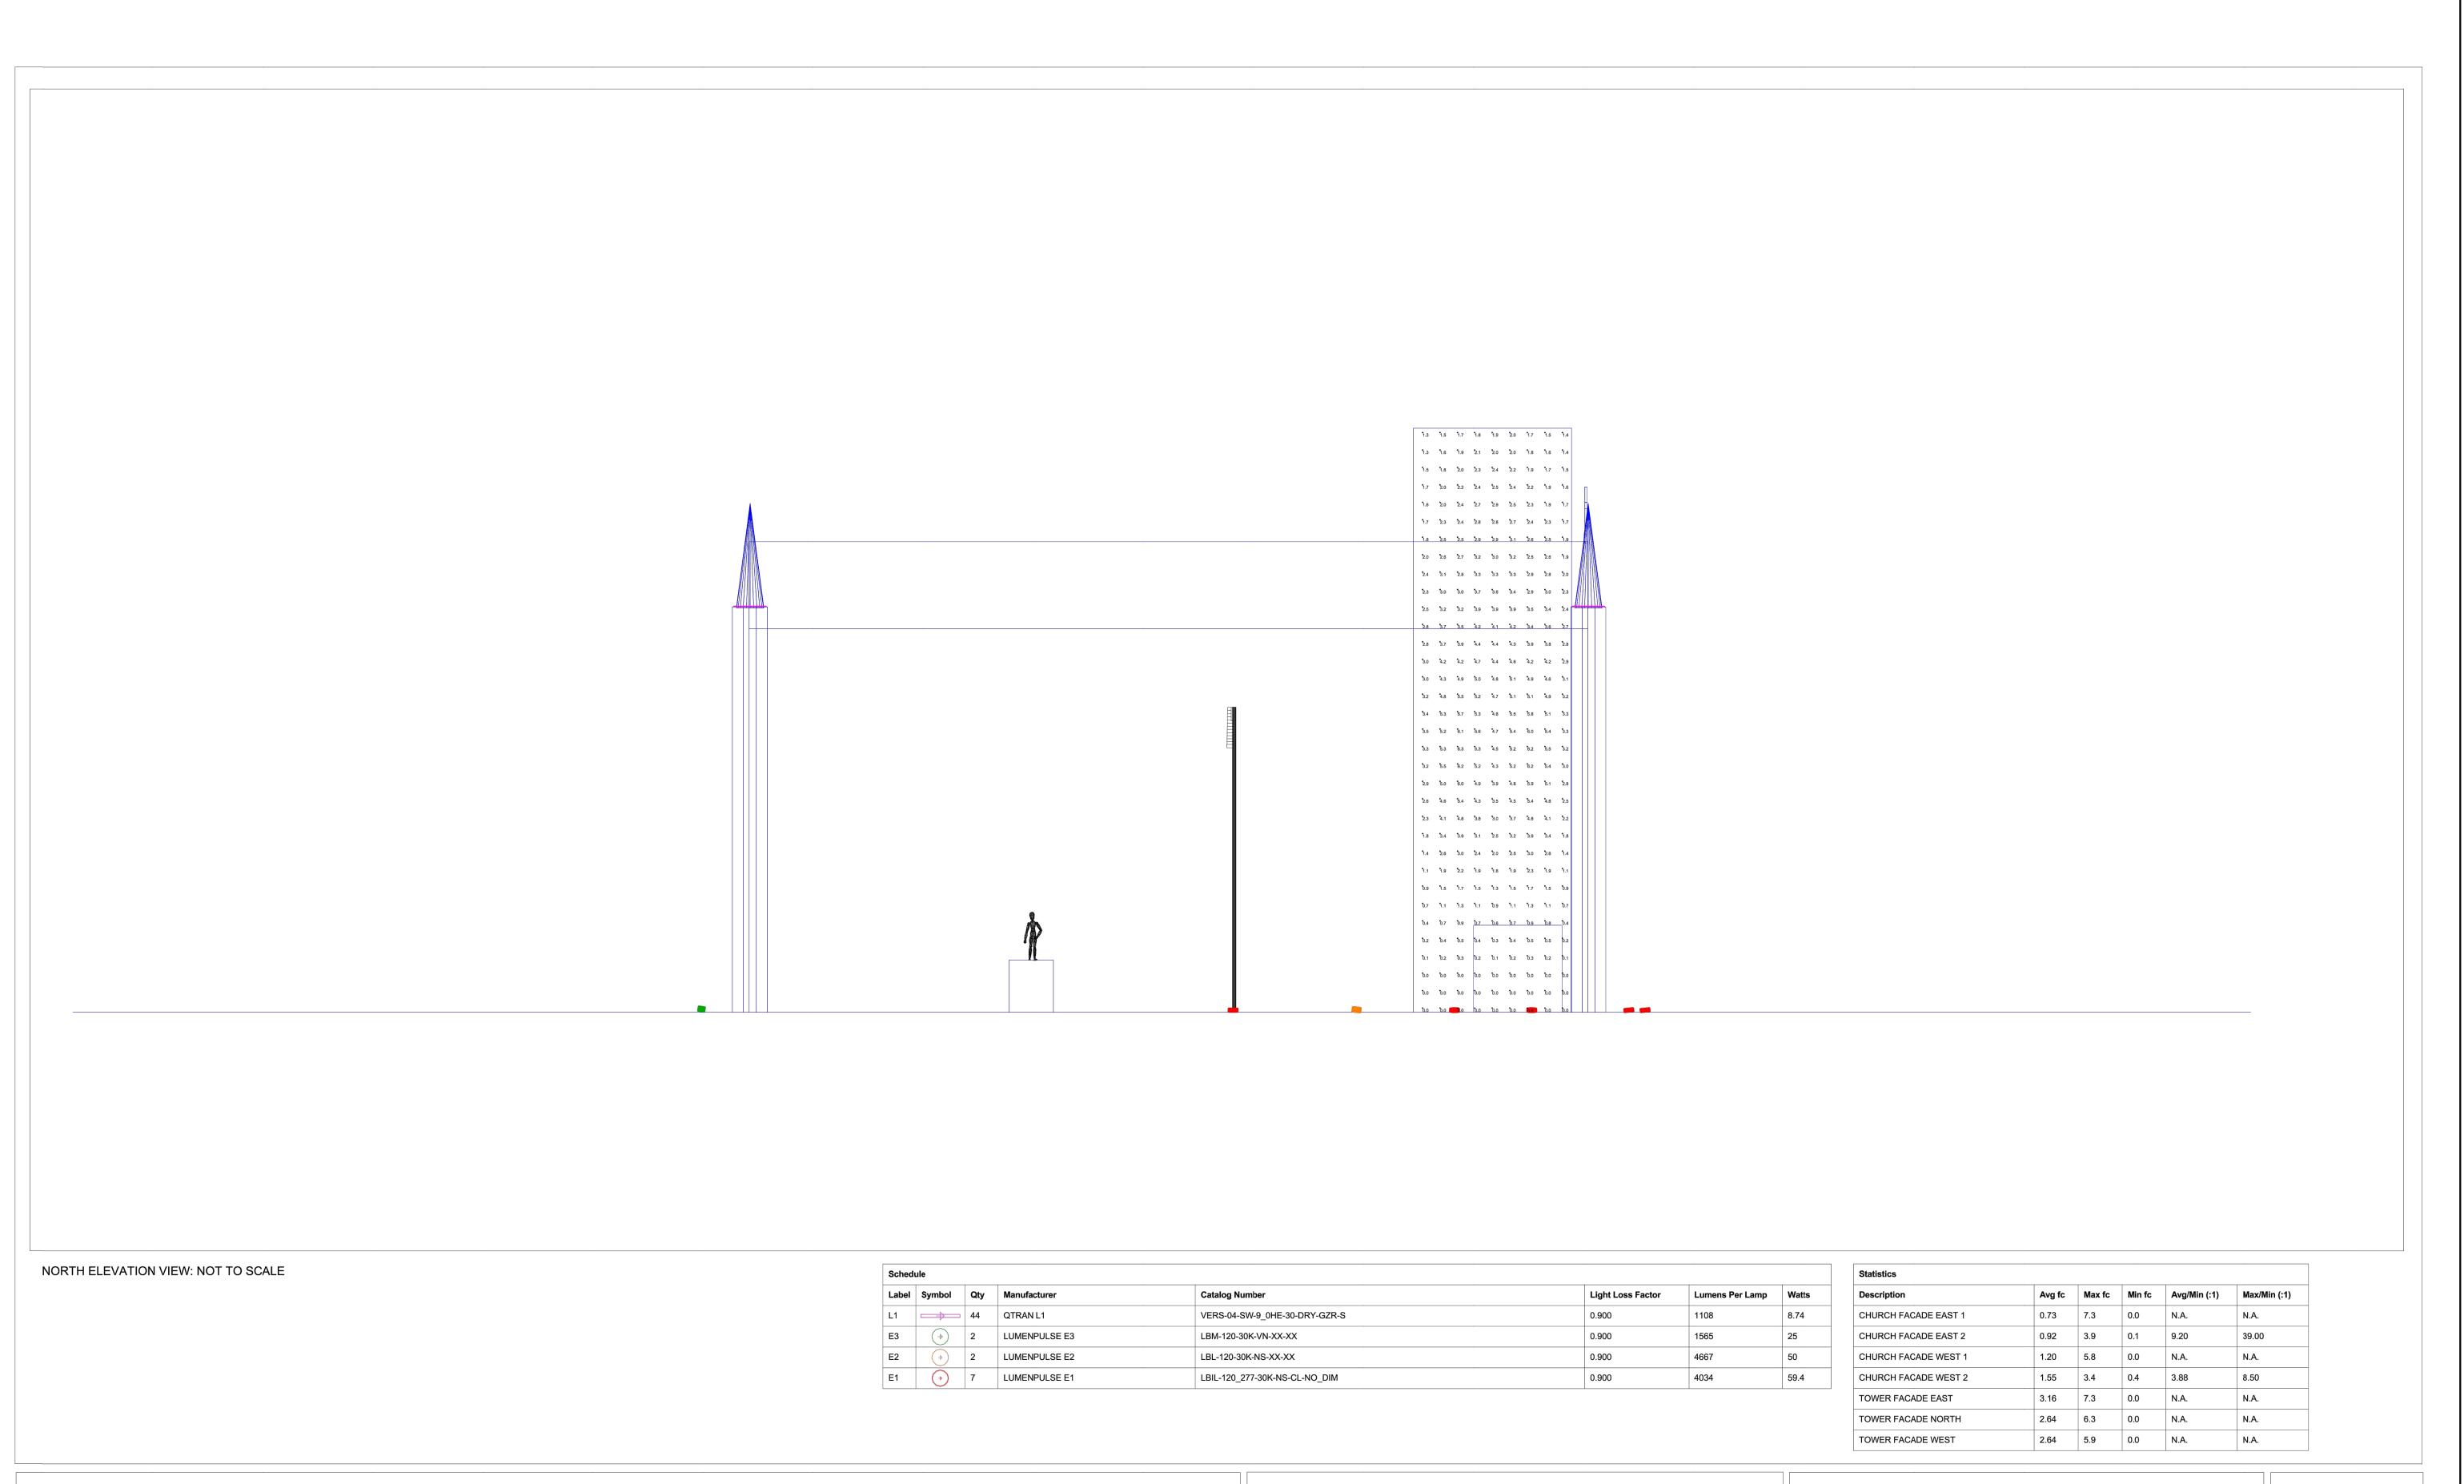

Mariners Church of Site Lighting
170 E. Jefferson Ave.
Detroit, MI 48226

Detroit

Of

principal in charge project manager project architect 07.28.2022

1. SEE SCHEDULE FOR LUMINAIRE MOUNTING HEIGHT.

2. CALCULATIONS ARE SHOWN IN FOOTCANDLES AT: 0' - 0", FOOD SERVICE AREA AT: 2' - 6", TREES SHOWN AT BOTTOM OF LEAVES

3. LIGHTING ALTERNATES REQUIRE NEW PHOTOMETRIC CALCULATION AND RESUBMISSION TO CITY FOR APPROVAL.

- THE ENGINEER AND/OR ARCHITECT MUST DETERMINE APPLICABILITY OF THE LAYOUT TO EXISTING / FUTURE FIELD CONDITIONS. THIS LIGHTING LAYOUT REPRESENTS ILLUMINATION LEVELS CALCULATED FROM LABORATORY DATA TAKEN UNDER CONTROLLED CONDITIONS IN ACCORDANCE WITH ILLUMINATING ENGINEERING SOCIETY APPROVED METHODS.

ACTUAL PERFORMANCE OF ANY MANUFACTURER'S LUMINAIRE MAY VARY DUE TO VARIATION IN ELECTRICAL VOLTAGE, TOLERANCE IN LAMPS, AND OTHER VARIABLE FIELD CONDITIONS. MOUNTING HEIGHTS INDICATED ARE FROM GRADE AND/OR FLOOR UP.

THESE LIGHTING CALCULATIONS ARE NOT A SUBSTITUTE FOR INDEPENDENT ENGINEERING ANALYSIS OF LIGHTING SYSTEM SUITABILITY AND SAFETY. THE ENGINEER AND/OR ARCHITECT IS RESPONSIBLE TO REVIEW FOR MICHIGAN ENERGY CODE AND LIGHTING QUALITY COMPLIANCE.

- UNLESS EXEMPT, PROJECT MUST COMPLY WITH LIGHTING CONTROLS REQUIRMENTS DEFINED IN ASHRAE 90.1 2013. FOR SPECIFIC INFORMATION CONTACT GBA CONTROLS GROUP AT ASG@GASSERBUSH.COM OR 734-266-6705. - FOR ORDERING INQUIRIES CONTACT GASSER BUSH AT QUOTES@GASSERBUSH.COM OR 734-266-6705.
- THIS DRAWING WAS GENERATED FROM AN ELECTRONIC IMAGE FOR ESTIMATION PURPOSE ONLY. LAYOUT TO BE VERIFIED IN FIELD BY OTHERS.

- MOUNTING HEIGHT IS MEASURED FROM GRADE TO FACE OF FIXTURE. POLE HEIGHT SHOULD BE CALCULATED AS THE MOUNTING HEIGHT LESS BASE HEIGHT.


Mariners Church Detroit\_V4 #22-76390.AGI

Gasser Bush Associates / Applications

www.gasserbush.com

Designer: JC3 Date:6/9/2022

Scale: NOT TO SCALE

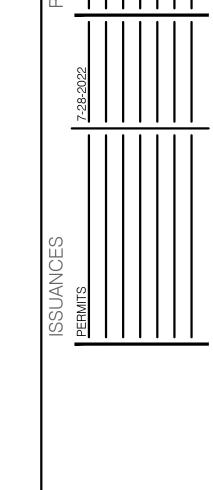

Thomas Roberts Architects Thomas Roberts Architects

Wyandotte, MI 48192

734.250.4032



ISOMETRIC VIEWS: CONTRAST & PSEUDO COLOR

1. SEE SCHEDULE FOR LUMINAIRE MOUNTING HEIGHT.
2. CALCULATIONS ARE SHOWN IN FOOTCANDLES AT: 0' - 0", FOOD SERVICE AREA AT: 2' - 6", TREES SHOWN AT BOTTOM OF LEAVES
3. LIGHTING ALTERNATES REQUIRE NEW PHOTOMETRIC CALCULATION AND RESUBMISSION TO CITY FOR APPROVAL.

- THE ENGINEER AND/OR ARCHITECT MUST DETERMINE APPLICABILITY OF THE LAYOUT TO EXISTING / FUTURE FIELD CONDITIONS.
THIS LIGHTING LAYOUT REPRESENTS ILLUMINATION LEVELS CALCULATED FROM LABORATORY DATA TAKEN UNDER CONTROLLED CONDITIONS IN ACCORDANCE WITH ILLUMINATING ENGINEERING SOCIETY APPROVED METHODS.
ACTUAL PERFORMANCE OF ANY MANUFACTURER'S LUMINAIRE MAY VARY DUE TO VARIATION IN ELECTRICAL VOLTAGE, TOLERANCE IN LAMPS, AND OTHER VARIABLE FIELD CONDITIONS. MOUNTING HEIGHTS INDICATED ARE FROM GRADE AND/OR FLOOR UP.

- THESE LIGHTING CALCULATIONS ARE NOT A SUBSTITUTE FOR INDEPENDENT ENGINEERING ANALYSIS OF LIGHTING SYSTEM SUITABILITY AND SAFETY.

THE ENGINEER AND/OR ARCHITECT IS RESPONSIBLE TO REVIEW FOR MICHIGAN ENERGY CODE AND LIGHTING QUALITY COMPLIANCE.

- UNLESS ENEMPT, PROJECT MONTACT CONTROLS CONTROLS REQUIRENTS OF 1201 201 2013. FOR SPECIFIC INFORMATION CONTACT GBA CONTROLS GROUP AT ASG@GASSERBUSH.COM OR 734-266-6705.

- UNLESS EXEMPT, PROJECT MOST COMPLY WITH LIGHTING CONTROLS REQUIRMENTS DEFINED IN ASHRAE 90.1 2013. FOR SPECIFIC INFORMATION CONTACT GET FOR ORDERING INQUIRIES CONTACT GASSER BUSH AT QUOTES@GASSERBUSH.COM OR 734-266-6705.
 - THIS DRAWING WAS GENERATED FROM AN ELECTRONIC IMAGE FOR ESTIMATION PURPOSE ONLY. LAYOUT TO BE VERIFIED IN FIELD BY OTHERS.
 - MOUNTING HEIGHT IS MEASURED FROM GRADE TO FACE OF FIXTURE. POLE HEIGHT SHOULD BE CALCULATED AS THE MOUNTING HEIGHT LESS BASE HEIGHT.

Mariners Church Detroit\_V4 #22-76390.AGI

Gasser Bush Associates / Applications

www.gasserbush.com

Designer: JC3 Date:6/9/2022

Scale: NOT TO SCALE




Thomas Roberts Architects Thomas Roberts Architects

Wyandotte, MI 48192

734.250.4032

of Detroit Mariners Church C Site Lighting 170 E. Jefferson Ave. Detroit, MI 48226

principal in charge project manager project architect 07.28.2022

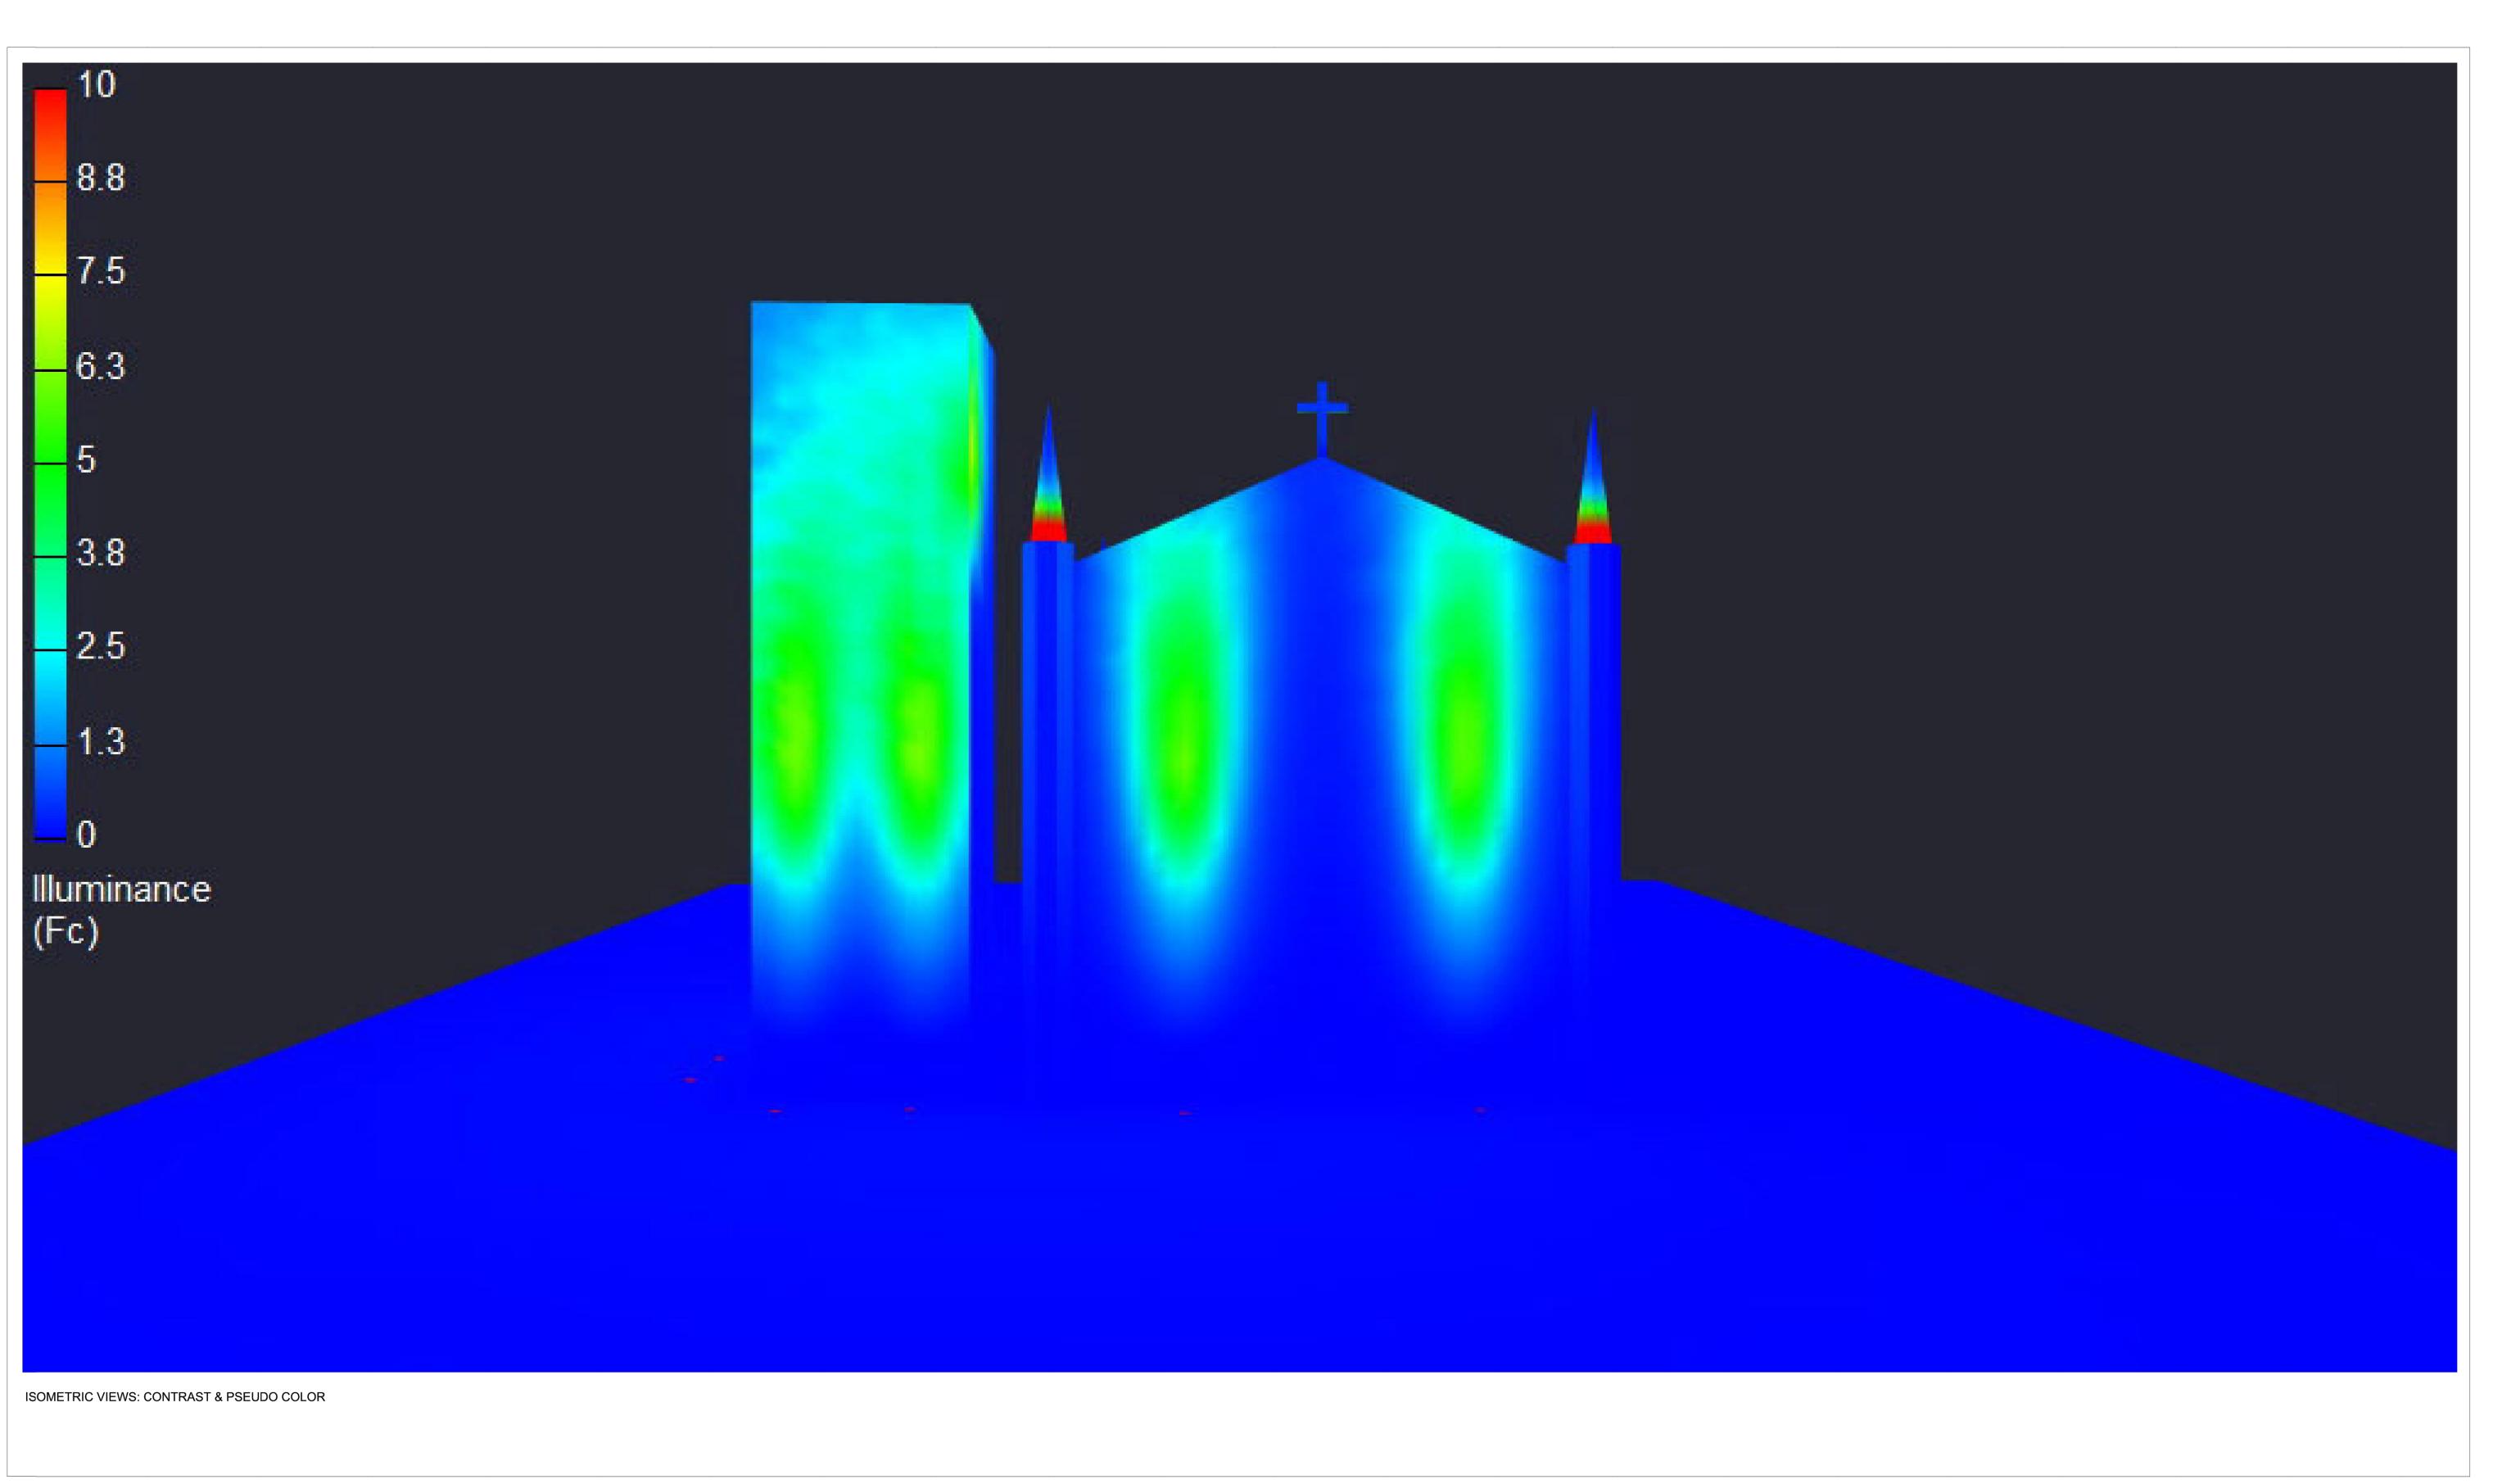

1. SEE SCHEDULE FOR LUMINAIRE MOUNTING HEIGHT.
2. CALCULATIONS ARE SHOWN IN FOOTCANDLES AT: 0' - 0", FOOD SERVICE AREA AT: 2' - 6", TREES SHOWN AT BOTTOM OF LEAVES
3. LIGHTING ALTERNATES REQUIRE NEW PHOTOMETRIC CALCULATION AND RESUBMISSION TO CITY FOR APPROVAL.

- THE ENGINEER AND/OR ARCHITECT MUST DETERMINE APPLICABILITY OF THE LAYOUT TO EXISTING / FUTURE FIELD CONDITIONS.
THIS LIGHTING LAYOUT REPRESENTS ILLUMINATION LEVELS CALCULATED FROM LABORATORY DATA TAKEN UNDER CONTROLLED CONDITIONS IN ACCORDANCE WITH ILLUMINATING ENGINEERING SOCIETY APPROVED METHODS.
ACTUAL PERFORMANCE OF ANY MANUFACTURER'S LUMINAIRE MAY VARY DUE TO VARIATION IN ELECTRICAL VOLTAGE, TOLERANCE IN LAMPS, AND OTHER VARIABLE FIELD CONDITIONS. MOUNTING HEIGHTS INDICATED ARE FROM GRADE AND/OR FLOOR UP.

- THESE LIGHTING CALCULATIONS ARE NOT A SUBSTITUTE FOR INDEPENDENT ENGINEERING ANALYSIS OF LIGHTING SYSTEM SUITABILITY AND SAFETY.

THE ENGINEER AND/OR ARCHITECT IS RESPONSIBLE TO REVIEW FOR MICHIGAN ENERGY CODE AND LIGHTING QUALITY COMPLIANCE.

- UNLESS ENEMPT, PROJECT MONTACT CONTROLS CONTROLS REQUIRENTS OF 1201 201 2013. FOR SPECIFIC INFORMATION CONTACT GBA CONTROLS GROUP AT ASG@GASSERBUSH.COM OR 734-266-6705.

- UNLESS EXEMPT, PROJECT MOST COMPLY WITH LIGHTING CONTROLS REQUIRMENTS DEFINED IN ASHRAE 90.1 2013. FOR SPECIFIC INFORMATION CONTACT GET FOR ORDERING INQUIRIES CONTACT GASSER BUSH AT QUOTES@GASSERBUSH.COM OR 734-266-6705.
 - THIS DRAWING WAS GENERATED FROM AN ELECTRONIC IMAGE FOR ESTIMATION PURPOSE ONLY. LAYOUT TO BE VERIFIED IN FIELD BY OTHERS.
 - MOUNTING HEIGHT IS MEASURED FROM GRADE TO FACE OF FIXTURE. POLE HEIGHT SHOULD BE CALCULATED AS THE MOUNTING HEIGHT LESS BASE HEIGHT.

Mariners Church Detroit\_V4 #22-76390.AGI

Gasser Bush Associates / Applications

www.gasserbush.com


Designer: JC3 Date:6/9/2022

Scale: NOT TO SCALE





Thomas Roberts Architects Thomas Roberts Architects

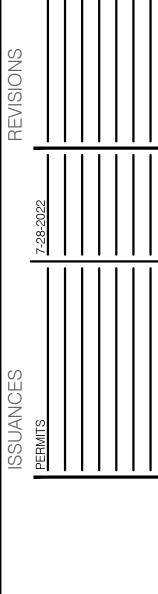


of Detroit Mariners Church C Site Lighting 170 E. Jefferson Ave. Detroit, MI 48226

principal in charge project manager project architect

07.28.2022

22010.00 job number

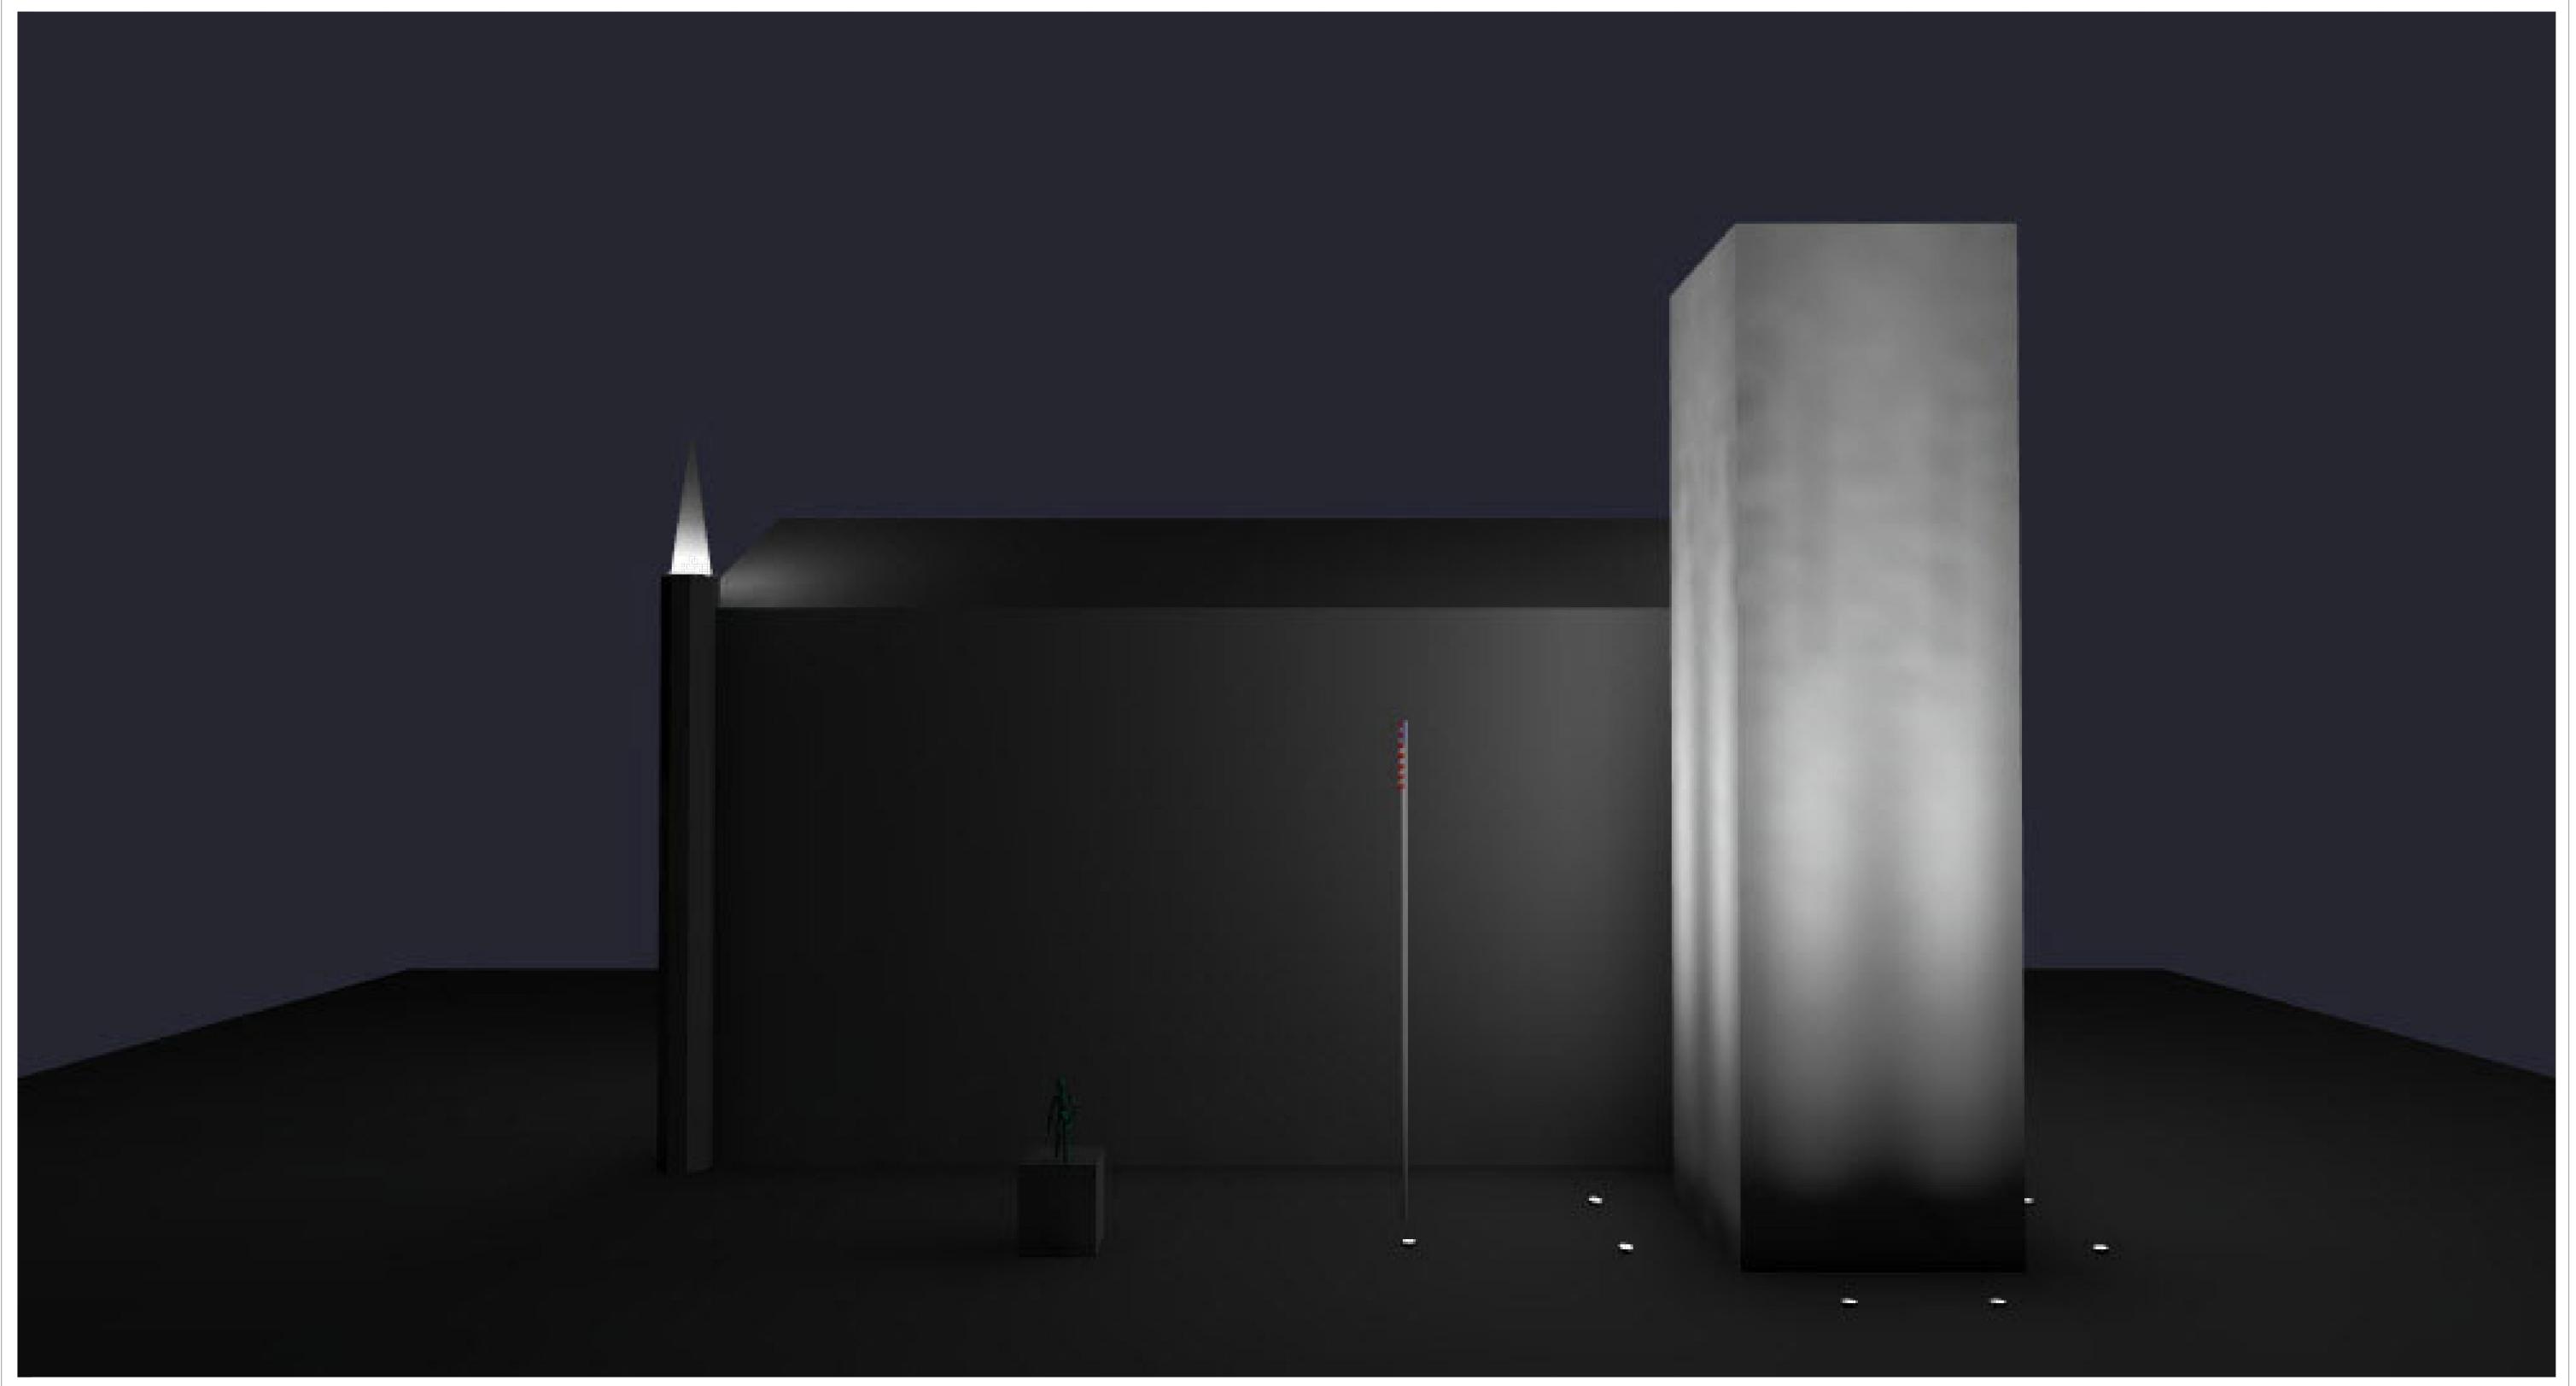

ISOMETRIC VIEWS: CONTRAST & PSEUDO COLOR

1. SEE SCHEDULE FOR LUMINAIRE MOUNTING HEIGHT.
2. CALCULATIONS ARE SHOWN IN FOOTCANDLES AT: 0' - 0", FOOD SERVICE AREA AT: 2' - 6", TREES SHOWN AT BOTTOM OF LEAVES
3. LIGHTING ALTERNATES REQUIRE NEW PHOTOMETRIC CALCULATION AND RESUBMISSION TO CITY FOR APPROVAL.

- THE ENGINEER AND/OR ARCHITECT MUST DETERMINE APPLICABILITY OF THE LAYOUT TO EXISTING / FUTURE FIELD CONDITIONS.
THIS LIGHTING LAYOUT REPRESENTS ILLUMINATION LEVELS CALCULATED FROM LABORATORY DATA TAKEN UNDER CONTROLLED CONDITIONS IN ACCORDANCE WITH ILLUMINATING ENGINEERING SOCIETY APPROVED METHODS.
ACTUAL PERFORMANCE OF ANY MANUFACTURER'S LUMINAIRE MAY VARY DUE TO VARIATION IN ELECTRICAL VOLTAGE, TOLERANCE IN LAMPS, AND OTHER VARIABLE FIELD CONDITIONS. MOUNTING HEIGHTS INDICATED ARE FROM GRADE AND/OR FLOOR UP.

- THESE LIGHTING CALCULATIONS ARE NOT A SUBSTITUTE FOR INDEPENDENT ENGINEERING ANALYSIS OF LIGHTING SYSTEM SUITABILITY AND SAFETY.

THE ENGINEER AND/OR ARCHITECT IS RESPONSIBLE TO REVIEW FOR MICHIGAN ENERGY CODE AND LIGHTING QUALITY COMPLIANCE.

- UNLESS ENEMPT, PROJECT MONTACT CONTROLS CONTROLS REQUIRENTS OF 1201 201 2013. FOR SPECIFIC INFORMATION CONTACT GBA CONTROLS GROUP AT ASG@GASSERBUSH.COM OR 734-266-6705.

- UNLESS EXEMPT, PROJECT MOST COMPLY WITH LIGHTING CONTROLS REQUIRMENTS DEFINED IN ASHRAE 90.1 2013. FOR SPECIFIC INFORMATION CONTACT GET FOR ORDERING INQUIRIES CONTACT GASSER BUSH AT QUOTES@GASSERBUSH.COM OR 734-266-6705.
 - THIS DRAWING WAS GENERATED FROM AN ELECTRONIC IMAGE FOR ESTIMATION PURPOSE ONLY. LAYOUT TO BE VERIFIED IN FIELD BY OTHERS.
 - MOUNTING HEIGHT IS MEASURED FROM GRADE TO FACE OF FIXTURE. POLE HEIGHT SHOULD BE CALCULATED AS THE MOUNTING HEIGHT LESS BASE HEIGHT.

Mariners Church Detroit\_V4 #22-76390.AGI

Gasser Bush Associates / Applications

www.gasserbush.com

Designer: JC3 Date:6/9/2022

Scale: NOT TO SCALE






Thomas Roberts Architects Thomas Roberts Architects

of Detroit Mariners Church C Site Lighting 170 E. Jefferson Ave. Detroit, MI 48226

principal in charge project manager project architect 07.28.2022

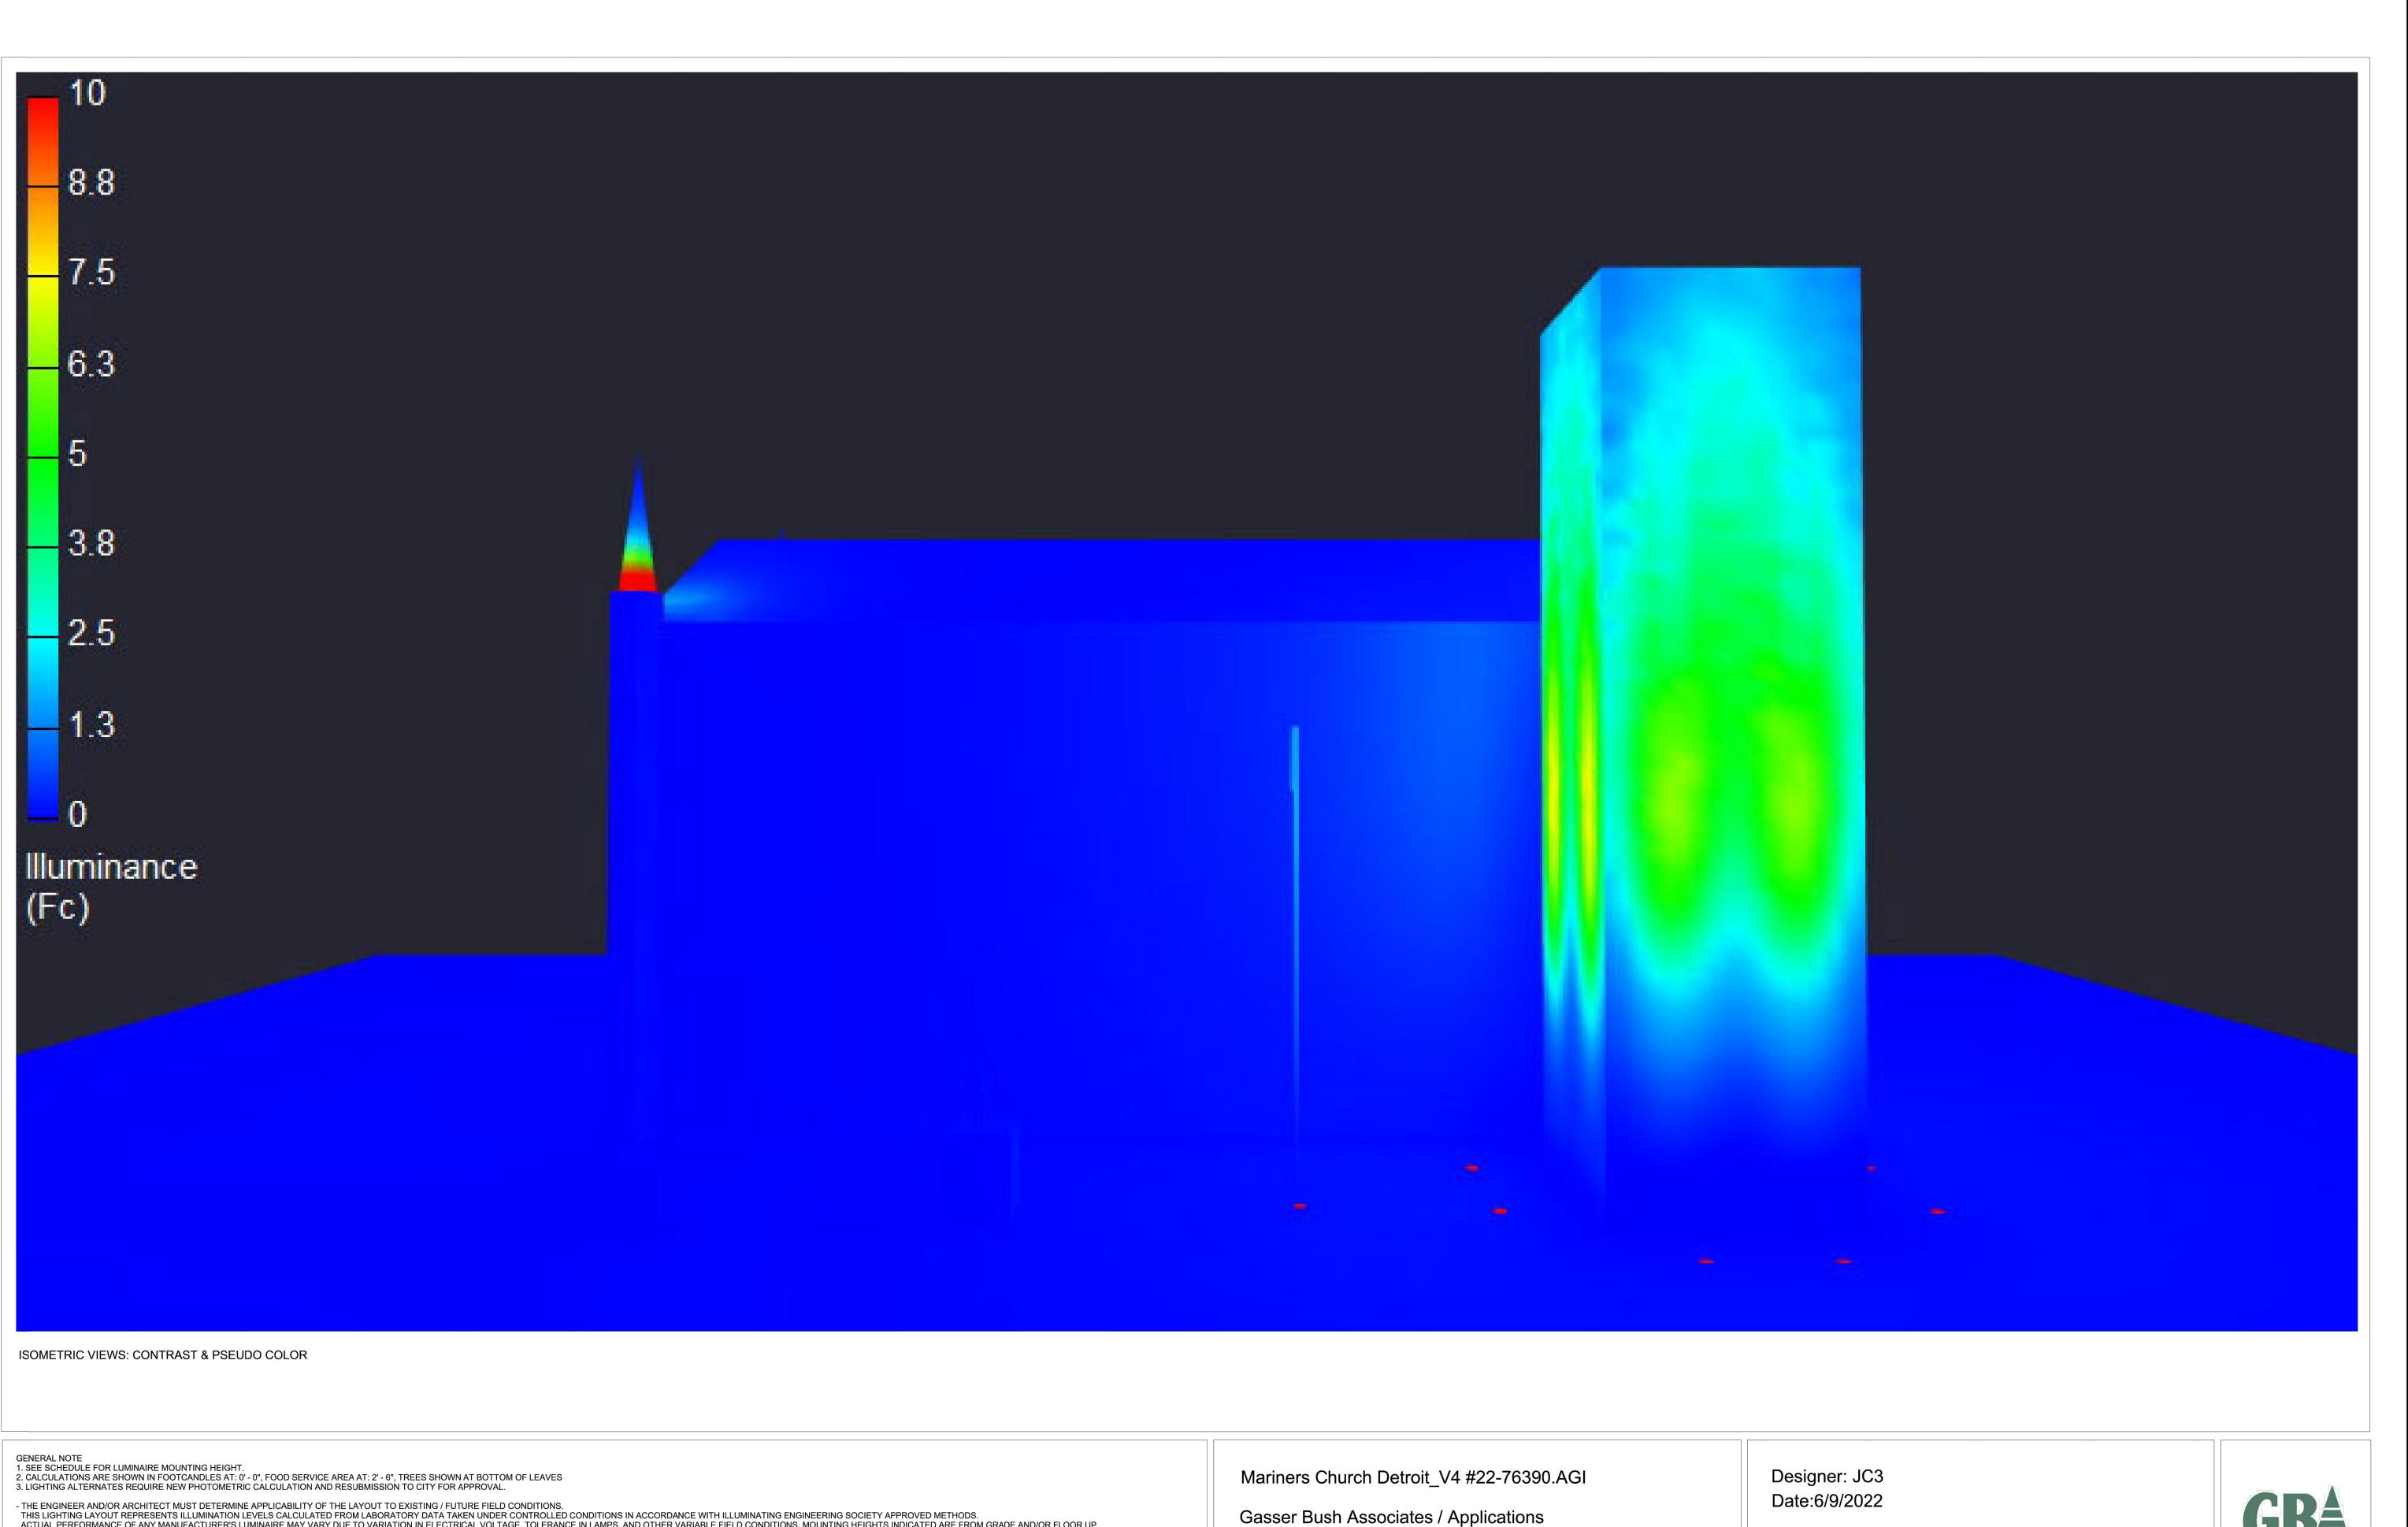

www.gasserbush.com

ACTUAL PERFORMANCE OF ANY MANUFACTURER'S LUMINAIRE MAY VARY DUE TO VARIATION IN ELECTRICAL VOLTAGE, TOLERANCE IN LAMPS, AND OTHER VARIABLE FIELD CONDITIONS. MOUNTING HEIGHTS INDICATED ARE FROM GRADE AND/OR FLOOR UP.

- THESE LIGHTING CALCULATIONS ARE NOT A SUBSTITUTE FOR INDEPENDENT ENGINEERING ANALYSIS OF LIGHTING SYSTEM SUITABILITY AND SAFETY.

THE ENGINEER AND/OR ARCHITECT IS RESPONSIBLE TO REVIEW FOR MICHIGAN ENERGY CODE AND LIGHTING QUALITY COMPLIANCE.

- UNLESS ENEMPT, PROJECT MONTACT CONTROLS CONTROLS REQUIRENTS OF 1201 201 2013. FOR SPECIFIC INFORMATION CONTACT GBA CONTROLS GROUP AT ASG@GASSERBUSH.COM OR 734-266-6705.

- UNLESS EXEMPT, PROJECT MOST COMPLY WITH LIGHTING CONTROLS REQUIRMENTS DEFINED IN ASHRAE 90.1 2013. FOR SPECIFIC INFORMATION CONTACT GET FOR ORDERING INQUIRIES CONTACT GASSER BUSH AT QUOTES@GASSERBUSH.COM OR 734-266-6705.
 - THIS DRAWING WAS GENERATED FROM AN ELECTRONIC IMAGE FOR ESTIMATION PURPOSE ONLY. LAYOUT TO BE VERIFIED IN FIELD BY OTHERS.
 - MOUNTING HEIGHT IS MEASURED FROM GRADE TO FACE OF FIXTURE. POLE HEIGHT SHOULD BE CALCULATED AS THE MOUNTING HEIGHT LESS BASE HEIGHT.

2927 4th Street Wyandotte, MI 48192 thomasrobertsarchitect.com 734.250.4032


Thomas Roberts Architects Thomas Roberts Architects

of Detroit Mariners Church C Site Lighting 170 E. Jefferson Ave. Detroit, MI 48226

principal in charge project manager project architect 07.28.2022

22010.00 job number

Scale: NOT TO SCALE

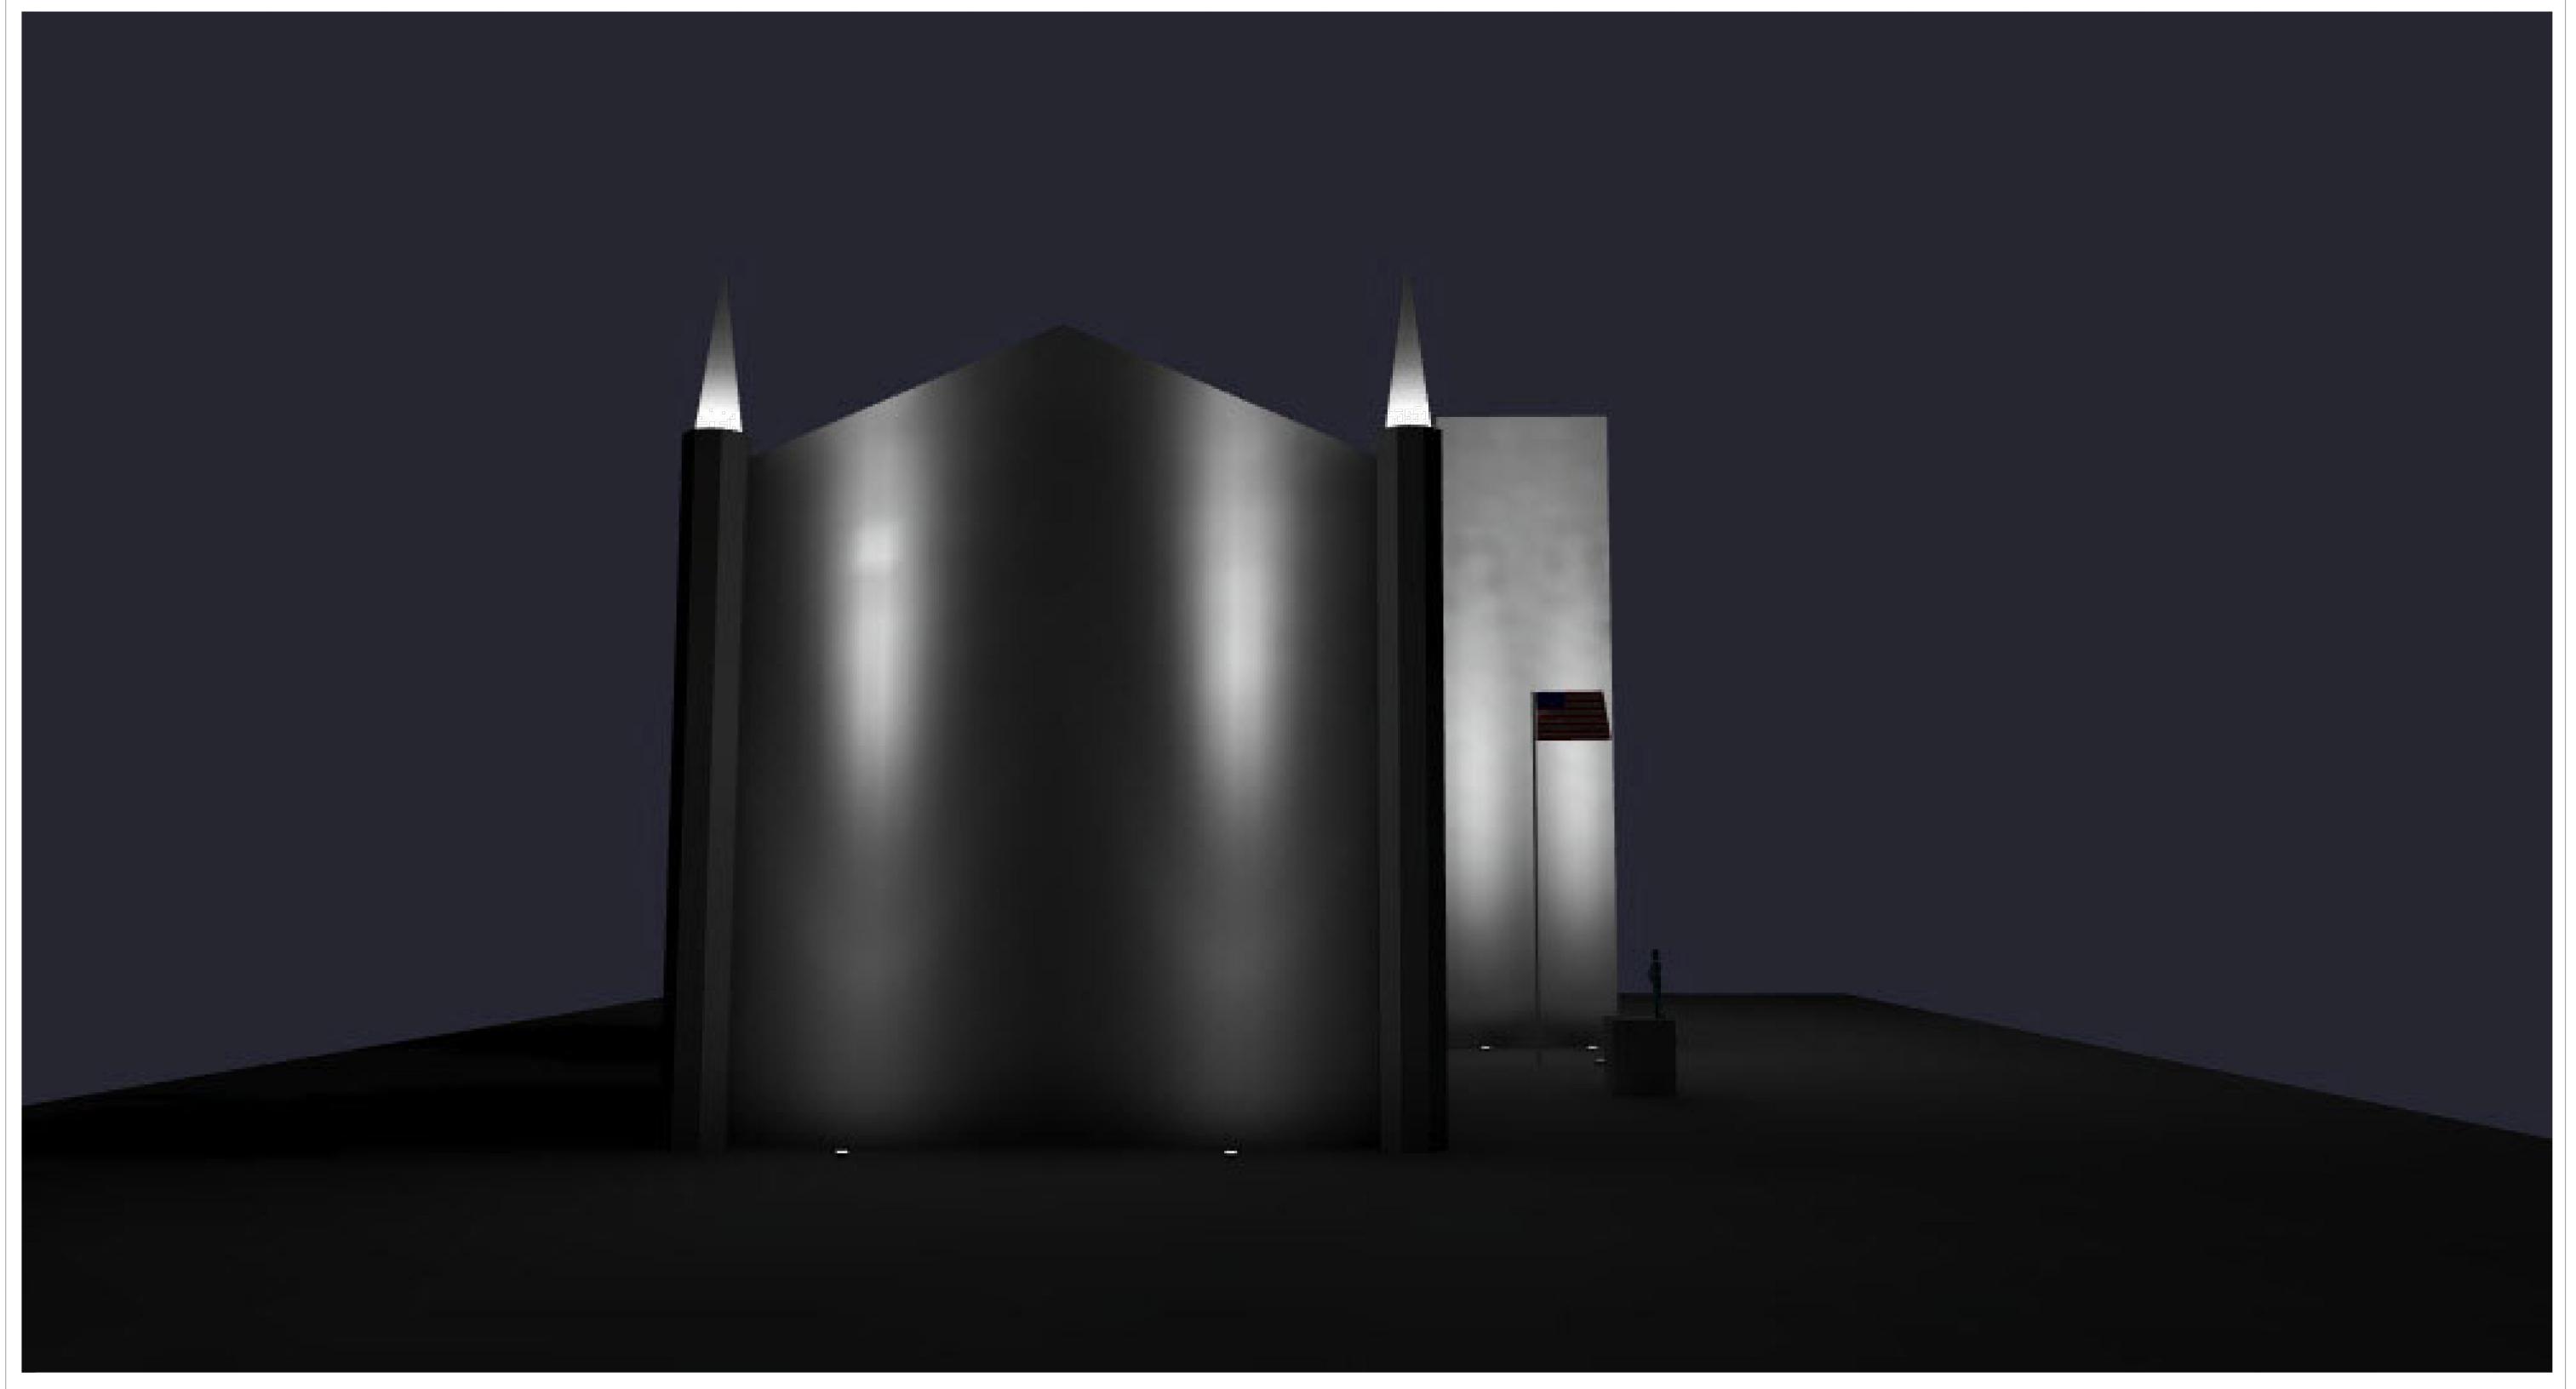

ISOMETRIC VIEWS: CONTRAST & PSEUDO COLOR

GENERAL NOTE

1. SEE SCHEDULE FOR LUMINAIRE MOUNTING HEIGHT.
2. CALCULATIONS ARE SHOWN IN FOOTCANDLES AT: 0' - 0", FOOD SERVICE AREA AT: 2' - 6", TREES SHOWN AT BOTTOM OF LEAVES
3. LIGHTING ALTERNATES REQUIRE NEW PHOTOMETRIC CALCULATION AND RESUBMISSION TO CITY FOR APPROVAL.

- THE ENGINEER AND/OR ARCHITECT MUST DETERMINE APPLICABILITY OF THE LAYOUT TO EXISTING / FUTURE FIELD CONDITIONS.
THIS LIGHTING LAYOUT REPRESENTS ILLUMINATION LEVELS CALCULATED FROM LABORATORY DATA TAKEN UNDER CONTROLLED CONDITIONS IN ACCORDANCE WITH ILLUMINATING ENGINEERING SOCIETY APPROVED METHODS.
ACTUAL PERFORMANCE OF ANY MANUFACTURER'S LUMINAIRE MAY VARY DUE TO VARIATION IN ELECTRICAL VOLTAGE, TOLERANCE IN LAMPS, AND OTHER VARIABLE FIELD CONDITIONS. MOUNTING HEIGHTS INDICATED ARE FROM GRADE AND/OR FLOOR UP.

- THESE LIGHTING CALCULATIONS ARE NOT A SUBSTITUTE FOR INDEPENDENT ENGINEERING ANALYSIS OF LIGHTING SYSTEM SUITABILITY AND SAFETY.
THE ENGINEER AND/OR ARCHITECT IS RESPONSIBLE TO REVIEW FOR MICHIGAN ENERGY CODE AND LIGHTING QUALITY COMPLIANCE.
- UNLESS EXEMPT, PROJECT MUST COMPLY WITH LIGHTING CONTROLS REQUIRMENTS DEFINED IN ASSERBE 90.1 2013. FOR SPECIFIC INFORMATION CONTACT GBA CONTROLS GROUP AT ASG@GASSERBUSH.COM OR 734-266-6705.

- UNLESS EXEMPT, PROJECT MOST COMPLY WITH LIGHTING CONTROLS REQUIRMENTS DEFINED IN ASHRAE 90.1 2013. FOR SPECIFIC INFORMATION CONTACT GET FOR ORDERING INQUIRIES CONTACT GASSER BUSH AT QUOTES@GASSERBUSH.COM OR 734-266-6705.
 - THIS DRAWING WAS GENERATED FROM AN ELECTRONIC IMAGE FOR ESTIMATION PURPOSE ONLY. LAYOUT TO BE VERIFIED IN FIELD BY OTHERS.
 - MOUNTING HEIGHT IS MEASURED FROM GRADE TO FACE OF FIXTURE. POLE HEIGHT SHOULD BE CALCULATED AS THE MOUNTING HEIGHT LESS BASE HEIGHT.

Mariners Church Detroit\_V4 #22-76390.AGI

Gasser Bush Associates / Applications

www.gasserbush.com

Designer: JC3 Date:6/9/2022


Scale: NOT TO SCALE



Thomas Roberts Architects Thomas Roberts Architects Thomas Roberts Architects Wyandotte, MI 48192 thomasrobertsarchitect.com 734.250.4032

Thomas Roberts Architects Thomas Roberts Architects Thomas Roberts Architects



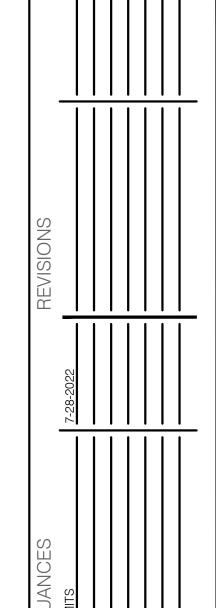


of Detroit

Mariners Church C Site Lighting 170 E. Jefferson Ave. Detroit, MI 48226

principal in charge project manager project architect 07.28.2022

22010.00 job number

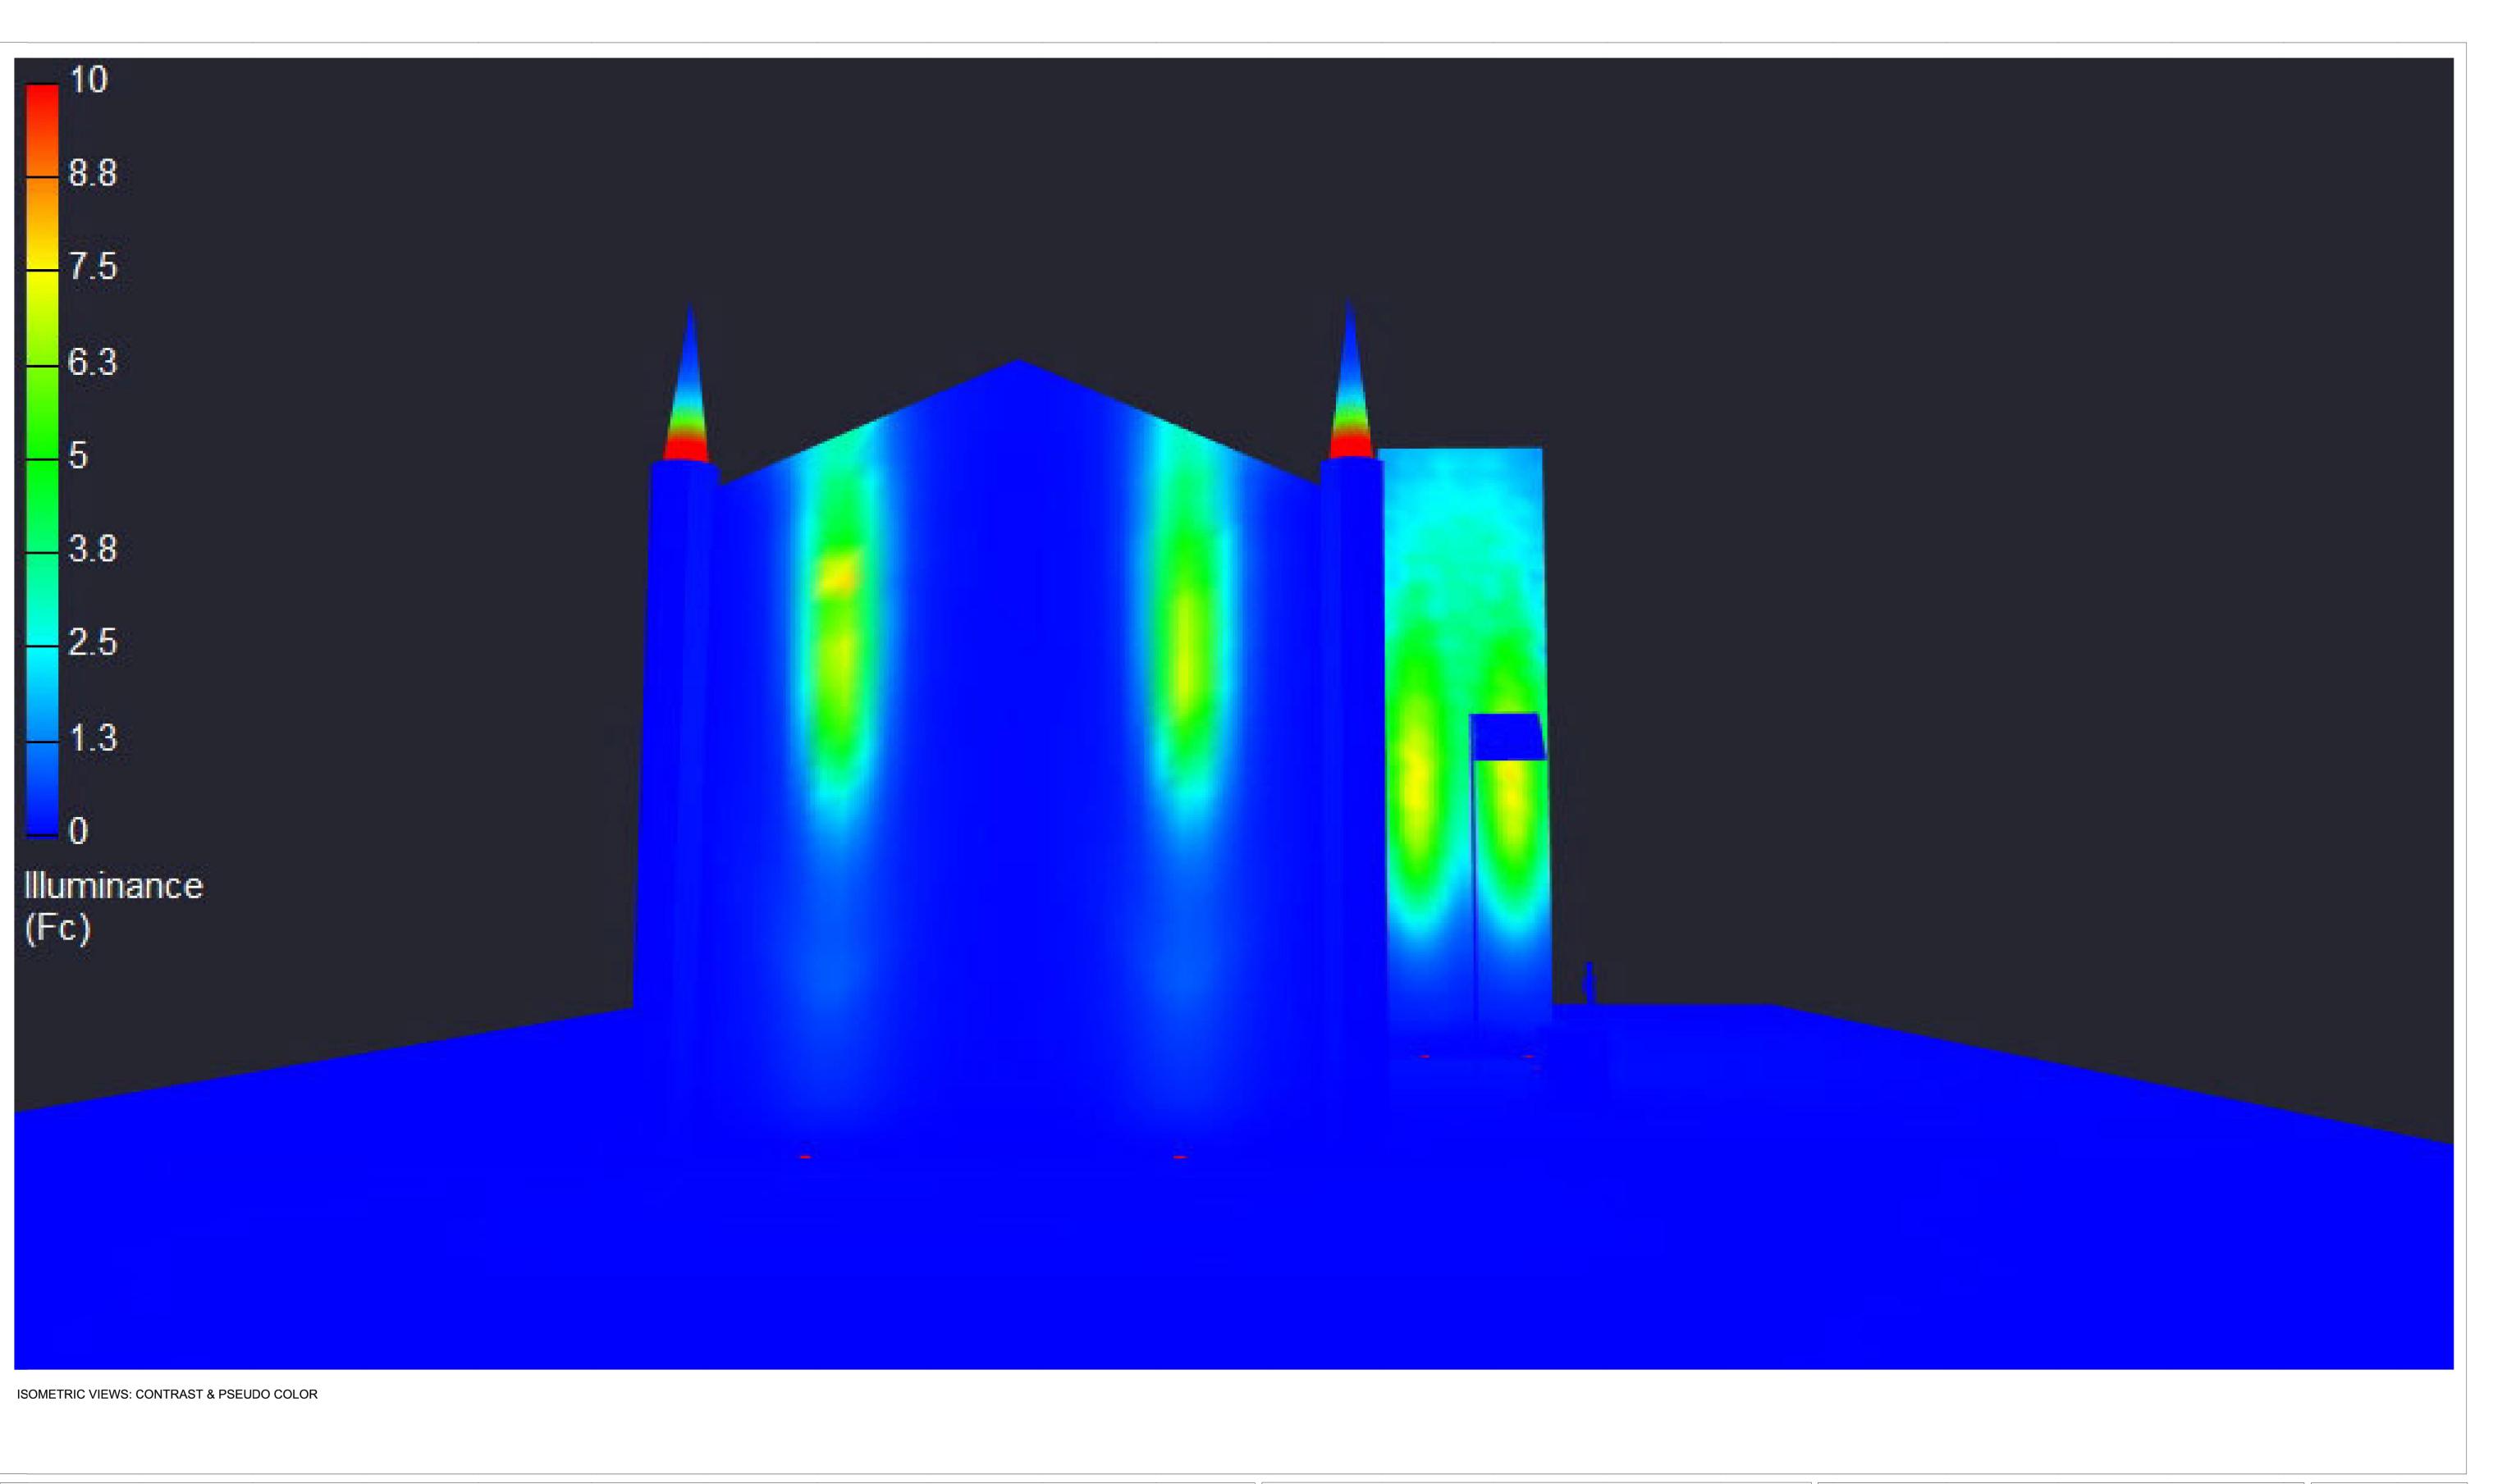

1. SEE SCHEDULE FOR LUMINAIRE MOUNTING HEIGHT.
2. CALCULATIONS ARE SHOWN IN FOOTCANDLES AT: 0' - 0", FOOD SERVICE AREA AT: 2' - 6", TREES SHOWN AT BOTTOM OF LEAVES
3. LIGHTING ALTERNATES REQUIRE NEW PHOTOMETRIC CALCULATION AND RESUBMISSION TO CITY FOR APPROVAL.

- THE ENGINEER AND/OR ARCHITECT MUST DETERMINE APPLICABILITY OF THE LAYOUT TO EXISTING / FUTURE FIELD CONDITIONS.
THIS LIGHTING LAYOUT REPRESENTS ILLUMINATION LEVELS CALCULATED FROM LABORATORY DATA TAKEN UNDER CONTROLLED CONDITIONS IN ACCORDANCE WITH ILLUMINATING ENGINEERING SOCIETY APPROVED METHODS.
ACTUAL PERFORMANCE OF ANY MANUFACTURER'S LUMINAIRE MAY VARY DUE TO VARIATION IN ELECTRICAL VOLTAGE, TOLERANCE IN LAMPS, AND OTHER VARIABLE FIELD CONDITIONS. MOUNTING HEIGHTS INDICATED ARE FROM GRADE AND/OR FLOOR UP.

- THESE LIGHTING CALCULATIONS ARE NOT A SUBSTITUTE FOR INDEPENDENT ENGINEERING ANALYSIS OF LIGHTING SYSTEM SUITABILITY AND SAFETY.
THE ENGINEER AND/OR ARCHITECT IS RESPONSIBLE TO REVIEW FOR MICHIGAN ENERGY CODE AND LIGHTING QUALITY COMPLIANCE.
- UNLESS EMPT, PROBLEM TO ANALYSIS OF THE CONTROLS REQUIRENTS OF THE CONTROLS GROUP AT ASG@GASSERBUSH.COM OR 734-266-6705.

- UNLESS EXEMP1, PROJECT MOST COMPLY WITH LIGHTING CONTROLS REQUIRMENTS DEFINED IN ASHRAE 90.1 2013. FOR SPECIFIC INFORMATION CONTACT GET FOR ORDERING INQUIRIES CONTACT GASSER BUSH AT QUOTES@GASSERBUSH.COM OR 734-266-6705.
 - THIS DRAWING WAS GENERATED FROM AN ELECTRONIC IMAGE FOR ESTIMATION PURPOSE ONLY. LAYOUT TO BE VERIFIED IN FIELD BY OTHERS.
 - MOUNTING HEIGHT IS MEASURED FROM GRADE TO FACE OF FIXTURE. POLE HEIGHT SHOULD BE CALCULATED AS THE MOUNTING HEIGHT LESS BASE HEIGHT.

Mariners Church Detroit\_V4 #22-76390.AGI


Gasser Bush Associates / Applications

www.gasserbush.com

Designer: JC3 Date:6/9/2022

Scale: NOT TO SCALE



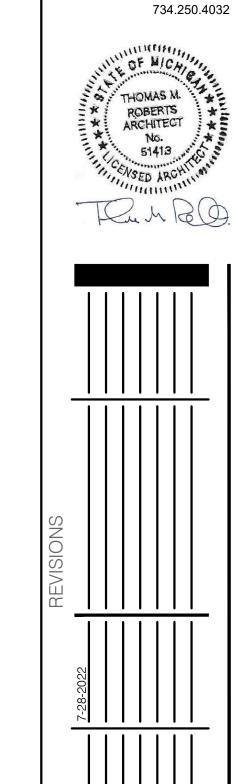

Thomas Roberts Architects Thomas Roberts Architects

2927 4th Street Wyandotte, MI 48192 thomasrobertsarchitect.com

of Detroit Mariners Church C Site Lighting 170 E. Jefferson Ave. Detroit, MI 48226


principal in charge

project manager

project architect

07.28.2022

22010.00 job number

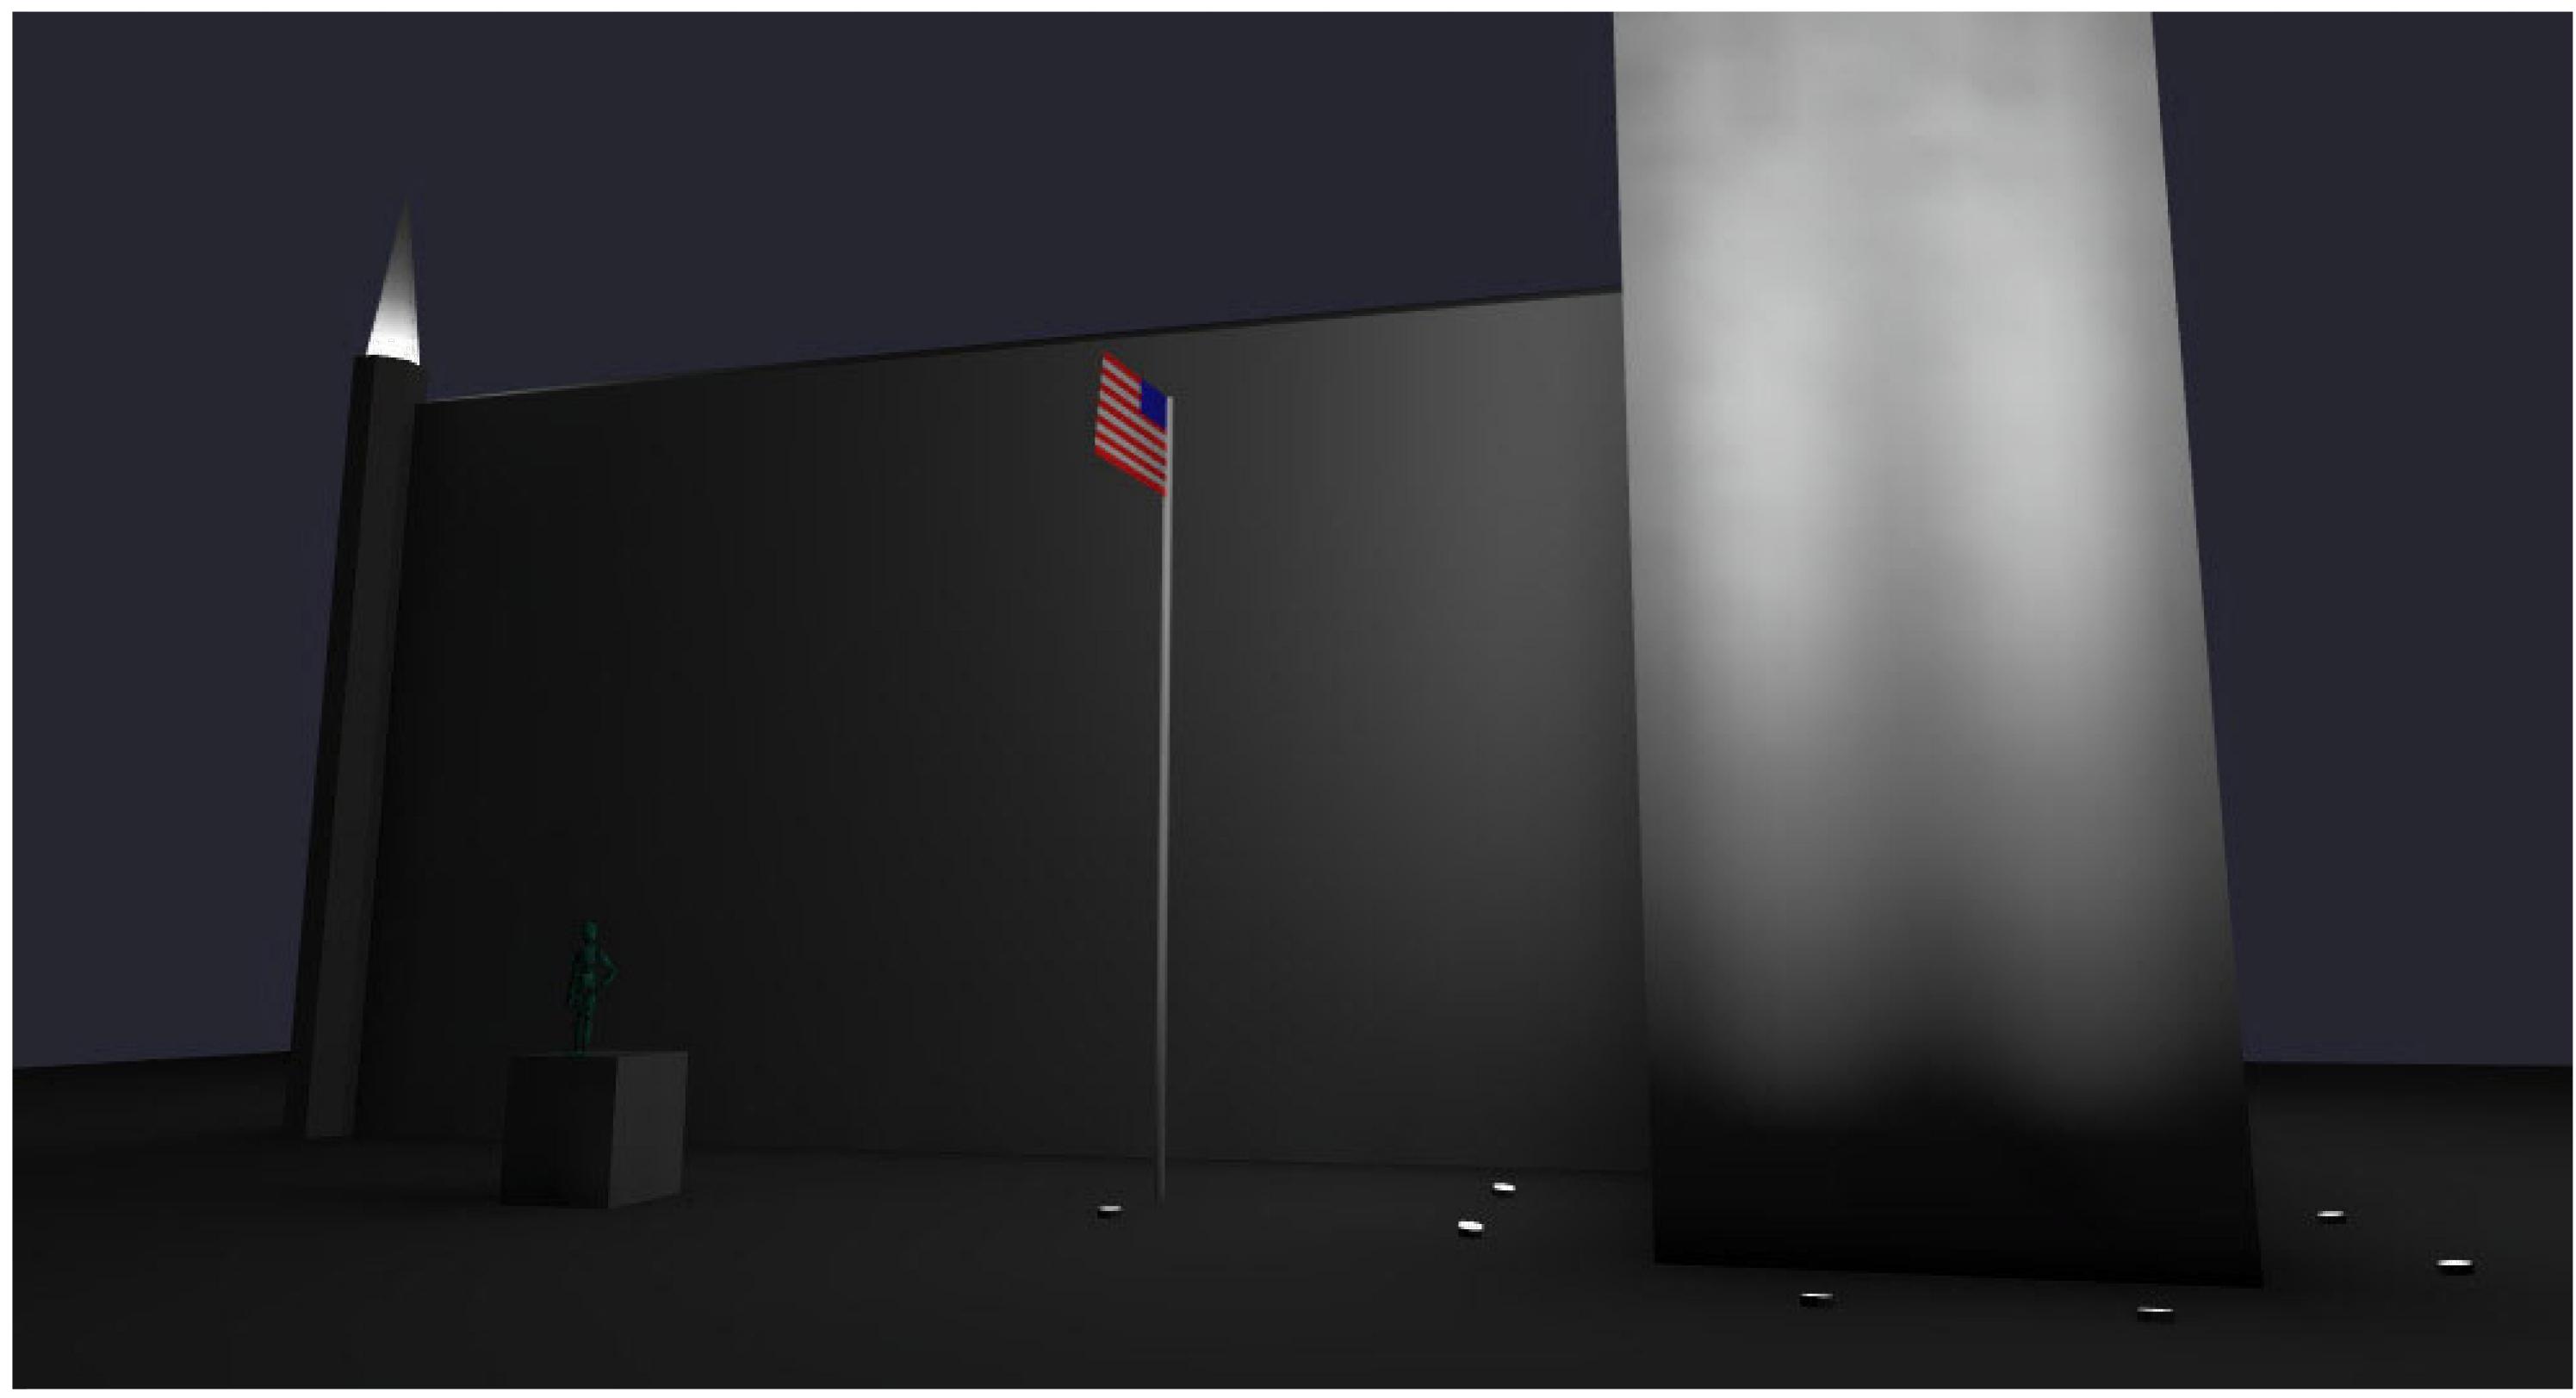

ISOMETRIC VIEWS: CONTRAST & PSEUDO COLOR

1. SEE SCHEDULE FOR LUMINAIRE MOUNTING HEIGHT.
2. CALCULATIONS ARE SHOWN IN FOOTCANDLES AT: 0' - 0", FOOD SERVICE AREA AT: 2' - 6", TREES SHOWN AT BOTTOM OF LEAVES
3. LIGHTING ALTERNATES REQUIRE NEW PHOTOMETRIC CALCULATION AND RESUBMISSION TO CITY FOR APPROVAL.

- THE ENGINEER AND/OR ARCHITECT MUST DETERMINE APPLICABILITY OF THE LAYOUT TO EXISTING / FUTURE FIELD CONDITIONS.
THIS LIGHTING LAYOUT REPRESENTS ILLUMINATION LEVELS CALCULATED FROM LABORATORY DATA TAKEN UNDER CONTROLLED CONDITIONS IN ACCORDANCE WITH ILLUMINATING ENGINEERING SOCIETY APPROVED METHODS.
ACTUAL PERFORMANCE OF ANY MANUFACTURER'S LUMINAIRE MAY VARY DUE TO VARIATION IN ELECTRICAL VOLTAGE, TOLERANCE IN LAMPS, AND OTHER VARIABLE FIELD CONDITIONS. MOUNTING HEIGHTS INDICATED ARE FROM GRADE AND/OR FLOOR UP.

- THESE LIGHTING CALCULATIONS ARE NOT A SUBSTITUTE FOR INDEPENDENT ENGINEERING ANALYSIS OF LIGHTING SYSTEM SUITABILITY AND SAFETY.

THE ENGINEER AND/OR ARCHITECT IS RESPONSIBLE TO REVIEW FOR MICHIGAN ENERGY CODE AND LIGHTING QUALITY COMPLIANCE.

- UNLESS ENEMPT, PROJECT MONTACT CONTROLS CONTROLS REQUIRENTS OF 1201 201 2013. FOR SPECIFIC INFORMATION CONTACT GBA CONTROLS GROUP AT ASG@GASSERBUSH.COM OR 734-266-6705.

- UNLESS EXEMPT, PROJECT MOST COMPLY WITH LIGHTING CONTROLS REQUIRMENTS DEFINED IN ASHRAE 90.1 2013. FOR SPECIFIC INFORMATION CONTACT GET FOR ORDERING INQUIRIES CONTACT GASSER BUSH AT QUOTES@GASSERBUSH.COM OR 734-266-6705.
 - THIS DRAWING WAS GENERATED FROM AN ELECTRONIC IMAGE FOR ESTIMATION PURPOSE ONLY. LAYOUT TO BE VERIFIED IN FIELD BY OTHERS.
 - MOUNTING HEIGHT IS MEASURED FROM GRADE TO FACE OF FIXTURE. POLE HEIGHT SHOULD BE CALCULATED AS THE MOUNTING HEIGHT LESS BASE HEIGHT.

Mariners Church Detroit\_V4 #22-76390.AGI

Gasser Bush Associates / Applications

www.gasserbush.com

Designer: JC3 Date:6/9/2022

Scale: NOT TO SCALE




Wyandotte, MI 48192 thomasrobertsarchitect.com 734.250.4032

Thomas Roberts Architects Thomas Roberts Architects

of Detroit Mariners Church C Site Lighting 170 E. Jefferson Ave. Detroit, MI 48226

principal in charge project manager project architect 07.28.2022

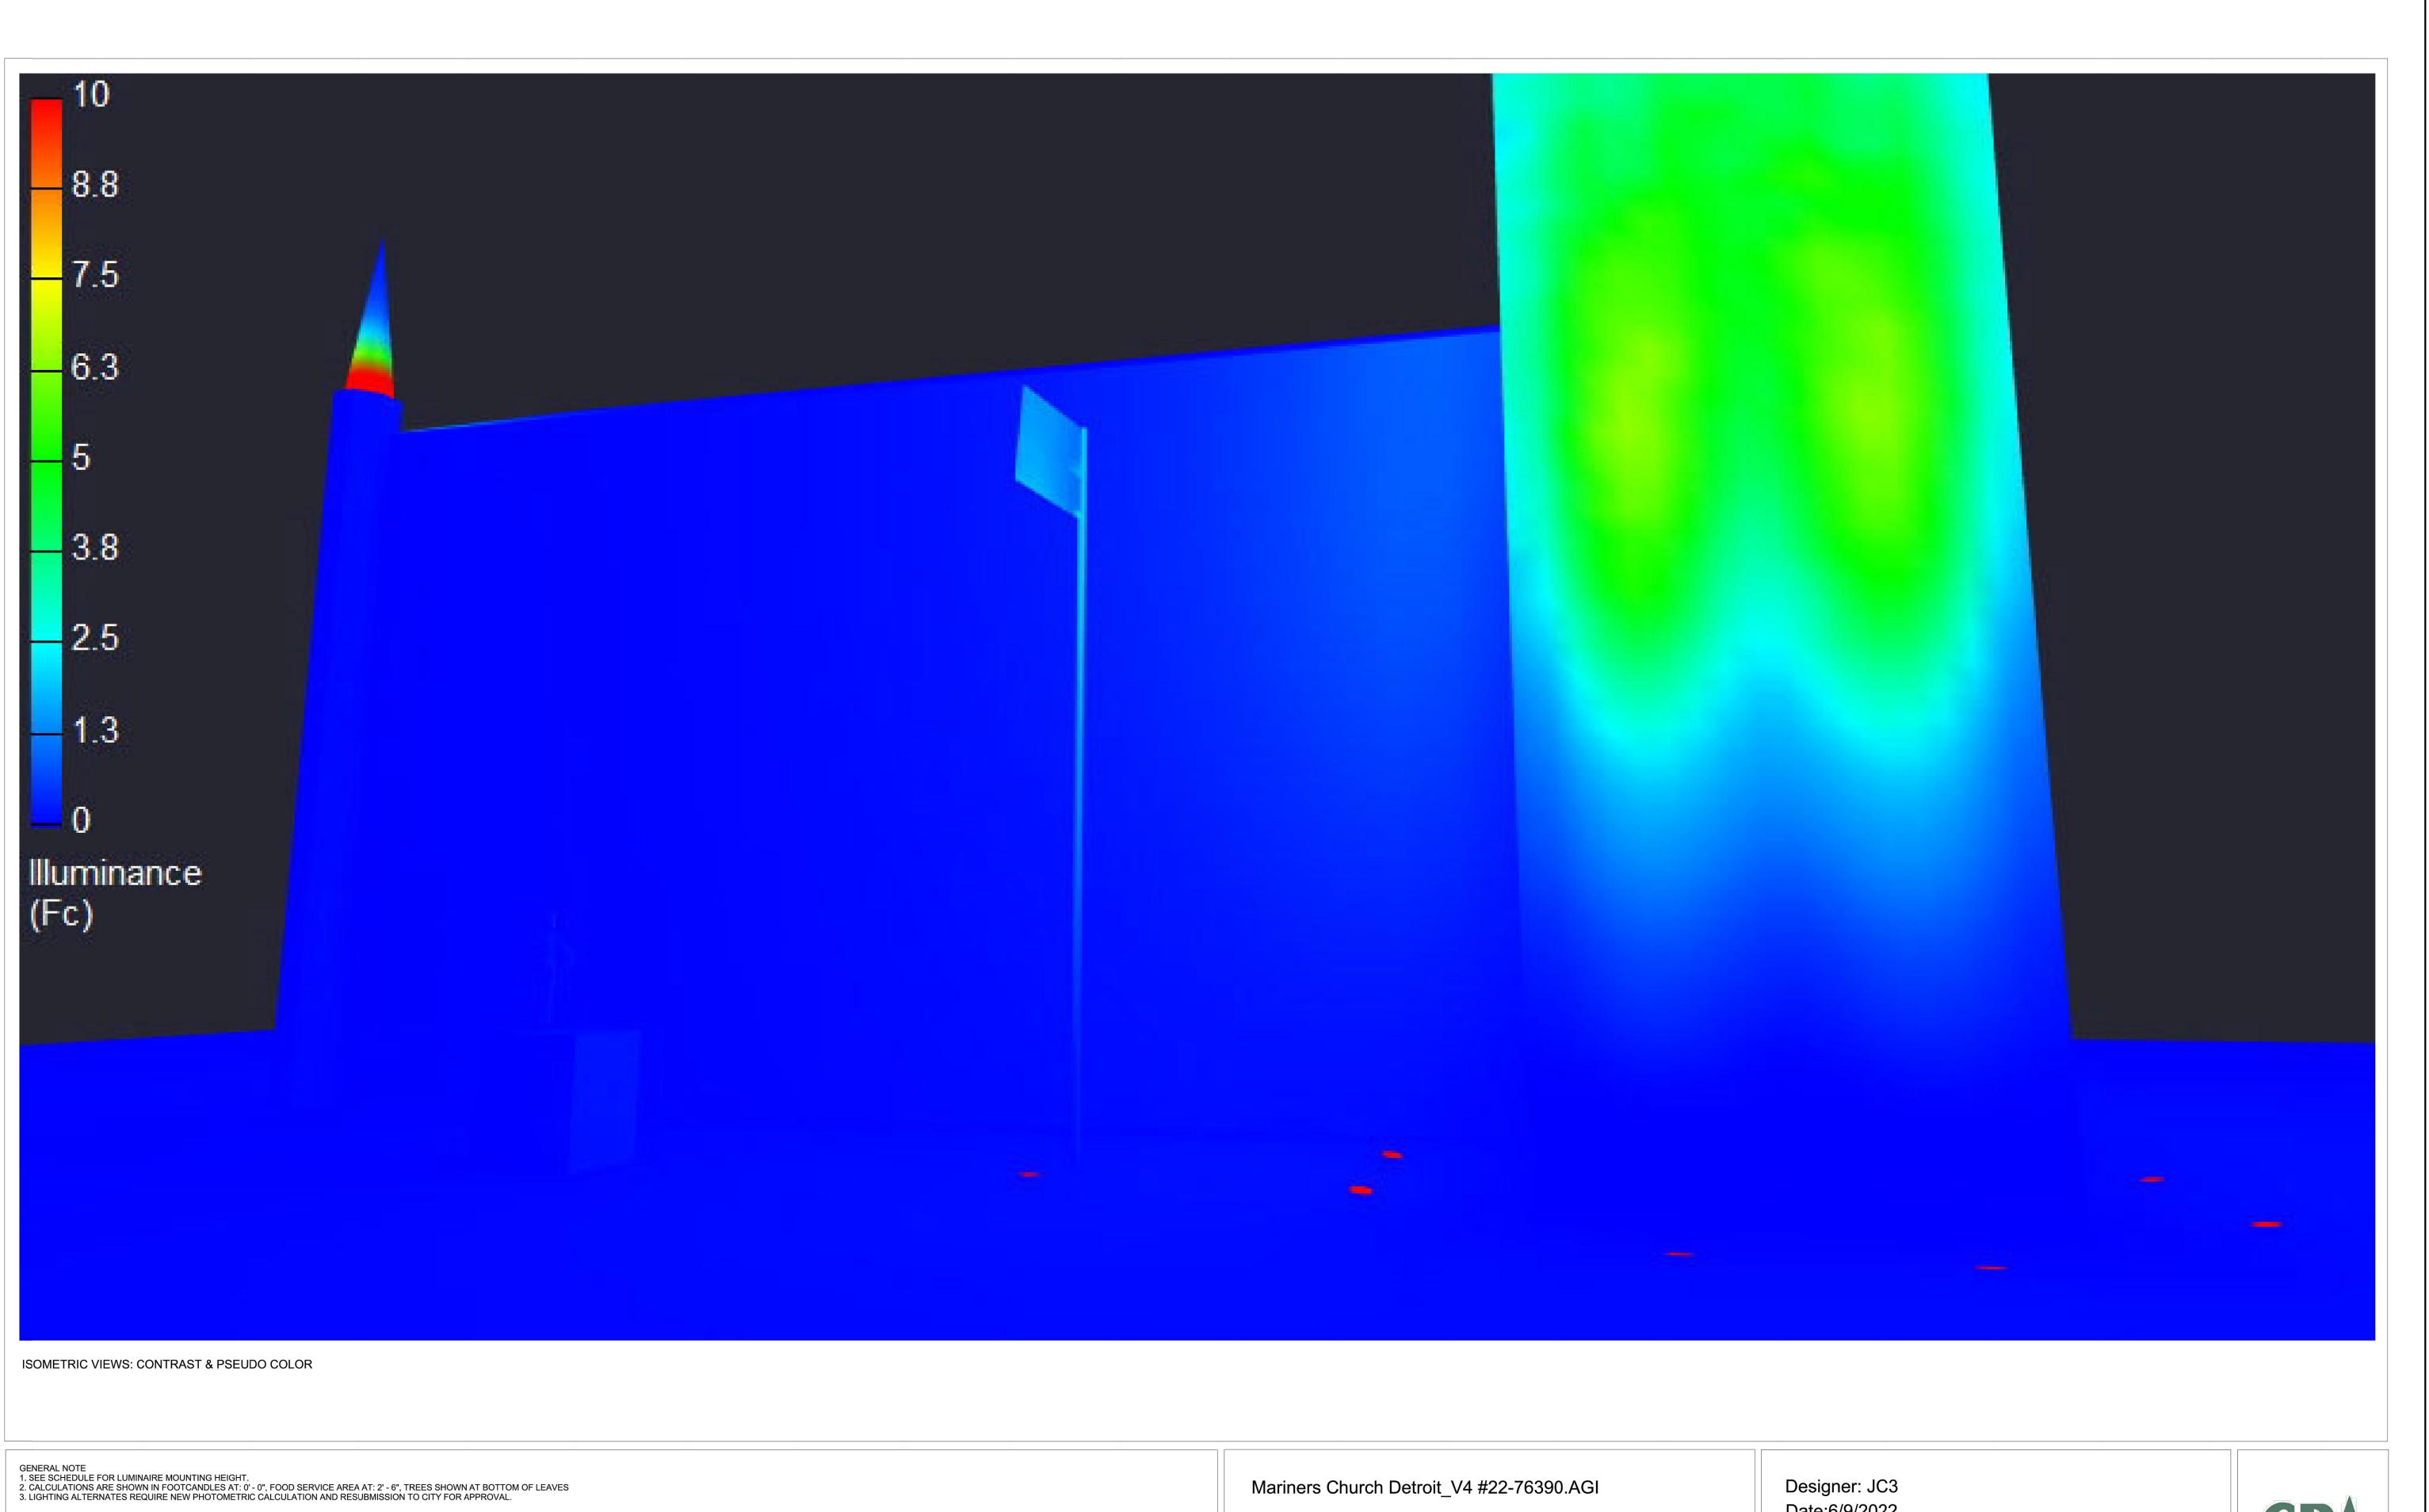

Gasser Bush Associates / Applications

www.gasserbush.com

Mariners Church C Site Lighting 170 E. Jefferson Ave. Detroit, MI 48226 principal in charge project manager project architect 07.28.2022

of Detroit

Thomas Roberts Architects Thomas Roberts Architects

Thomas Roberts Architects
Thomas Roberts Architects
2927 4th Street Wyandotte, MI 48192 thomasrobertsarchitect.com 734.250.4032

Date:6/9/2022

Scale: NOT TO SCALE

- THE ENGINEER AND/OR ARCHITECT MUST DETERMINE APPLICABILITY OF THE LAYOUT TO EXISTING / FUTURE FIELD CONDITIONS.
THIS LIGHTING LAYOUT REPRESENTS ILLUMINATION LEVELS CALCULATED FROM LABORATORY DATA TAKEN UNDER CONTROLLED CONDITIONS IN ACCORDANCE WITH ILLUMINATING ENGINEERING SOCIETY APPROVED METHODS.
ACTUAL PERFORMANCE OF ANY MANUFACTURER'S LUMINAIRE MAY VARY DUE TO VARIATION IN ELECTRICAL VOLTAGE, TOLERANCE IN LAMPS, AND OTHER VARIABLE FIELD CONDITIONS. MOUNTING HEIGHTS INDICATED ARE FROM GRADE AND/OR FLOOR UP.


- THESE LIGHTING CALCULATIONS ARE NOT A SUBSTITUTE FOR INDEPENDENT ENGINEERING ANALYSIS OF LIGHTING SYSTEM SUITABILITY AND SAFETY.


THE ENGINEER AND/OR ARCHITECT IS RESPONSIBLE TO REVIEW FOR MICHIGAN ENERGY CODE AND LIGHTING QUALITY COMPLIANCE.

- UNLESS ENEMPT, PROJECT MONTACT CONTROLS CONTROLS REQUIRENTS OF 1201 201 2013. FOR SPECIFIC INFORMATION CONTACT GBA CONTROLS GROUP AT ASG@GASSERBUSH.COM OR 734-266-6705.

- UNLESS EXEMP1, PROJECT MOST COMPLY WITH LIGHTING CONTROLS REQUIRMENTS DEFINED IN ASHRAE 90.1 2013. FOR SPECIFIC INFORMATION CONTACT GET FOR ORDERING INQUIRIES CONTACT GASSER BUSH AT QUOTES@GASSERBUSH.COM OR 734-266-6705.
 - THIS DRAWING WAS GENERATED FROM AN ELECTRONIC IMAGE FOR ESTIMATION PURPOSE ONLY. LAYOUT TO BE VERIFIED IN FIELD BY OTHERS.
 - MOUNTING HEIGHT IS MEASURED FROM GRADE TO FACE OF FIXTURE. POLE HEIGHT SHOULD BE CALCULATED AS THE MOUNTING HEIGHT LESS BASE HEIGHT.


Schedule										
Label	Symbol	Qty	Manufacturer	Catalog Number	Light Loss Factor	Lumens Per Lamp	Watts			
L1		44	QTRAN L1	VERS-04-SW-9_0HE-30-DRY-GZR-S	0.900	1108	8.74			
E3	(4)	2	LUMENPULSE E3	LBM-120-30K-VN-XX-XX	0.900	1565	25			
E2	(4)	2	LUMENPULSE E2	LBL-120-30K-NS-XX-XX	0.900	4667	50			
E1	4	7	LUMENPULSE E1	LBIL-120_277-30K-NS-CL-NO_DIM	0.900	4034	59.4			

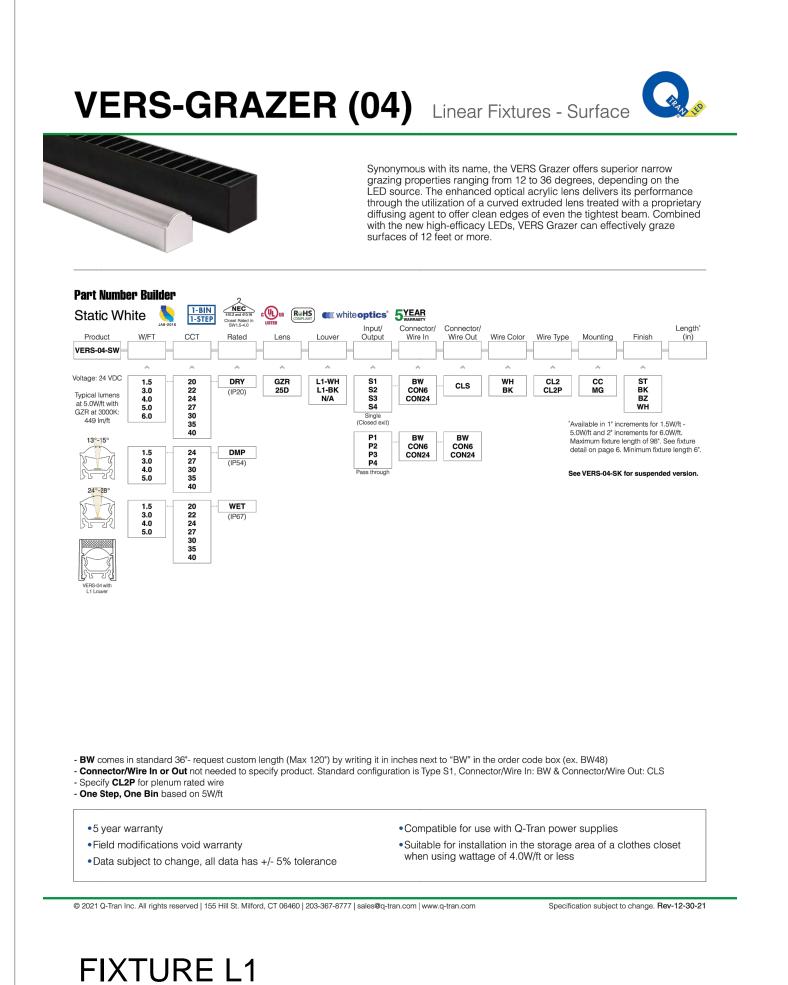

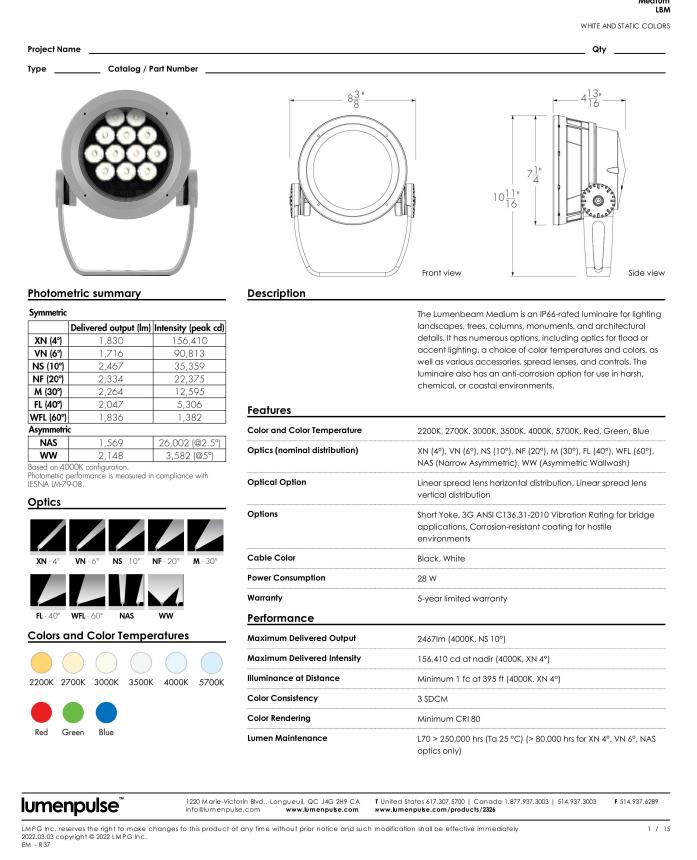

lumenbeam

Specification Sheet lumenbeam WHITE AND STATIC COLORS \_\_\_\_ Catalog / Part Number Delivered output (lm) Intensity (peak cd landscapes, trees, columns, monuments, and architectural details. It has numerous options, including optics for flood or accent lighting, a choice of color temperatures and colors. as well as various accessories, spread lenses, and controls. The luminaire also has an anti-corrosion option for use in harsh, chemical, or coastal environments. Color and Color Temperature 2200K, 2700K, 3000K, 3500K, 4000K, 5700K, Red, Green, Blue Optics (nominal distribution) XN (4°), VN (6°), NS (10°), NF (20°), M (30°), FL (40°), WFL (60°), NAS (Narrow Asymmetric), WW (Asymmetric Wallwash) Optical Option Linear spread lens horizontal distribution, Linear spread lens vertical distribution Short Yoke, 3G ANSI C136.31-2010 Vibration Rating for bridge applications, Corrosion-resistant coating for hostile environments Black, White Power Consumption 50 W Warranty 5-year limited warranty <u>Performance</u> Maximum Delivered Output 5157 lm (4000K, NF 20°) Maximum Delivered Intensity 295,070 cd at nadir (4000K, XN 4°) Illuminance at Distance Minimum 1 fc at 543 ft (4000K, XN 4°) 2200K 2700K 3000K 3500K 4000K 5700K Color Consistency 3 SDCM Color Rendering Minimum CRI 80 Lumen Maintenance L70 > 250,000 hrs (Ta 25 °C) (> 80,000 hrs for XN 4°, VN 6°, NAS optics only) 1220 Marie-Victorin Blvd., Longueuil, QC J4G 2H9 CA info@lumenpulse.com www.lumenpulse.com router www.lumenpulse.com/products/2292 F 514.937.6289 www.lumenpulse.com/products/2292 lumenpulse"

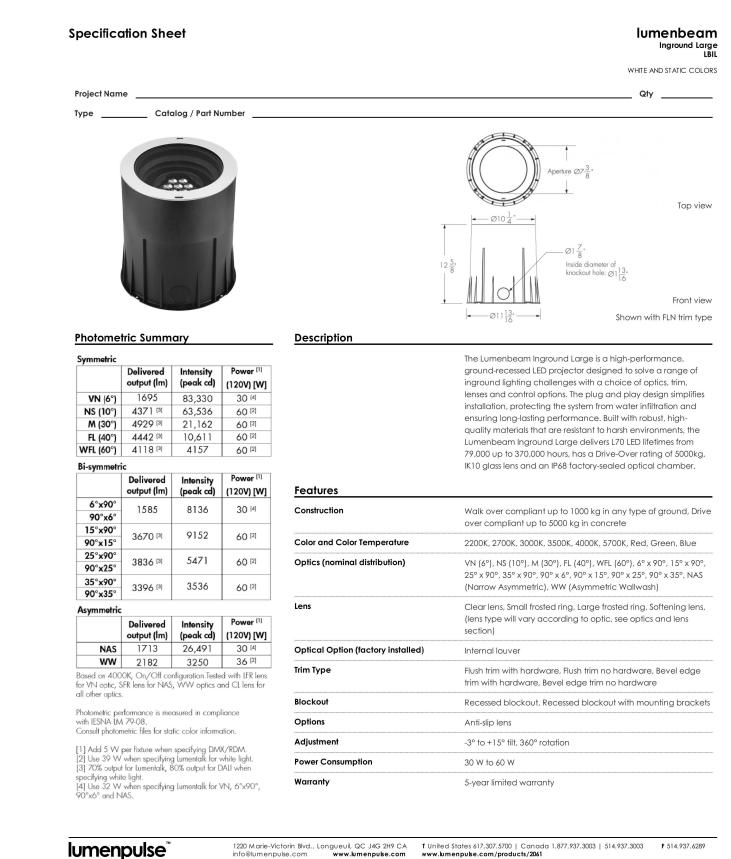

LMPG Inc. reserves the right to make changes to this product at any time without prior notice and such modification shall be effective immediately 2021.08.09 copyright © 2021 LMPG Inc.
EM - R11

FIXTURE E1

lumenpulse"

FIXTURE E3

**Specification Sheet** 

SPECIFICATION SHEETS

2. CALCULATIONS ARE SHOWN IN FOOTCANDLES AT: 0' - 0", FOOD SERVICE AREA AT: 2' - 6", TREES SHOWN AT BOTTOM OF LEAVES 3. LIGHTING ALTERNATES REQUIRE NEW PHOTOMETRIC CALCULATION AND RESUBMISSION TO CITY FOR APPROVAL

THE ENGINEER AND/OR ARCHITECT MUST DETERMINE APPLICABILITY OF THE LAYOUT TO EXISTING / FUTURE FIELD CONDITIONS.

THIS LIGHTING LAYOUT REPRESENTS ILLUMINATION LEVELS CALCULATED FROM LABORATORY DATA TAKEN UNDER CONTROLLED CONDITIONS IN ACCORDANCE WITH ILLUMINATING ENGINEERING SOCIETY APPROVED METHODS. ACTUAL PERFORMANCE OF ANY MANUFACTURER'S LUMINAIRE MAY VARY DUE TO VARIATION IN ELECTRICAL VOLTAGE, TOLERANCE IN LAMPS, AND OTHER VARIABLE FIELD CONDITIONS. MOUNTING HEIGHTS INDICATED ARE FROM GRADE AND/OR FLOOR UP.

THESE LIGHTING CALCULATIONS ARE NOT A SUBSTITUTE FOR INDEPENDENT ENGINEERING ANALYSIS OF LIGHTING SYSTEM SUITABILITY AND SAFETY. THE ENGINEER AND/OR ARCHITECT IS RESPONSIBLE TO REVIEW FOR MICHIGAN ENERGY CODE AND LIGHTING QUALITY COMPLIANCE.

- UNLESS EXEMPT, PROJECT MUST COMPLY WITH LIGHTING CONTROLS REQUIRMENTS DEFINED IN ASHRAE 90.1 2013. FOR SPECIFIC INFORMATION CONTACT GBA CONTROLS GROUP AT ASG@GASSERBUSH.COM OR 734-266-6705. FOR ORDERING INQUIRIES CONTACT GASSER BUSH AT QUOTES@GASSERBUSH.COM OR 734-266-6705.

- THIS DRAWING WAS GENERATED FROM AN ELECTRONIC IMAGE FOR ESTIMATION PURPOSE ONLY. LAYOUT TO BE VERIFIED IN FIELD BY OTHERS.
- MOUNTING HEIGHT IS MEASURED FROM GRADE TO FACE OF FIXTURE. POLE HEIGHT SHOULD BE CALCULATED AS THE MOUNTING HEIGHT LESS BASE HEIGHT.

Mariners Church Detroit\_V4 #22-76390.AGI Gasser Bush Associates / Applications

LMPG Inc. reserves the right to make changes to this product at any time without prior notice and such modification shall be effective immediately 2022.03.03 copyright © 2022 LMPG Inc. EM - R45

FIXTURE E2

www.gasserbush.com

Scale: NOT TO SCALE


Designer: JC3

Date:6/9/2022



Wyandotte, MI 48192 734.250.4032 THOMAS M. ROBERTS ARCHITECT

Thomas Roberts Architects Thomas Roberts Architects

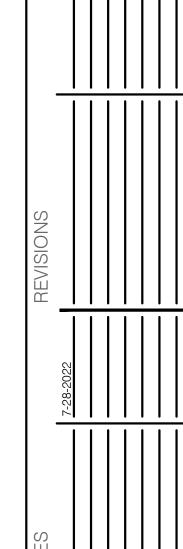

etr Of Mariners Church of the Lighting Mari Site 170 E. Detroit,

principal in charge project manager project architect 07.28.2022