



#	DESCRIPTION	DATE
1	Basement Extension Permit	01/21/22
2	Partial Review	02/14/22
3	Owner Review	02/28/22
4	Plan Check	03/08/22
5	Issued for Construction	03/21/22
6	ASI #4 - Site Conditions Coordination	05/13/22

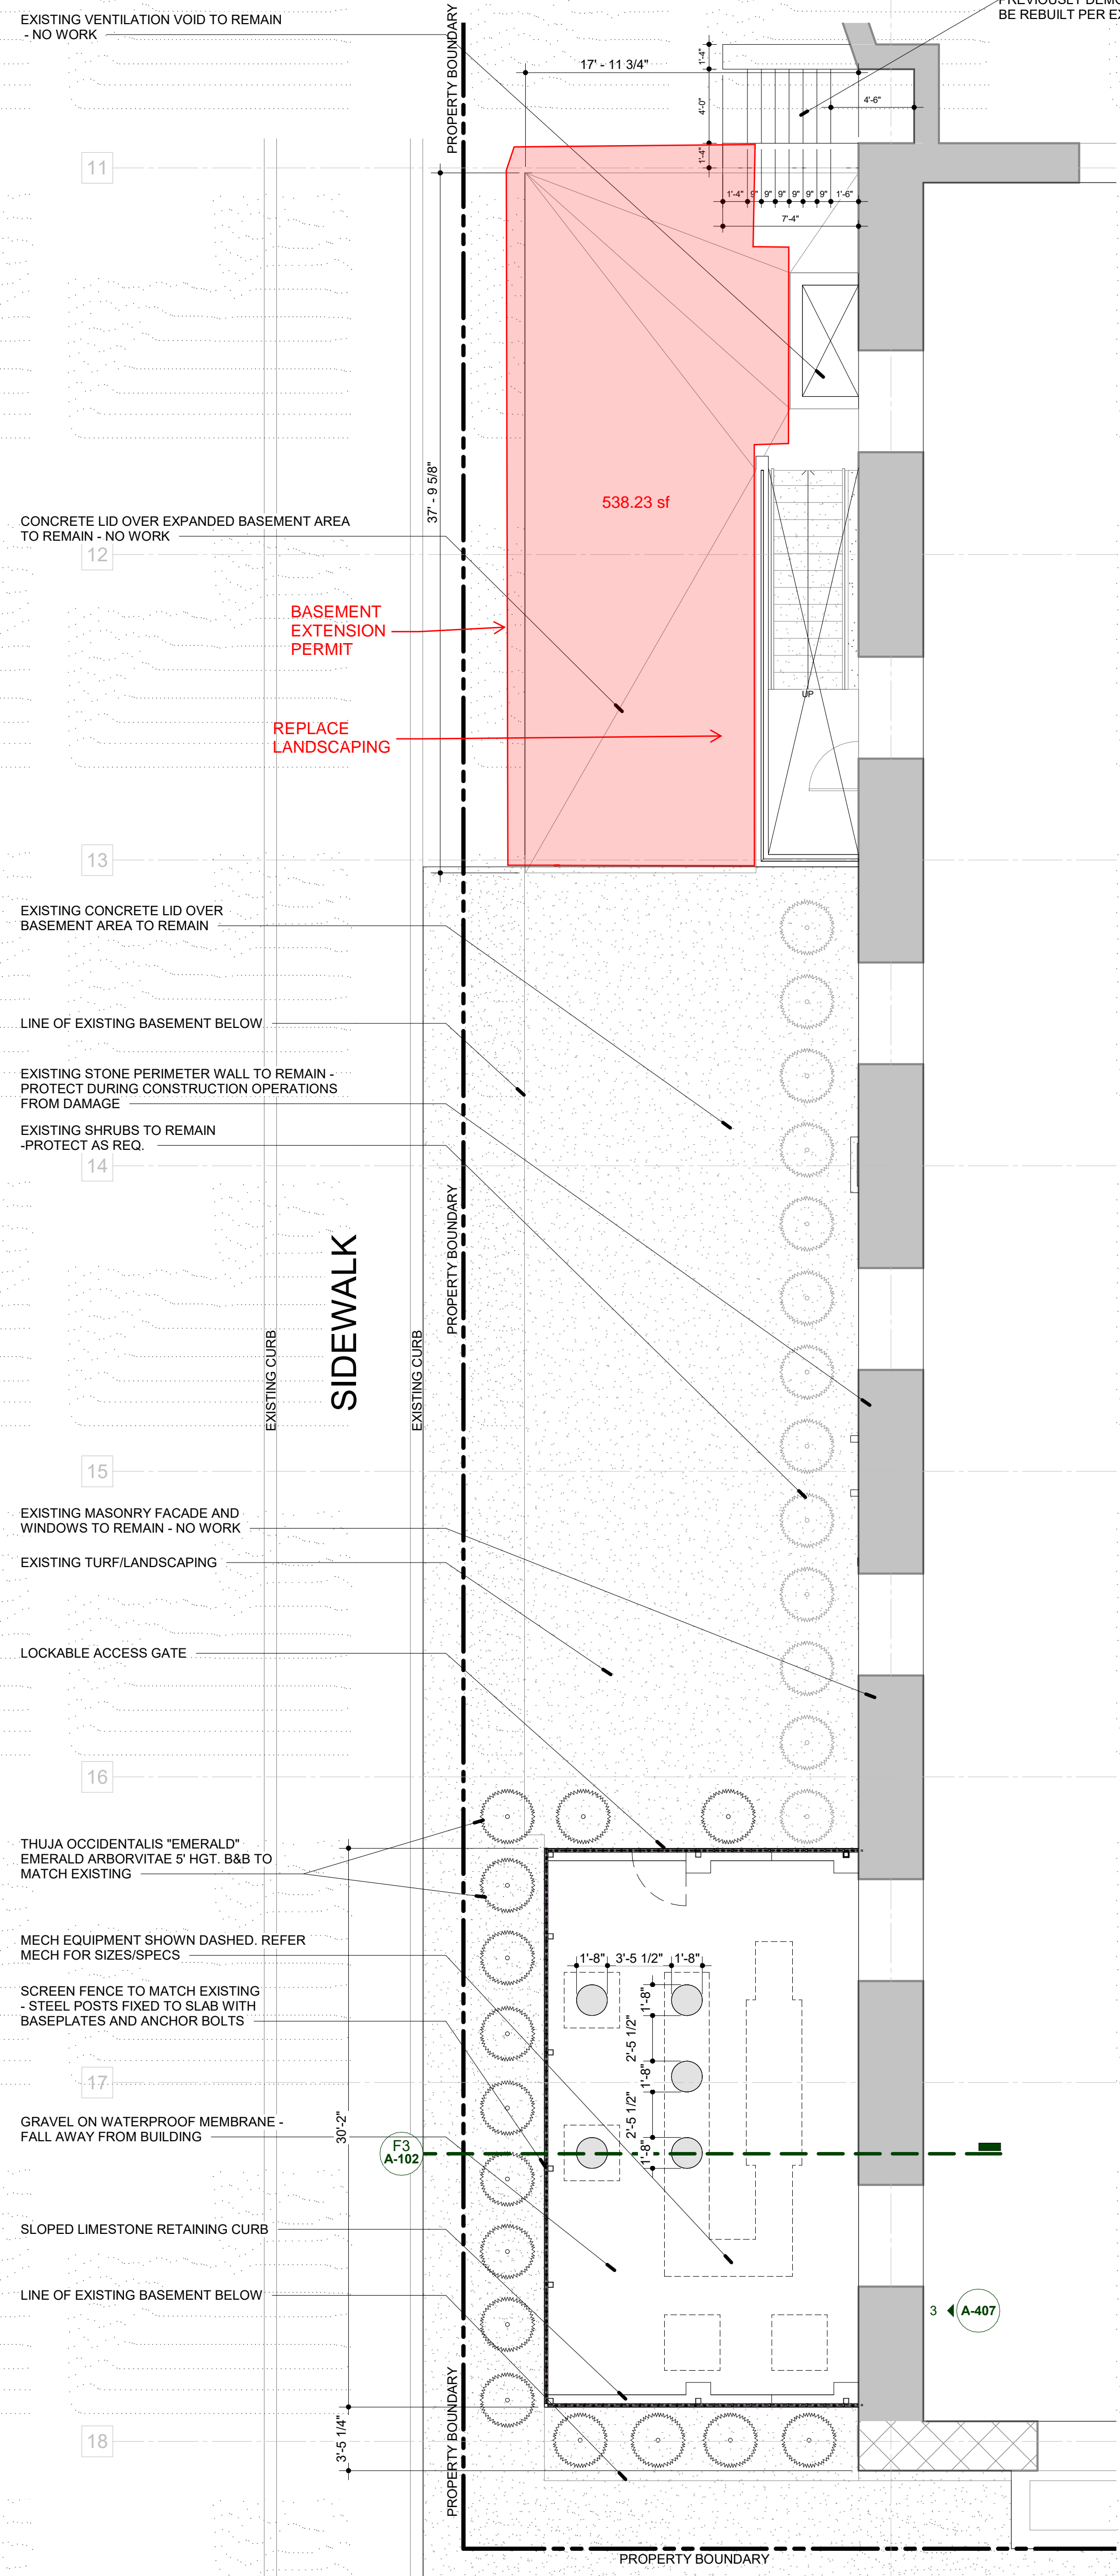


B8 Floor Plan - Street Level
A-102 SCALE: 3/16" = 1'-0"


MADISON STREET

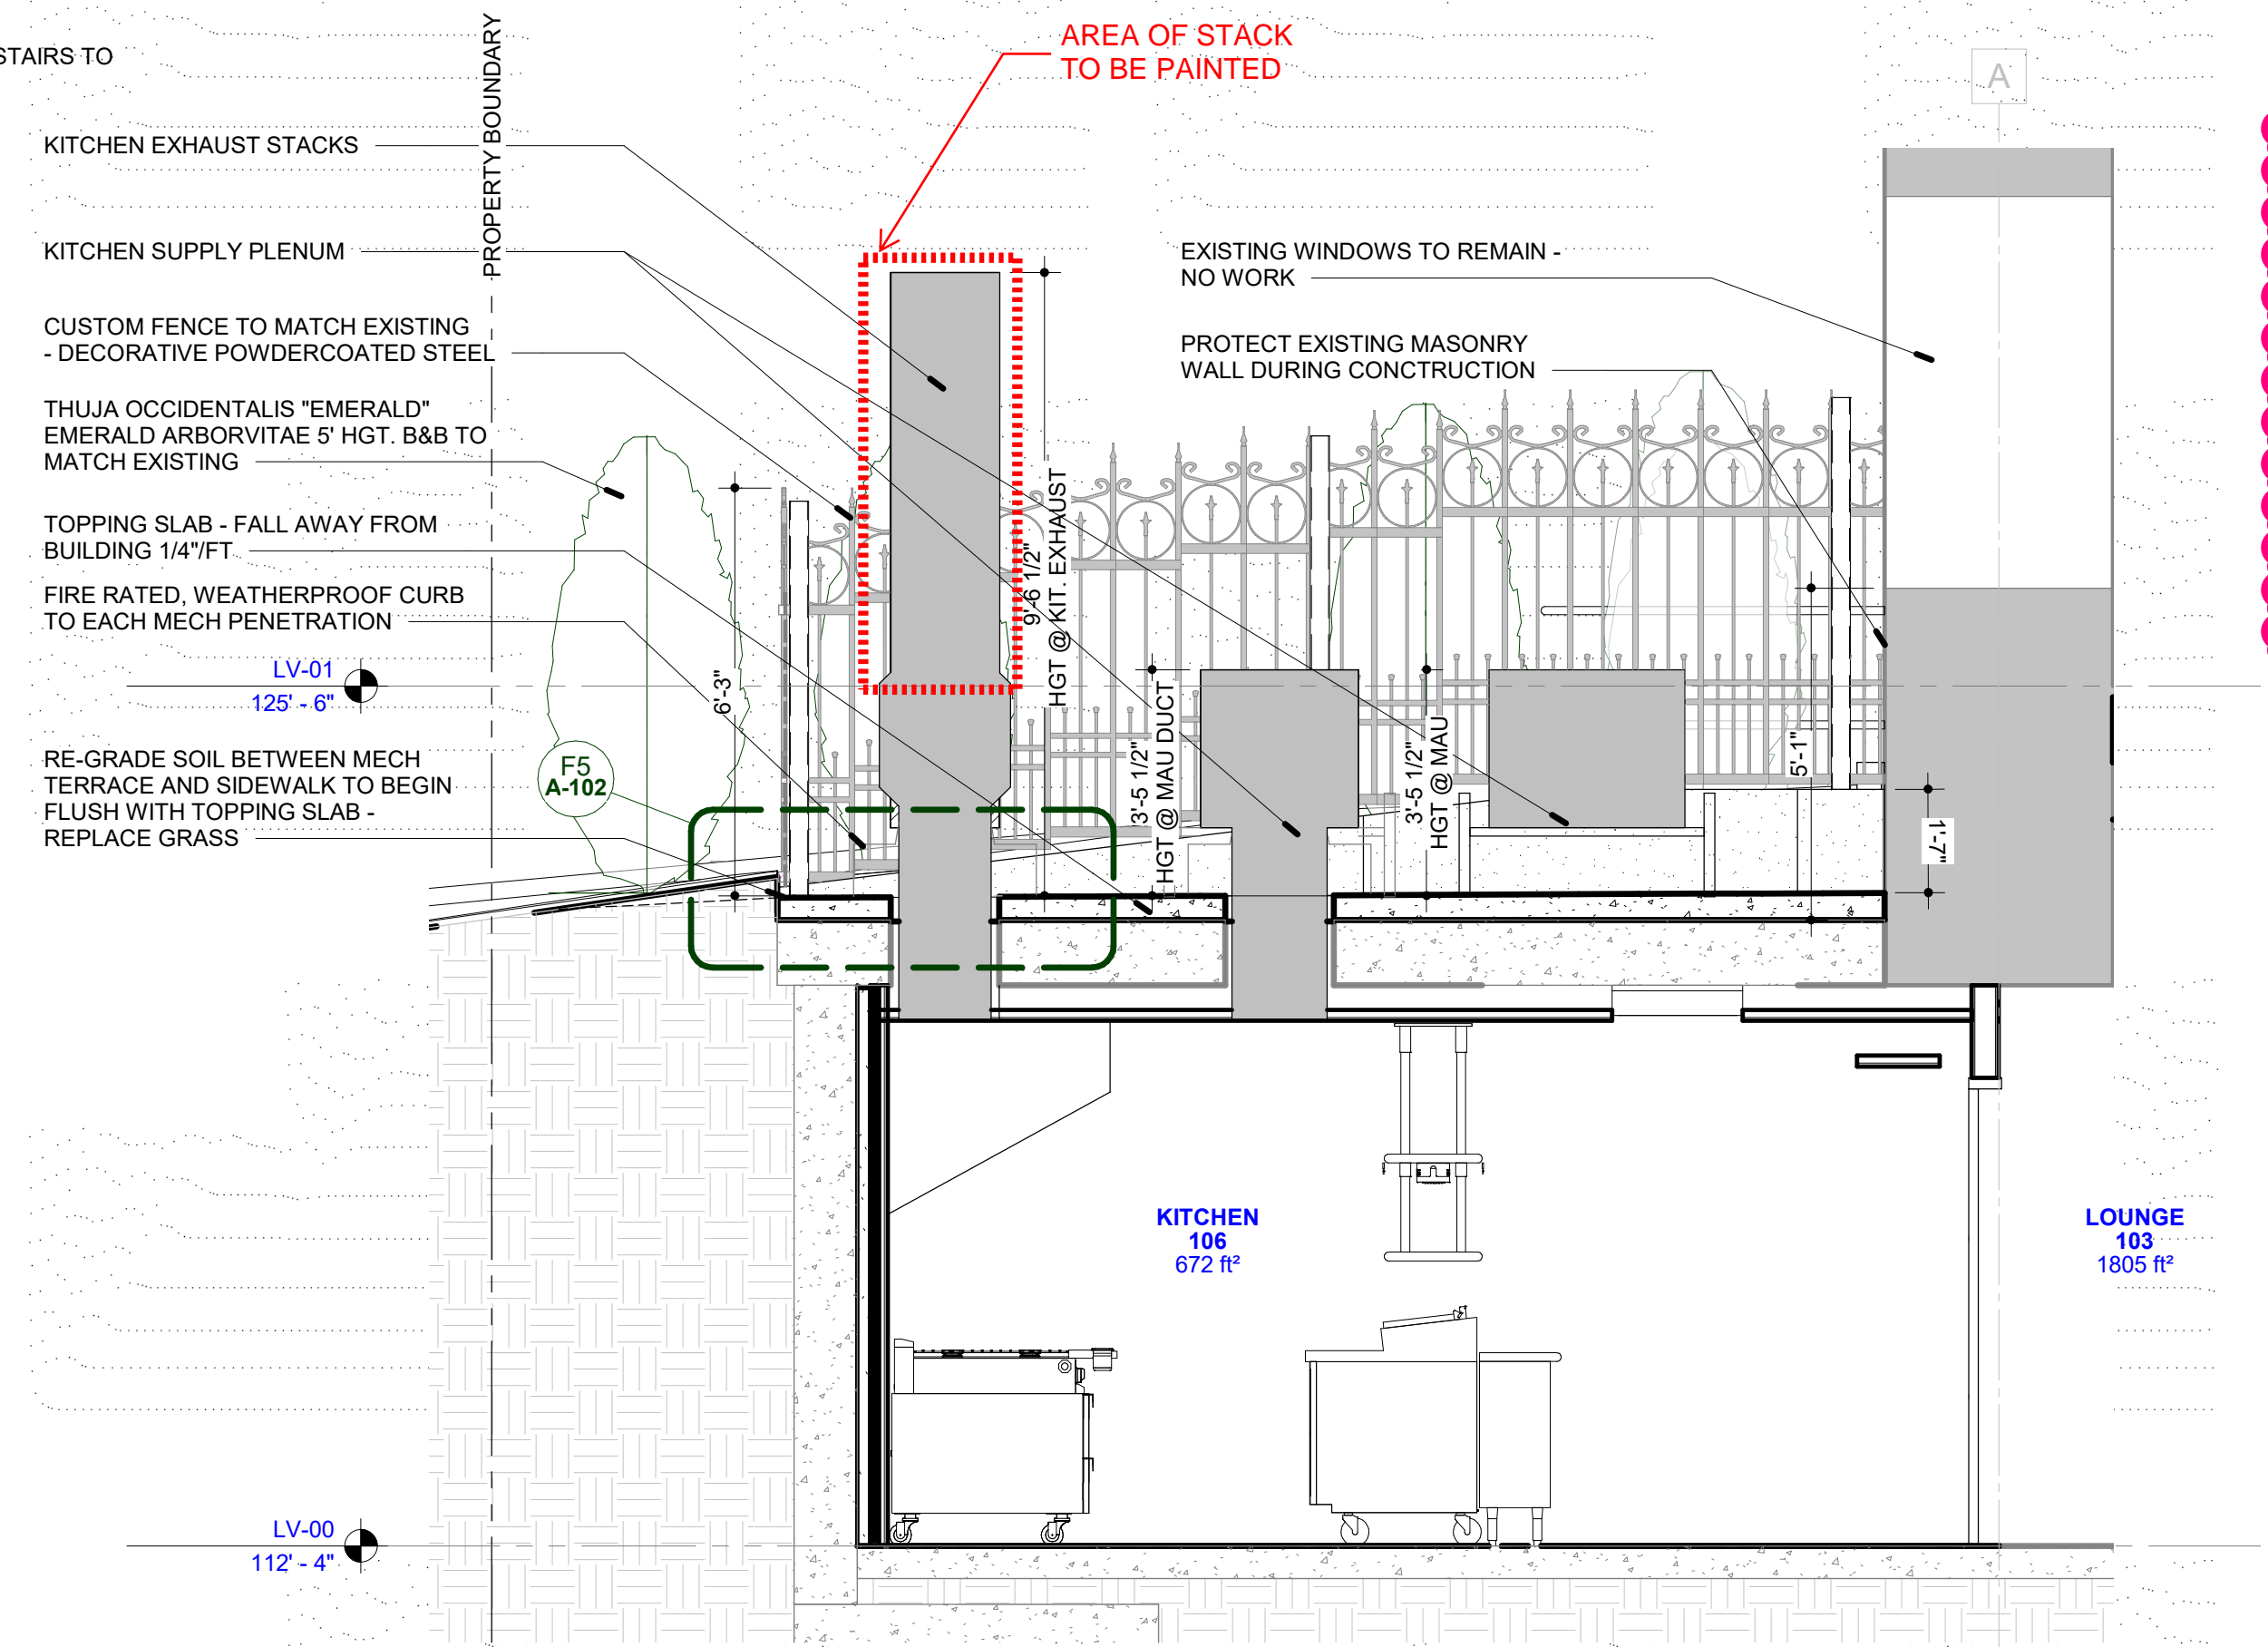

F3 Kitchen & Mechanical Terrace Section
A-102 SCALE: 3/8" = 1'-0" REF: A-102

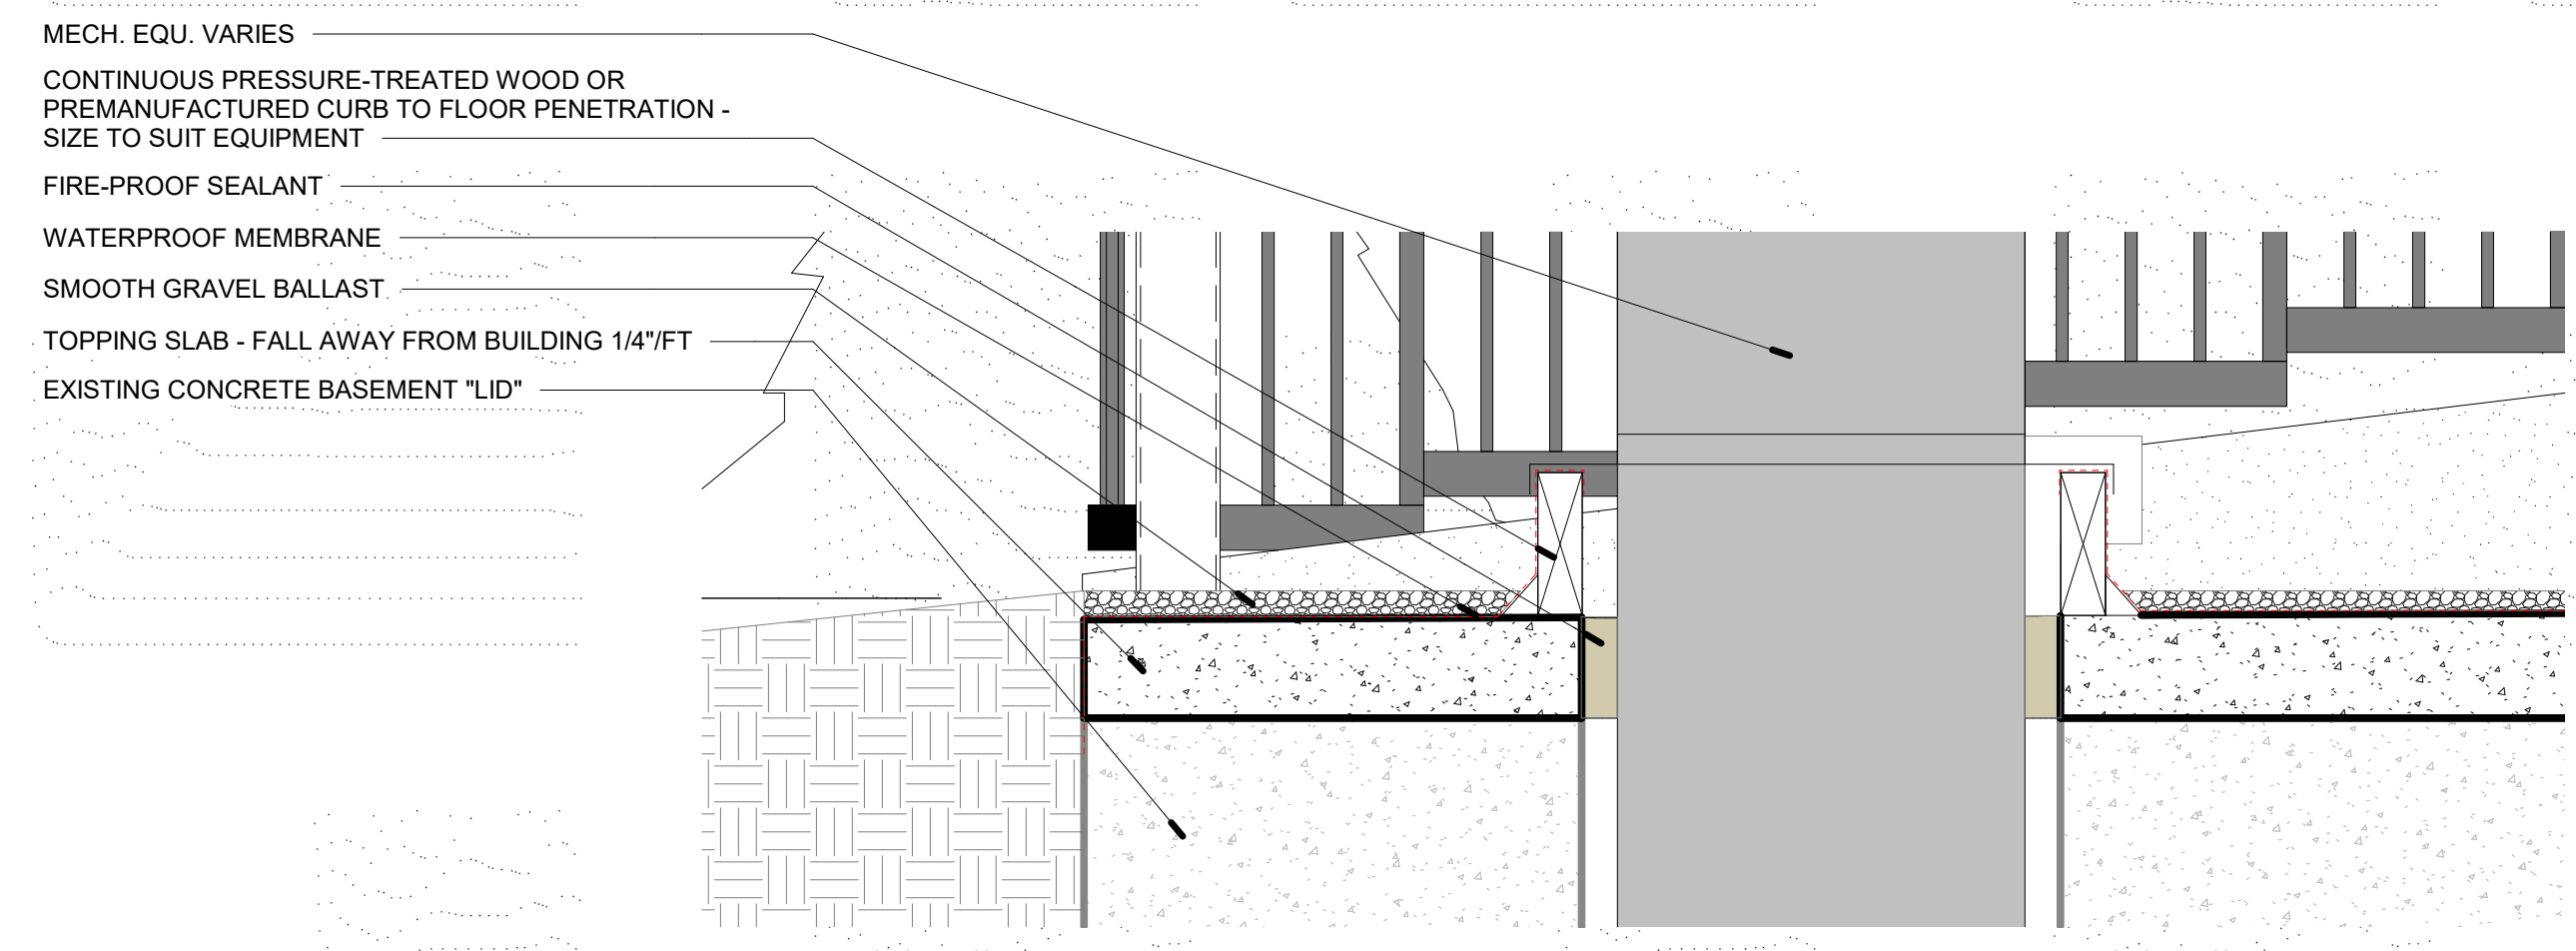

F5 Mech Penetration - Typical Section Detail
A-102 SCALE: 1 1/2" = 1'-0" REF: A-102

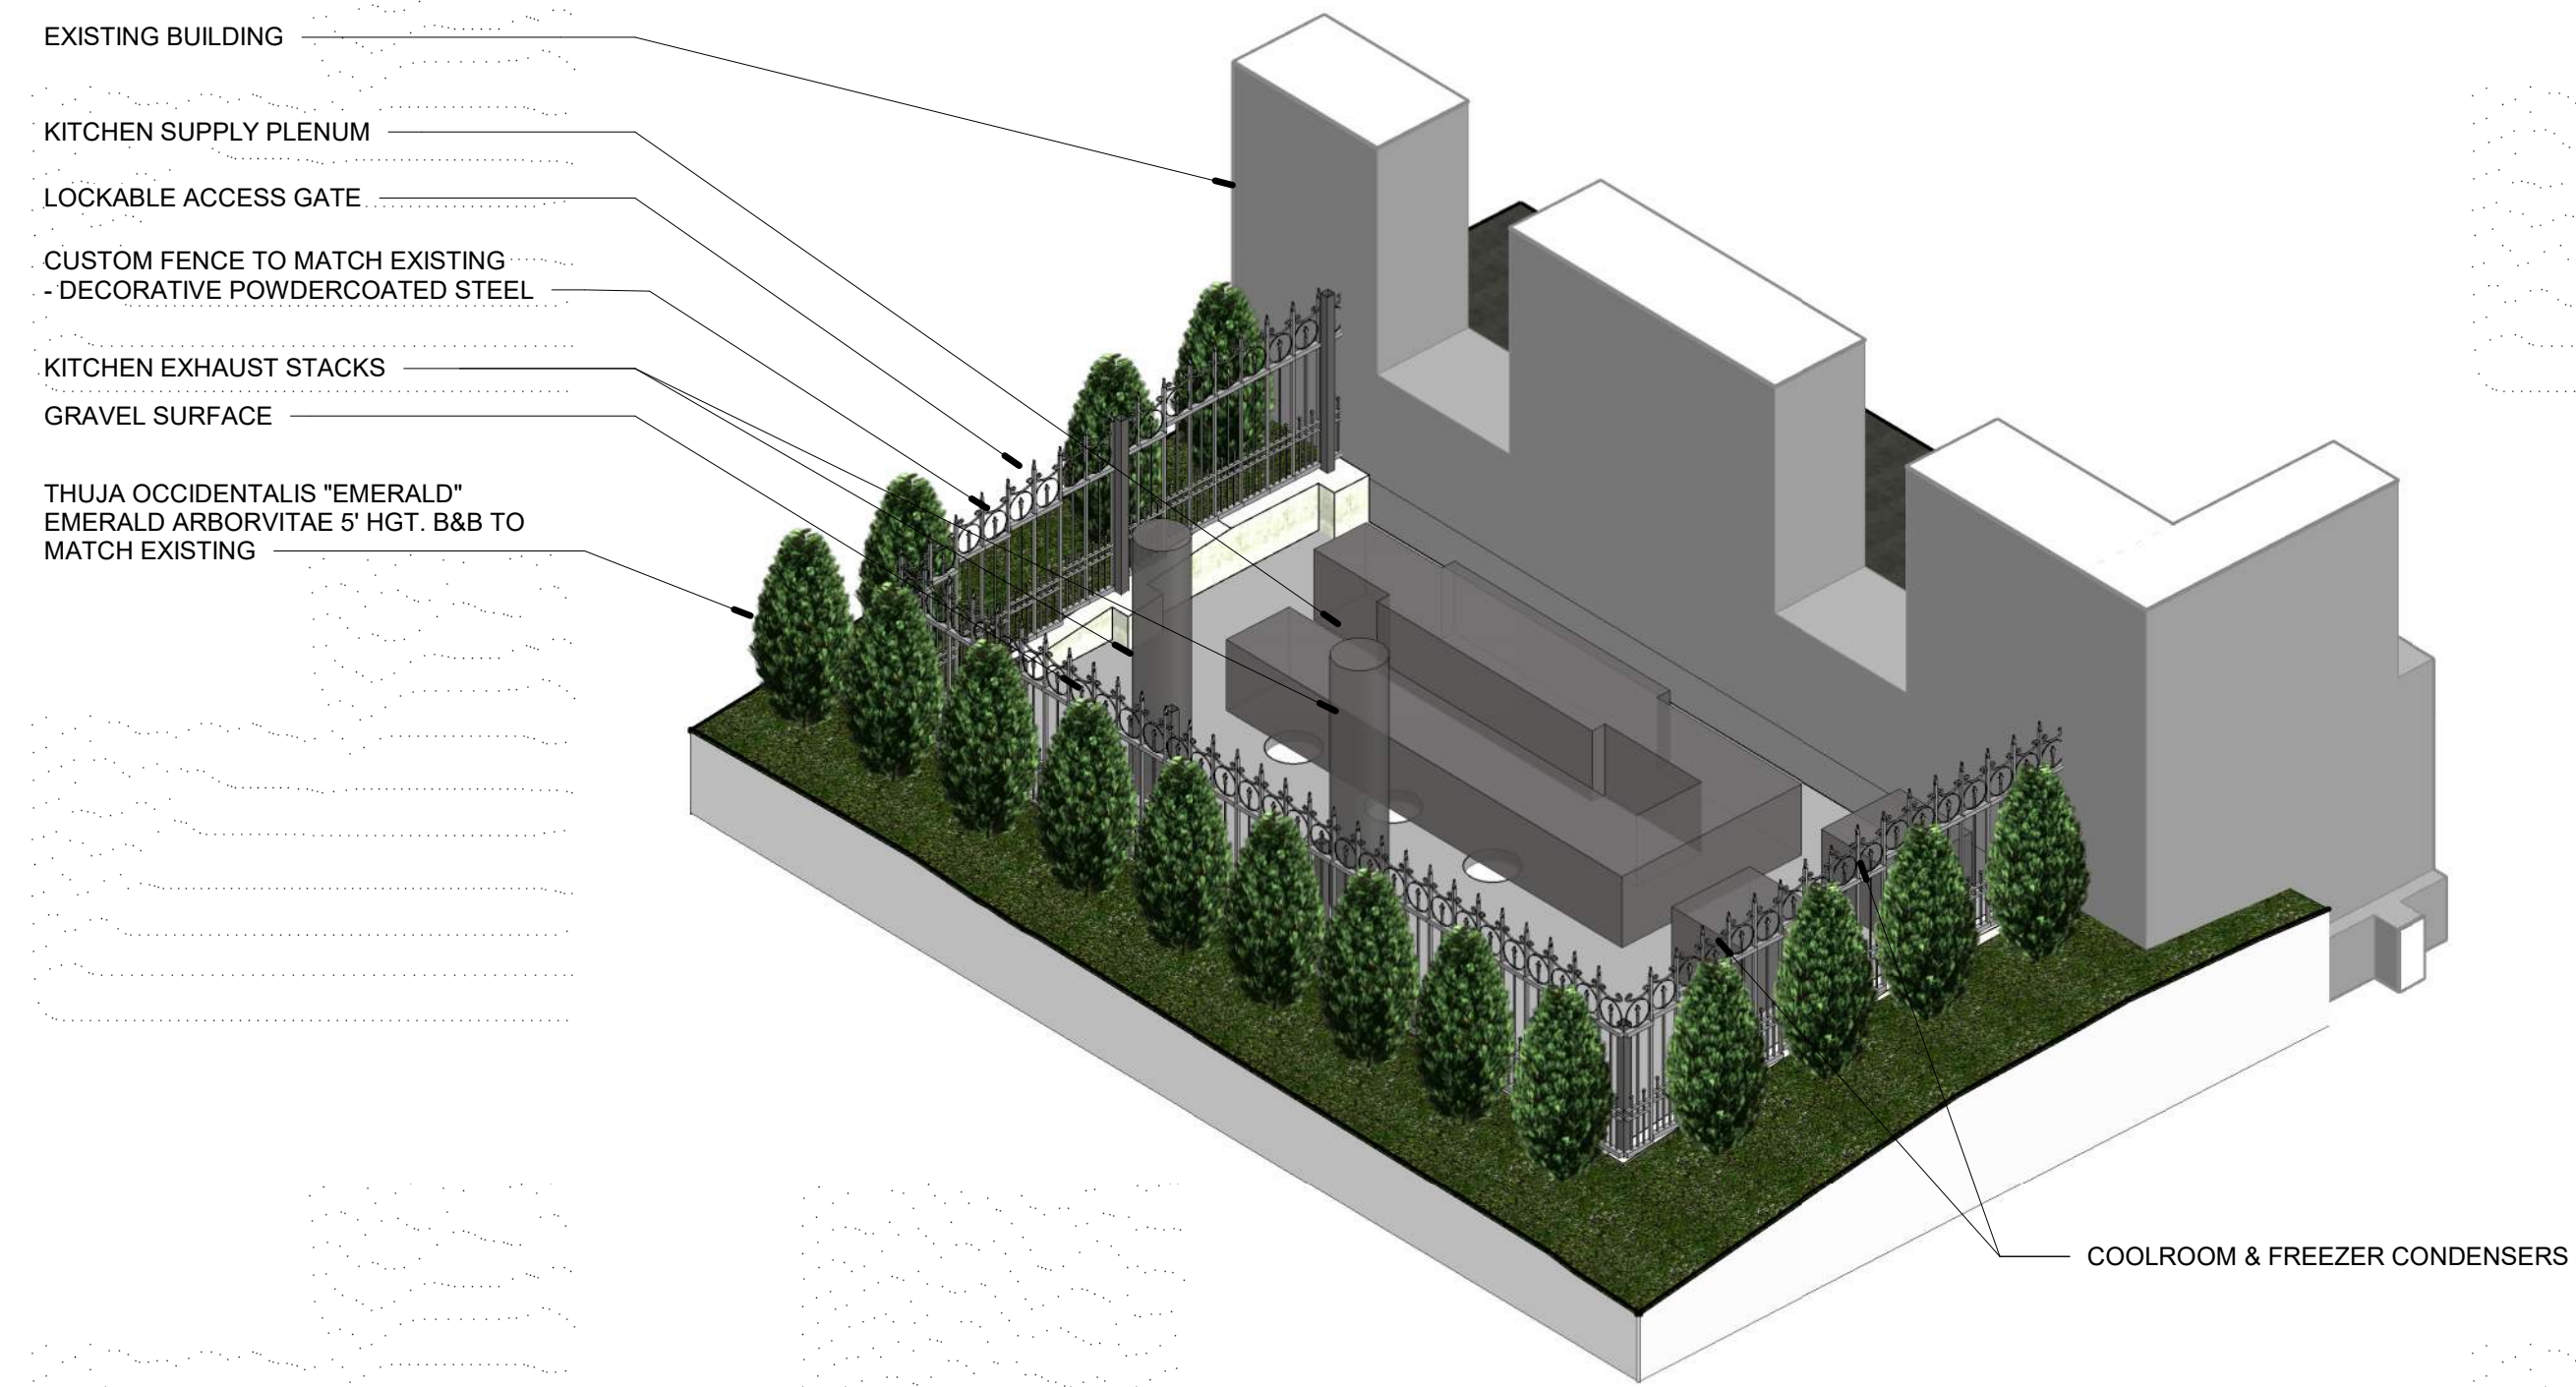

F8 Mechanical Equipment Terrace - Ortho View
A-102 SCALE:

EXTERIOR CHANGES
NOTED HERE TO BE
UNDER FUTURE BUILDING
PERMIT & NOT IN
CURRENT SCOPE OF
WORK. HDC APPROVAL
REQUIRED PRIOR TO
BSEED REVIEW.

C:\ROSSETTI\Projects\DAC\B8_ARCH\sgene\271818.mxd
5/12/2022 3:29:04 PM