



City of Detroit - Planning & Development Department
2 Woodward Avenue, Suite 808
Detroit, Michigan 48226

HISTORIC DISTRICT COMMISSION ADDITIONAL INFORMATION REQUEST

Date: 02/17/2026

Application Number: HDC2026-00051

APPLICANT & PROPERTY INFORMATION

NAME: John Marusich

COMPANY NAME: Marusich Architecture

ADDRESS: 36880 Woodward Ave Suite 100

CITY: Bloomfield Hills, MI

STATE: MI

ZIP: 48304

PROJECT ADDRESS: 1069 Manistique Street

HISTORIC DISTRICT: Jefferson-Chalmers Historic Business

REQUESTED INFORMATION

We have received your application, but it is not yet complete for review. Please provide additional details based on the comments and questions listed below. Should you need to attach additional files per this request, use the paperclip icons at the end of this form. You may attach up to (5) files per icon up to 25MB:

Staff does not have authority to approve the installation of the sliding doors. This application will likely need to be reviewed by the Commission at the next available meeting. However, the following information must be submitted before this project can be docketed:

1. Include the dimensioned drawings for the proposed trash enclosure, as this will also need to be reviewed by the Commission.

To be included in the March Meeting, please submit the requested information by end of day, today (February 17, 2026)

APPLICANT RESPONSE

Response Date: 02/17/2026



1. Sheet/Drawing ST-4 outlines the trash enclosure details requested above.
2. Sheet/Drawing A-2 was left out of the application (previously) and further outlines the residential units on the interior of the church building, adjacent to the west facing exterior wall where the glass sliding doors are proposed to be constructed.



MARUSICH
ARCHITECTURE

36880 WOODWARD AVENUE
BLOOMFIELD HILLS, MI 48304
SUITE 100

OFFICE: (248) 792-2949
CELL: (313) 482-0645

www.marusicharchitecture.com
johnm.marusicharchitecture@gmail.com

COPY RIGHT

THE IDEAS AND DESIGN CONCEPT EXPRESSED HERE IN AND THE GRAPHICALLY DISPLAYED ARRANGEMENT OF THIS DRAWING HAVE BEEN DEVELOPED FOR THE EXCLUSIVE USE OF THIS SPECIFIED PROJECT AND LOCATION. THE DRAWINGS ARE THE SOLE INTELLECTUAL PROPERTY OF THE ARCHITECT. ANY CONFORMANCE OR DISCLOSURE OF THE IDEAS OR DESIGN CONCEPTS OR THE USE OF THESE GRAPHICALLY DISPLAYED ARRANGEMENTS OR THEIR COMPONENTS SHALL BE AT THE DISCRETION OF AND ONLY THROUGH THE EXPRESSED WRITTEN CONSENT OF MARUSICH ARCHITECTURE, LLC.

IN THE ABSENCE OF A WRITTEN AIA CONTRACT ACCEPTANCE AND/OR USE OF THESE DOCUMENTS BY THE OWNER/CLIENT OR HIS AGENTS SHALL CONSTITUTE TO BE BINDING CONTRACT BETWEEN THE OWNER/CLIENT AND THE ARCHITECT IN ACCORDANCE TO ALL CONDITIONS CONTAINED WITHIN AIA B151 AND B141 CONTRACTS. ALL IDEAS, DESIGNS, ARRANGEMENTS, AND PLANS INDICATED BY OR REPRESENTED BY THE DRAWINGS AND WRITTEN MATERIAL APPEARING HEREIN CONSTITUTES THE ORIGINAL AND UNPUBLISHED WORK OF MARUSICH ARCHITECTURE, LLC AND THE SAME MAY NOT BE DUPLICATED, USED, TRANSFERRED, OR DISCLOSED TO ANY PERSON, FIRM, CORPORATION, OR AGENCY WITHOUT A WRITTEN CONTRACT OR WRITTEN CONSENT OF THE ARCHITECT AND MARUSICH ARCHITECTURE. ALL DIMENSIONS ARE WRITTEN AND SHALL NOT BE SCALED OFF THE DRAWING.

© COPYRIGHT MARUSICH ARCHITECTURE, LLC 2025

OWNER

VOLTE
14635 JEFFERSON
INVESTOR LLC

PROJECT NAME

ST. COLUMBA
COMMUNITY
DEVELOPMENT
CHURCH LOFTS
1069 MANISTIQUE STREET
DETROIT, MI 48215

PROJECT # 25 - 27

ISSUE DATE # 05/21/2025

REVISION HISTORY

SLU SET	05/21/2025
SLU REVISION	07/07/2025
SLU REVISION - 2	02/09/2026

DRAWN BY: RO

CHECKED BY: JM


SHEET CONTENTS

DUMPSTER ENCLOSURE
CONSTRUCTION DETAILS


SEAL

SHEET #


ST-4

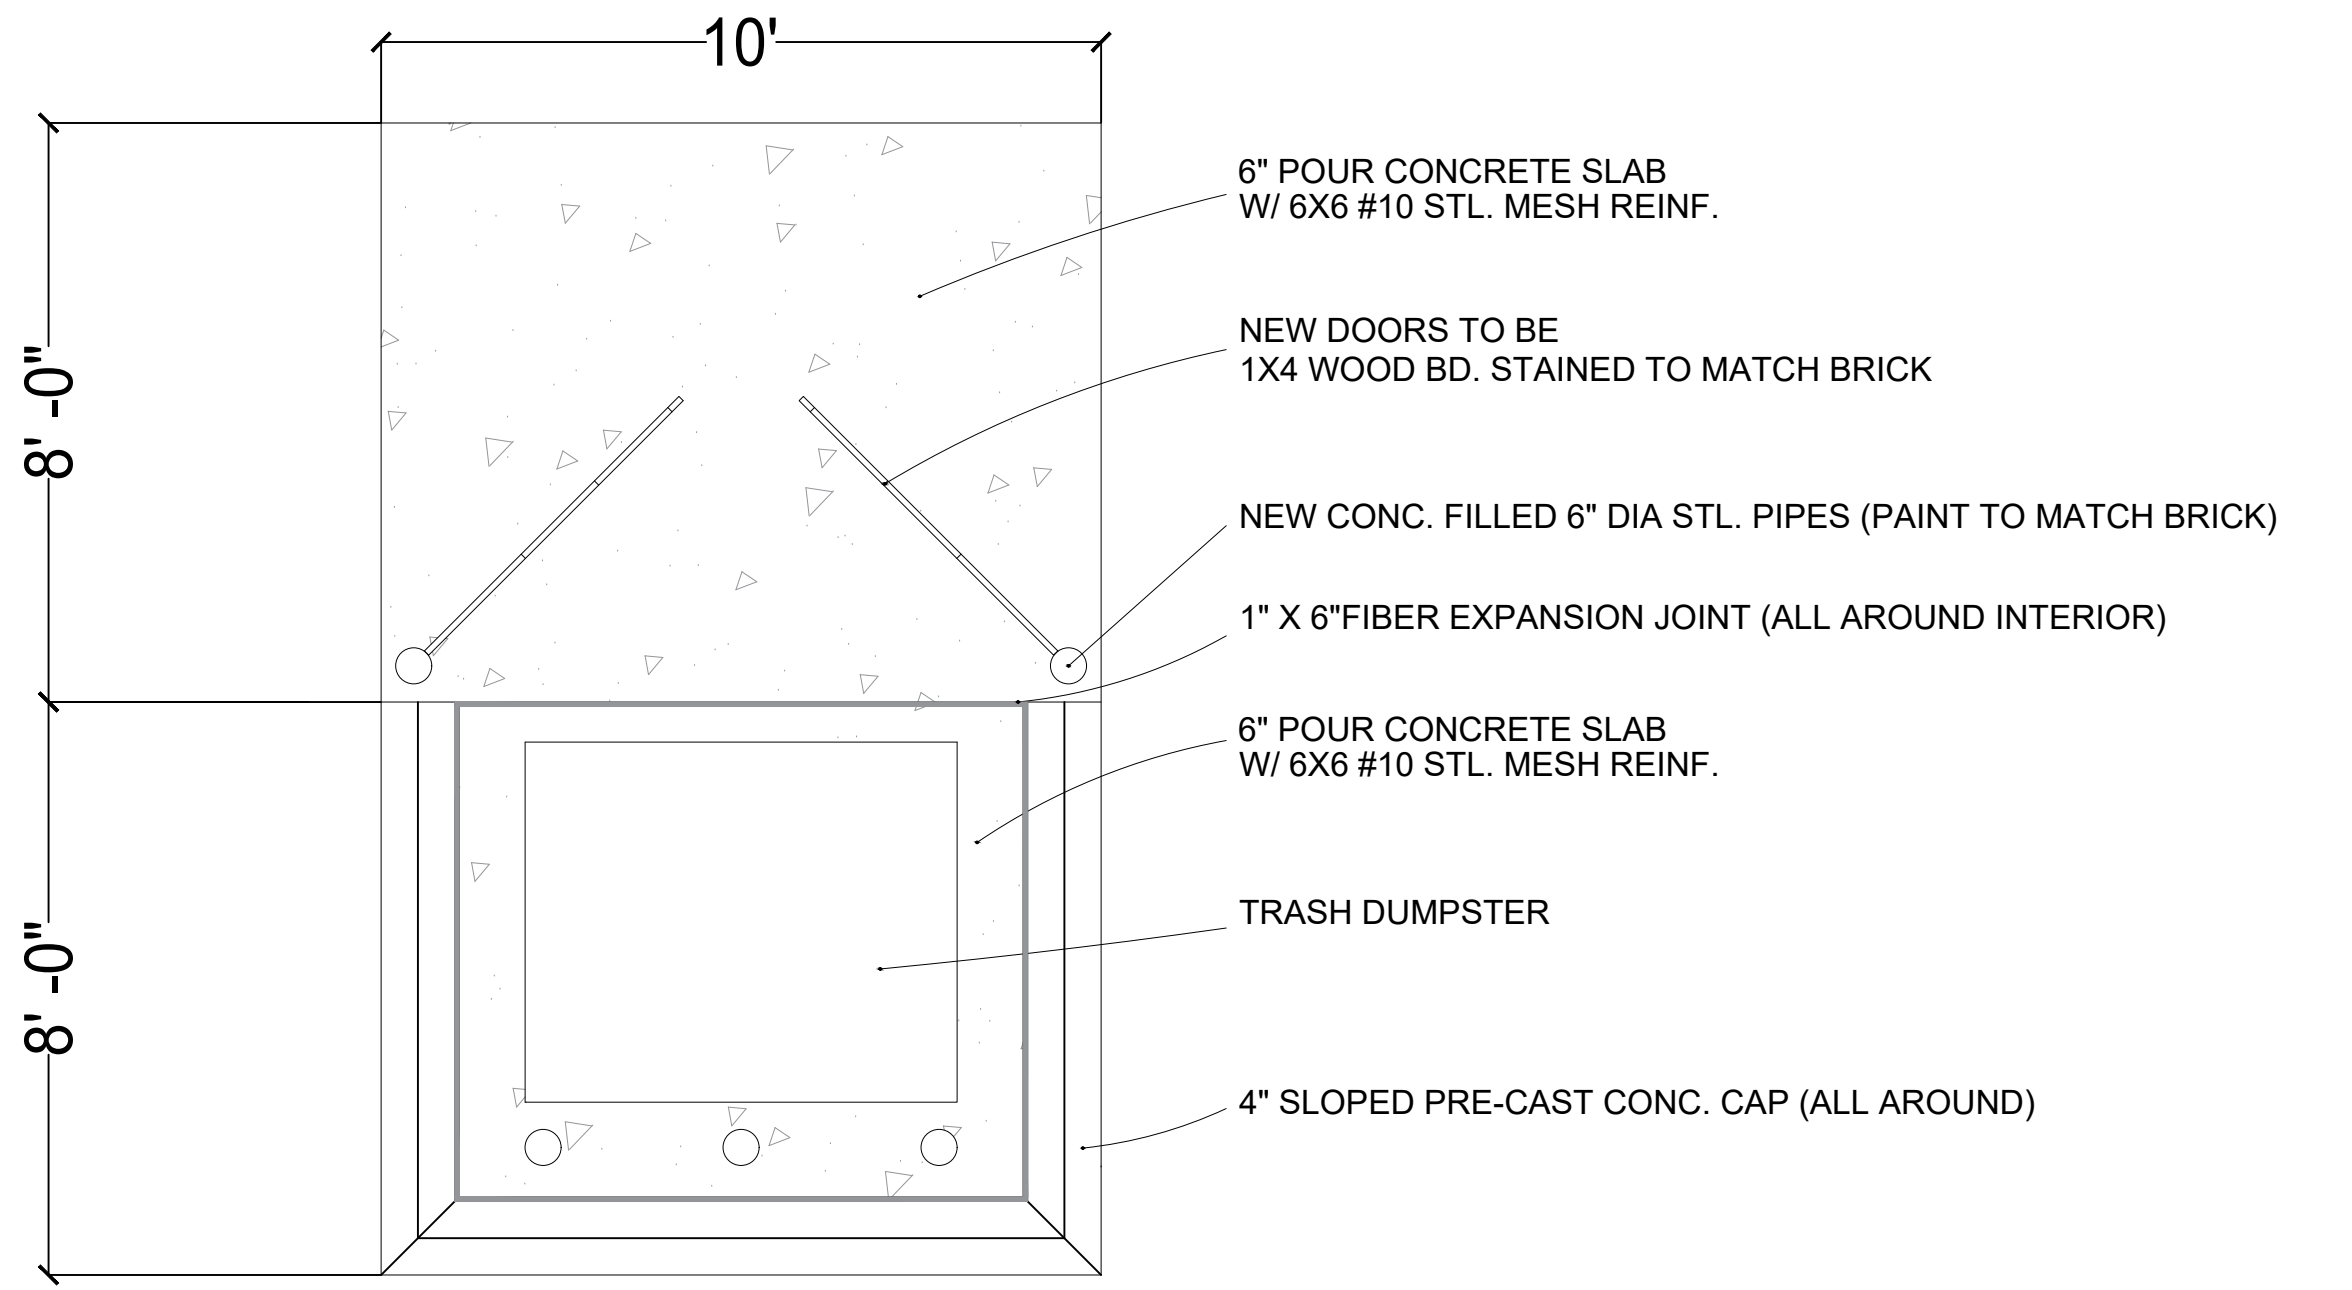


1 DUMPSTER ENCLOSURE PLAN
ST-4 SCALE: 1/8" = 1'-0"

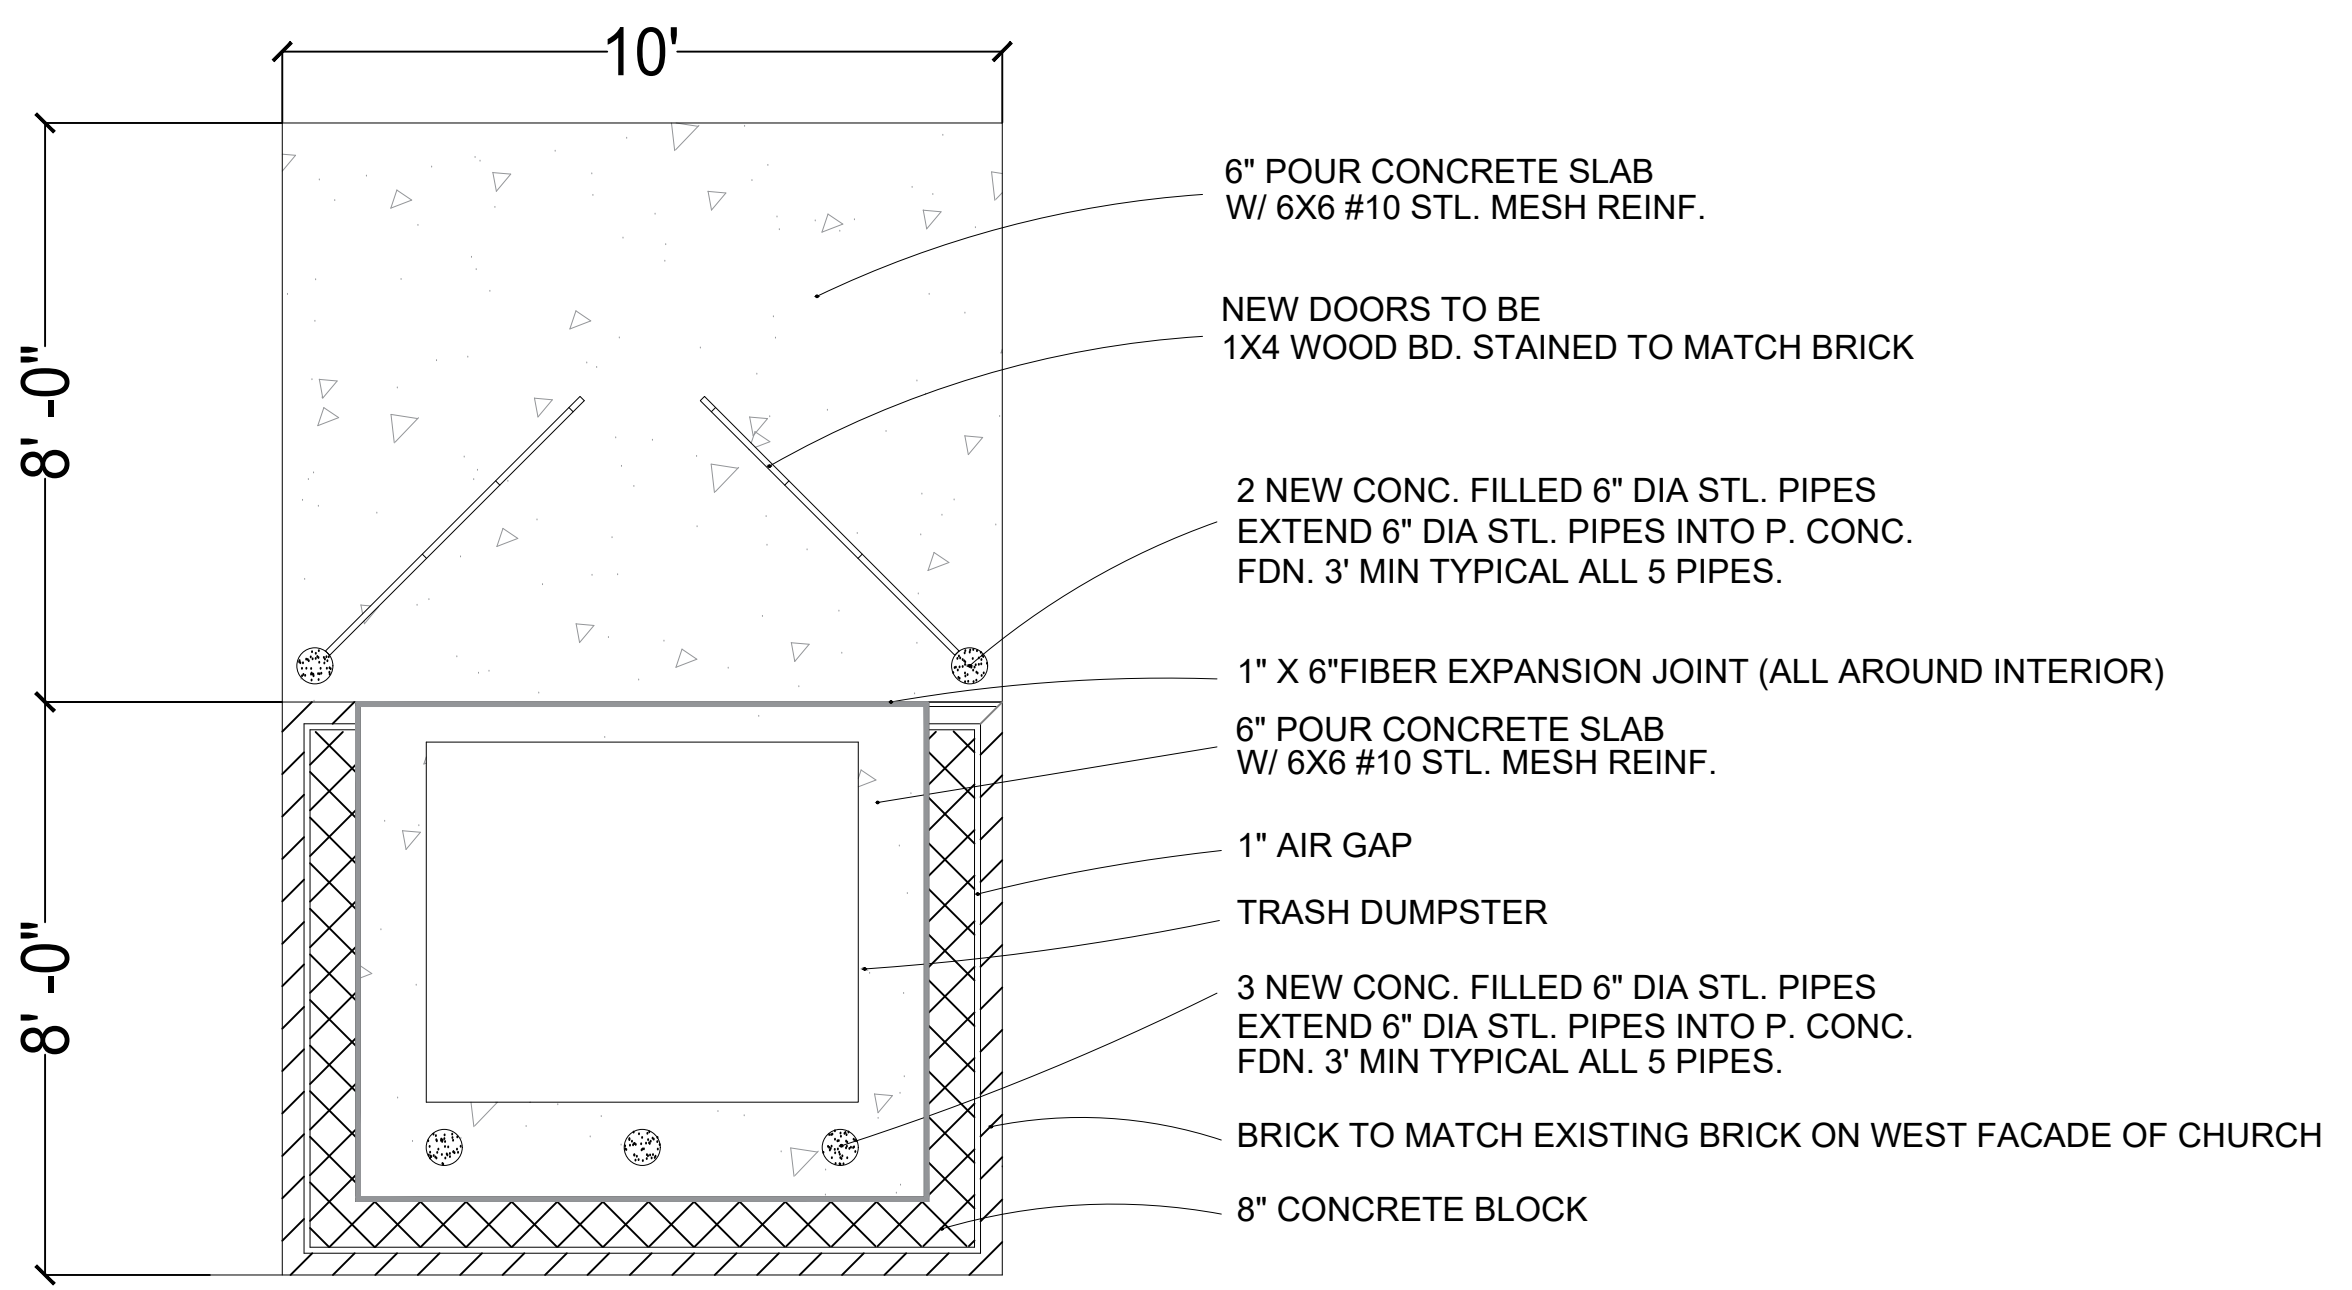


2 DUMPSTER ENCLOSURE
CONSTRUCTION PLAN
ST-4 SCALE: 1/8" = 1'-0"

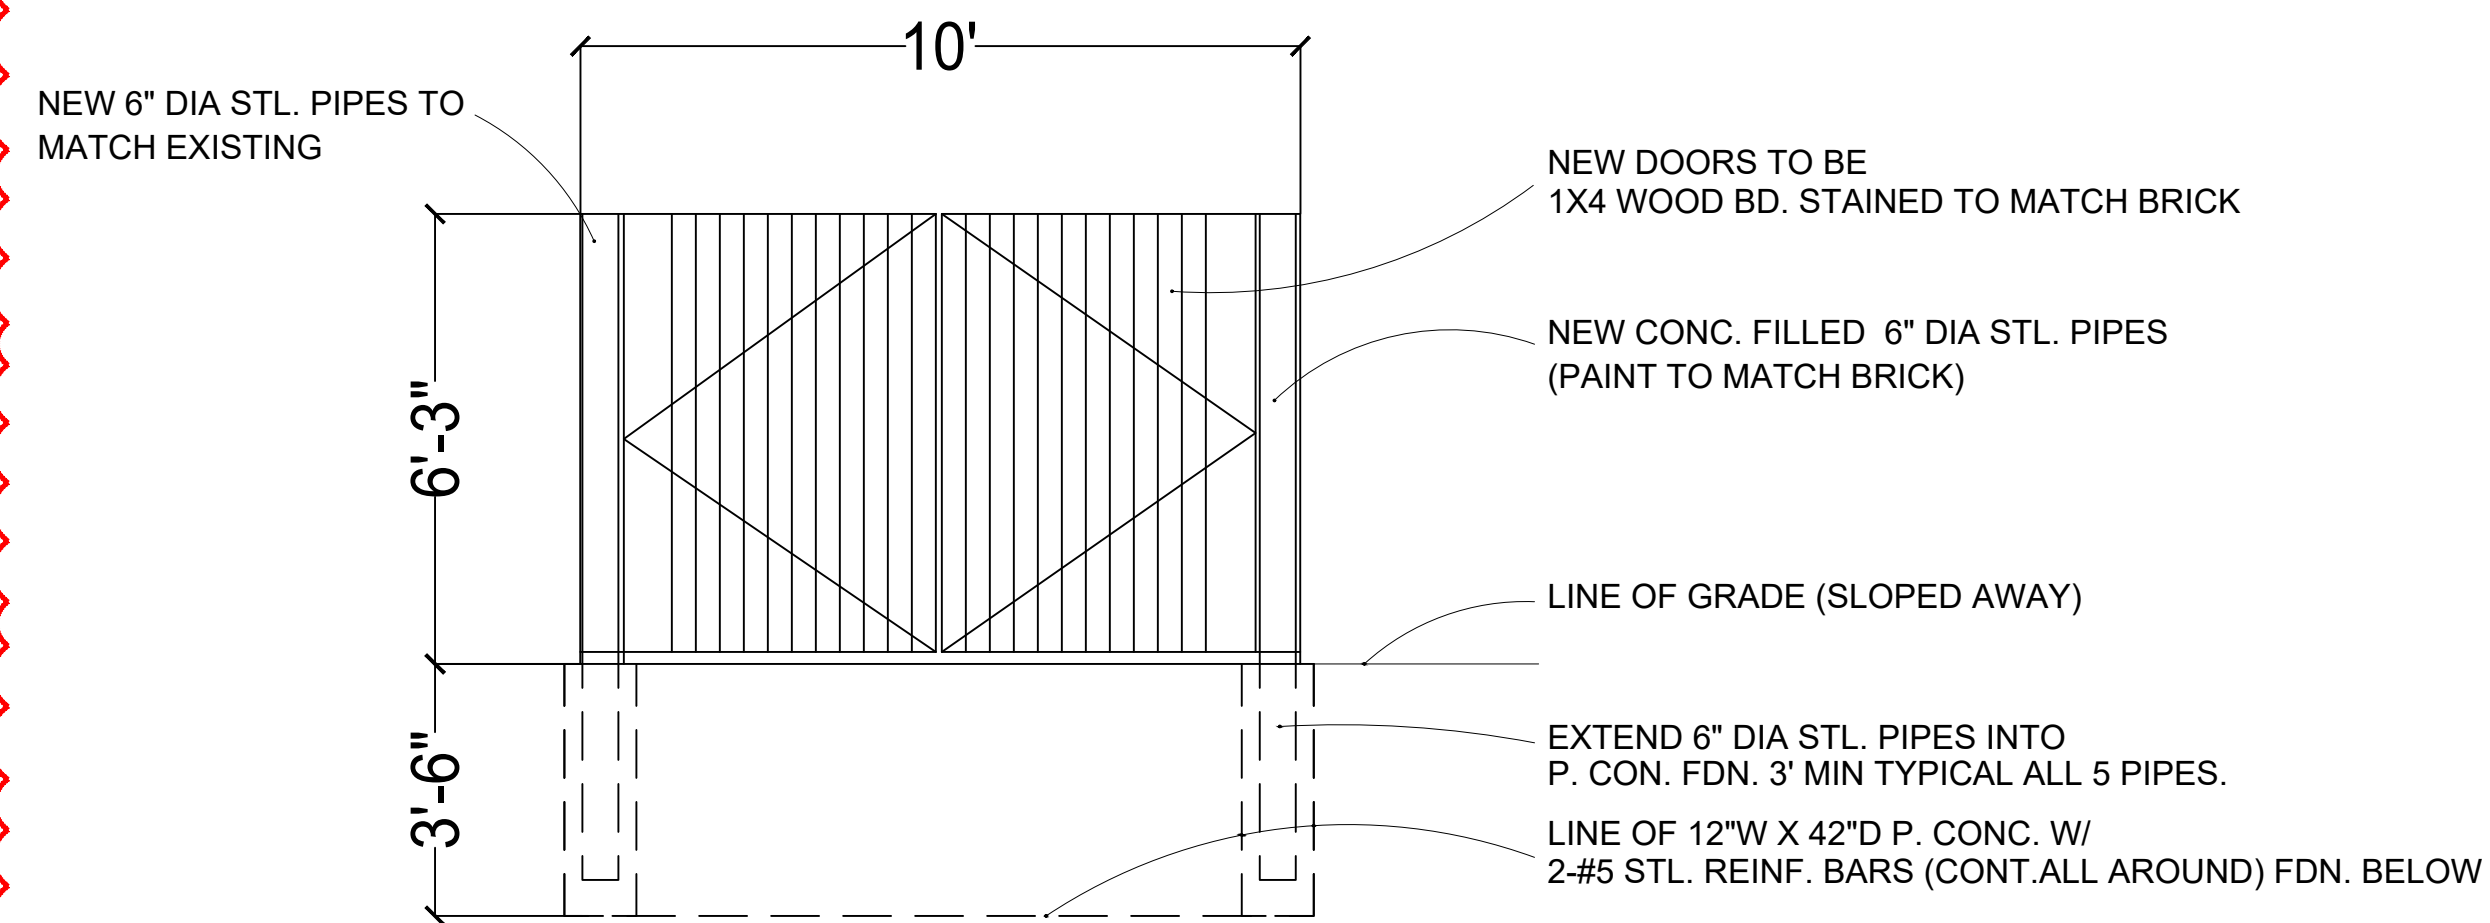


3 FRONT ELEVATION
ST-4 SCALE: 1/8" = 1'-0"

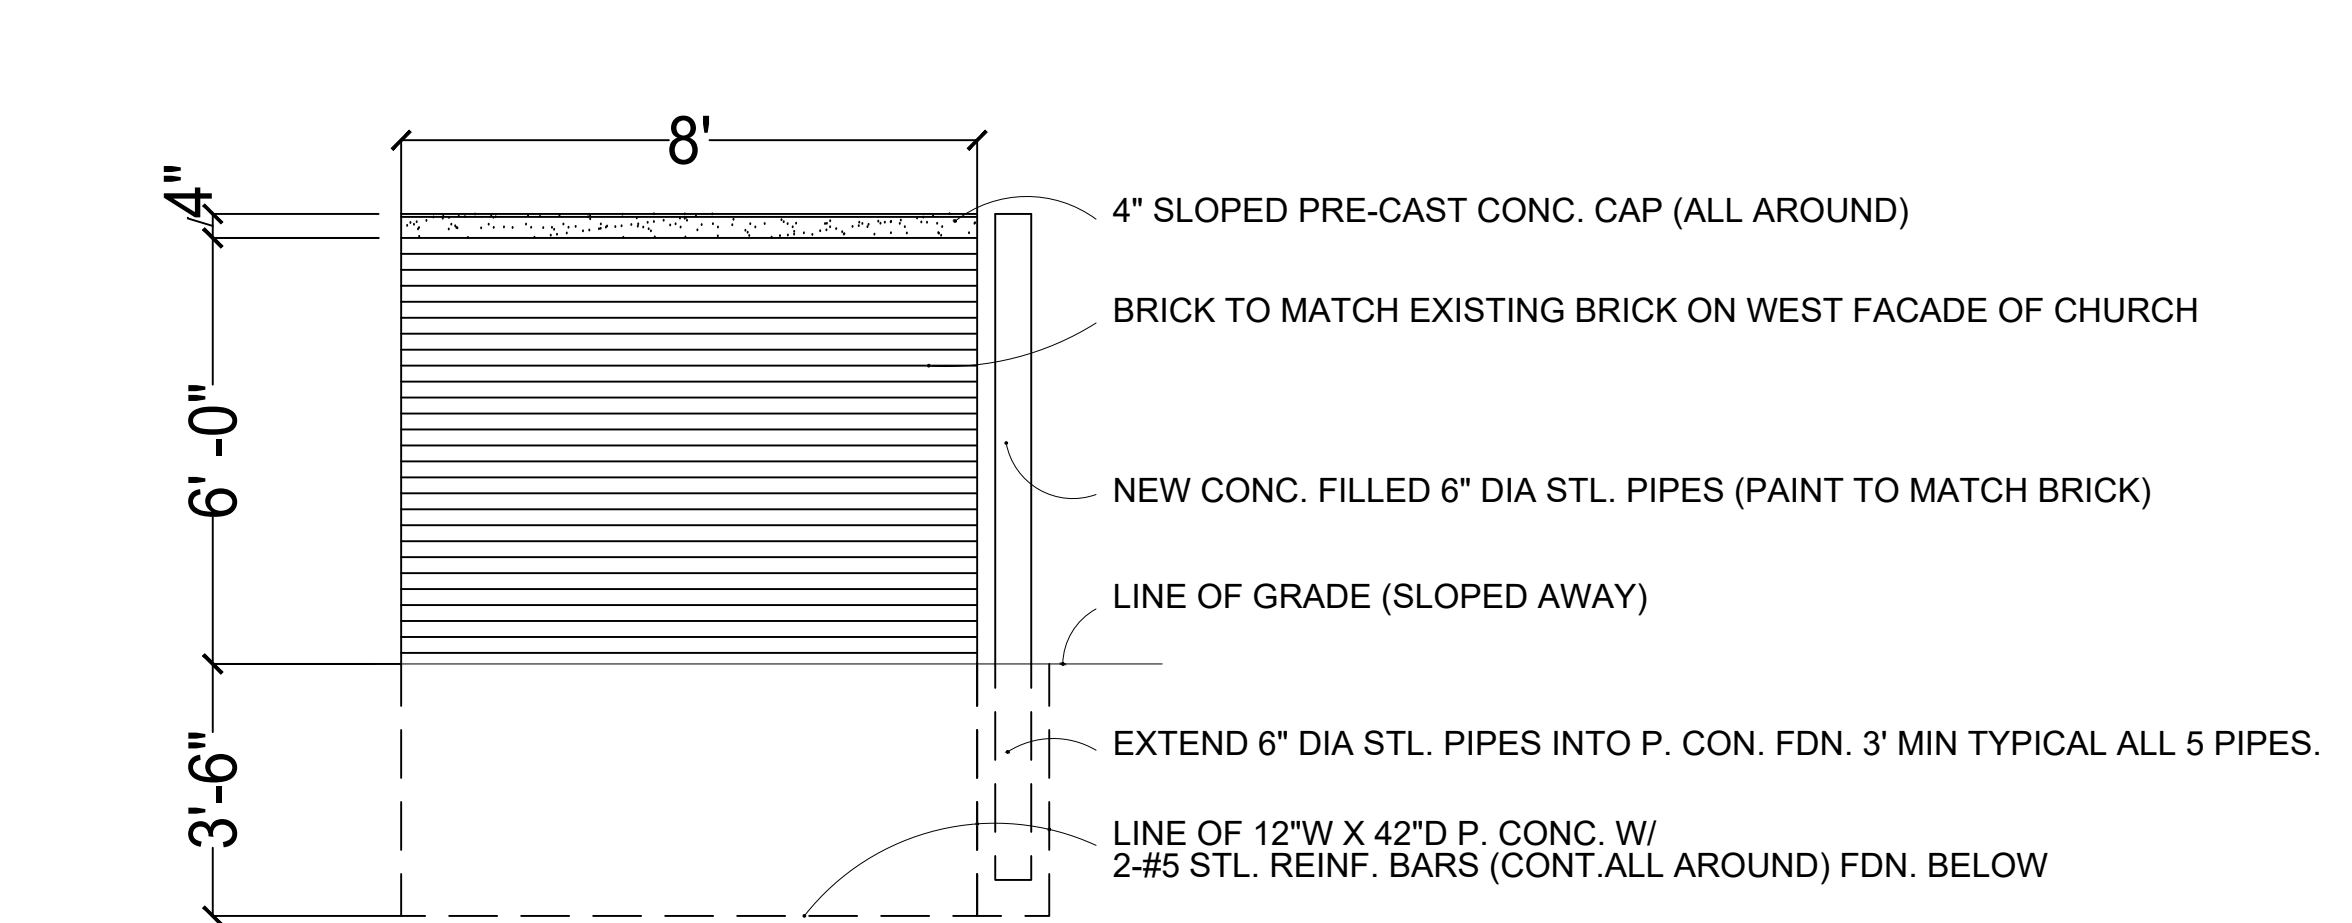

4 SIDE ELEVATION
ST-4 SCALE: 1/8" = 1'-0"

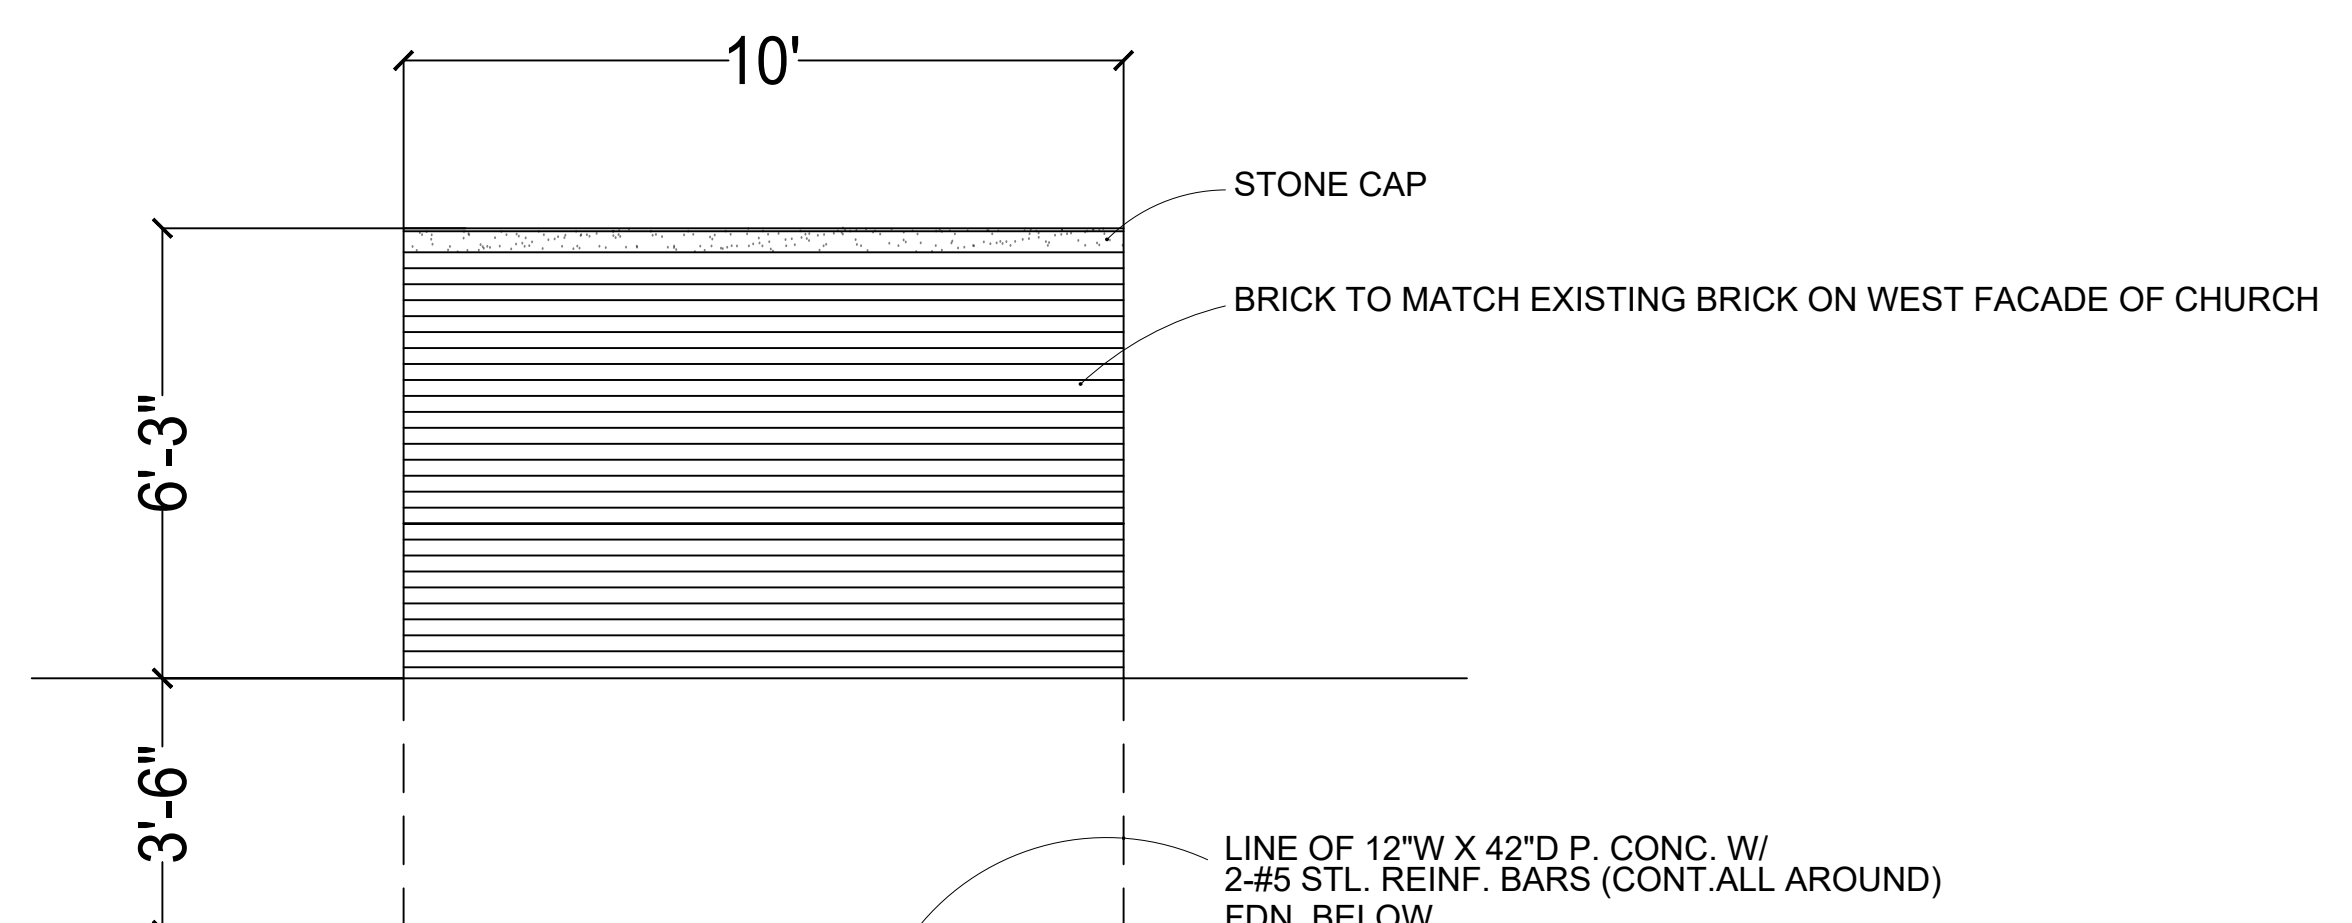

5 REAR ELEVATION
ST-4 SCALE: 1/8" = 1'-0"

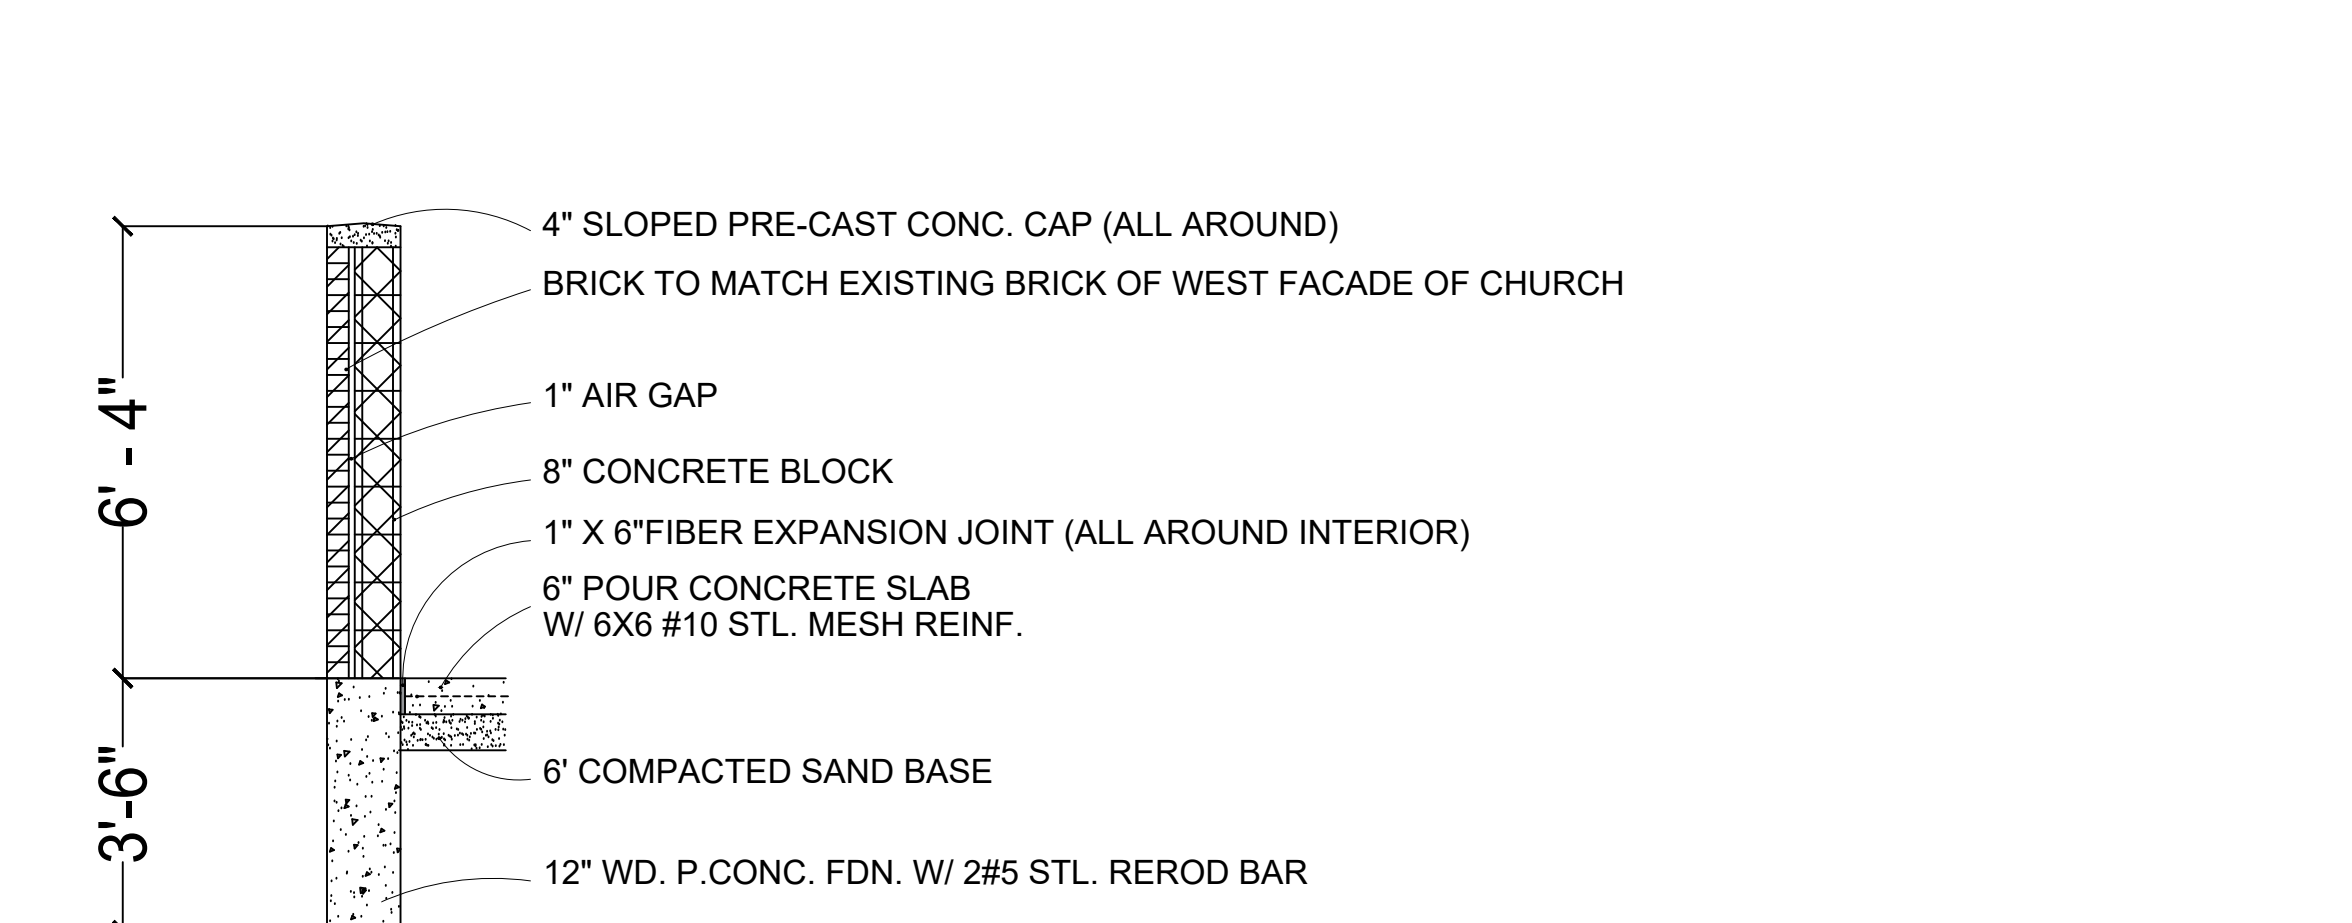

6 DUMPSTER ENCLOSURE
WALL SECT.
ST-4 SCALE: 1/8" = 1'-0"

OWNER / OWNER'S AGENT APPROVED & ACCEPTED

DATE: / / 2025



MARUSICH
ARCHITECTURE

36880 WOODWARD AVENUE
BLOOMFIELD HILLS, MI 48304
SUITE 100

OFFICE: (248) 792-2949
CELL: (313) 482-0645

www.marusicharchitecture.com
john.marusicharchitecture@gmail.com

COPY RIGHT

THE IDEAS AND DESIGN CONCEPT EXPRESSED HEREIN AND THE GRAPHICALLY DISPLAYED ARRANGEMENT OF THIS DRAWING HAVE BEEN DEVELOPED FOR THE EXCLUSIVE USE OF THIS SPECIFIC PROJECT AND LOCATION. THE DRAWINGS ARE THE SOLE INTELLECTUAL PROPERTY OF THE ARCHITECT. ANY CONCEPTS OR DESIGN CONCEPTS OR THE USE OF THESE GRAPHICALLY DISPLAYED ARRANGEMENTS OR THEIR COMPONENTS SHALL BE AT THE DISCRETION OF THE ARCHITECT AND MAY ONLY BE REPRODUCED OR USED IN ANY MANNER THROUGH THE EXPRESSED WRITTEN CONSENT OF MARUSICH ARCHITECTURE LLC.

IN THE ABSENCE OF A WRITTEN AIA CONTRACT ACCEPTANCE AND/OR USE OF THESE DOCUMENTS BY THE OWNER/CLIENT OR HIS AGENTS SHALL CONSTITUTE TO BE BINDING CONTRACT BETWEEN THE OWNER/CLIENT AND THE ARCHITECT IN ACCORDANCE TO ALL CONDITIONS CONTAINED WITHIN AIA B151 AND B141 CONTRACTS. ALL IDEAS, DESIGNS, ARRANGEMENTS, AND PLANS INDICATED BY OR REPRESENTED BY THE ARCHITECT AND WRITTEN MATERIAL APPEARING HEREIN CONSTITUTE THE ORIGINAL, AND UNPUBLISHED WORK OF MARUSICH ARCHITECTURE LLC AND THE SAME MAY NOT BE REPRODUCED, USED, TRANSFERRED, OR DISCLOSED TO ANY PERSON, FIRM, CORPORATION, OR AGENCY WITHOUT A WRITTEN CONTRACT OR WRITTEN CONSENT OF THE ARCHITECT AND MARUSICH ARCHITECTURE LLC.

ALL DIMENSIONS ARE WRITTEN AND SHALL NOT BE SCALED OFF THE DRAWING.
© COPYRIGHT MARUSICH ARCHITECTURE LLC 2025

OWNER

VOLTE 14635 JEFFERSON
INVESTORS LLC

PROJECT NAME

ST. COLUMBA COMMUNITY
DEVELOPMENT
CHURCH LOFTS

1069 MANISTIQUE STREET
DETROIT, MI 48215

PROJECT #

25 - 27

ISSUE DATE #

03/14/2025

REVISION HISTORY

EXIST. CONDITIONS (S)	03/14/2025
STUDY 10 (MF)	04/02/2025
STUDY 11 (JH)	04/08/2025
STUDY 12 (JH)	04/11/2025
STUDY 13 (JH)	04/21/2025
OWNER REVIEW	05/09/2025
OWNER REVIEW	05/16/2025
SLU SET	05/20/2025
OWNER REVIEW	05/27/2025
OWNER REVIEW	06/10/2025
OWNER REVIEW	06/13/2025
OWNER REVIEW	06/20/2025

DRAWN BY:

SJ + MF + JH

CHECKED BY:

JM

SHEET CONTENTS

SEAL

DATE: 00/00/2025

SHEET #

A-2

OWNER / OWNER'S AGENT APPROVED & ACCEPTED

DATE: 00/00/2025

WEST (ALLEY) FACING EXTERIOR WALL (WHERE GLASS SLIDING DOORS ARE PROPOSED)

UNIT A TWO BED 1103 S.F.

UNIT B ONE BED 461 S.F.

UNIT C ONE BED 461 S.F.

UNIT D ONE BED 473 S.F.

UNIT Y ONE BED 531 S.F.

UNIT Z 476 S.F.

SOCIAL MEETING ROOM 540 S.F.

STAGE 353 S.F.

TOTAL S.F. 893 S.F.

EXIST. STAINED GLASS WINDOWS TO REMAIN

PATCH, REPAIR, RESTORE EXIST. W.D. BACKING AS NECESSARY

PATCH, REPAIR, RESTORE EXIST. PAD FOR ALTAR TO REMAIN AS NEC.

EXIST. STAINED GLASS WINDOWS TO REMAIN

PATCH, REPAIR, RESTORE EXIST. RAISED SANCTUARY LEVEL AS NEC.

NEW EXTERIOR LIGHT (SEE SHEETS D-2, A-9)

INFILL EXIST. P. CONC. LANDING AS NEC. TO MATCH THE GRADE OF EXIST. FIRST FLOOR. CONSTRUCT 3 NEW CONC. STEPS TO MATCH GRADE OF NEW P. CONC. LANDING HEIGHT (SEE SHEET A-9)

DEMO EXIST. CEILING. INSTALL NEW SUSPENDED DRYWALL CEILING SYSTEM AT SAME HEIGHT OF FORMER PLASTER CEILING. PATCH & REPAIR SIDE WALLS AS NEC.

EXISTING WALLS TO REMAIN. PATCH, REPAIR, RESTORE EXIST. WALL, STAINED GLASS, AND PANELS AS NECESSARY. INSTALL NEW LED BACKLIGHT BEHIND EXIST. STAINED GLASS AND PANELS. PATCH, REPAIR, RESTORE EXIST. DOORS ON WALLS AS NECESSARY. PERMANENTLY LOCK IN PLACE

EXISTING DOORS TO REMAIN. SCRAPE EXISTING PAINT. SAND, PRIME, AND REPAINT

INSTALL NEW HISTORIC ERA EXTERIOR LIGHTS IN PLACE OF EXIST. MISSING LIGHTS (SEE SHEETS D-2, A-8)

EXIST. HANDRAILS TO REMAIN

NEW EXTERIOR LIGHT (SEE SHEETS D-2, A-8)

INSTALL NEW P. CONC. LANDINGS AND ADA RAMP WITH A MAX SLOPE 1:12 TO THE MATCH THE GRADE OF FIRST FLOOR. INSTALL ADA HANDRAILS. (SEE SHEETS A-10, A-11)

EXIST. HISTORIC WINDOWS. REMOVE SCREEN. PATCH, REPAIR AND RECAULK EXIST. WINDOWS AND FRAME AS NEC. PAINT SCREENS AND REPLACE (TYP.)

INSTALL 'NATIONWIDE LIFTS' OR ARCHITECT APPROVED EQUAL INCLINED WHEELCHAIR LIFT MEETING ADA REQUIREMENTS (THE PLATFORM AUTOMATICALLY FOLDS OUT OF THE WAY WHEN NOT IN USE). OTHER LOCATIONS TBD.

NEW EXTERIOR LIGHT (SEE SHEETS D-2, A-8)

EXIST. WINDOWS TO REMAIN

INSTALL NEW 3-PANEL 9'-2"x8'-0" SLIDING PATIO DOORS AND PATIO GATE

NEW 3-PANEL 9'-2"x8'-0" SLIDING PATIO DOORS AND PATIO GATE

NEW 3-PANEL 9'-2"x8'-0" SLIDING PATIO DOORS AND PATIO GATE

NEW 3-PANEL 9'-2"x8'-0" SLIDING PATIO DOORS AND PATIO