


**SUNFLOWER (Pre-K, built 2020, expanded 2021)**



**General View**

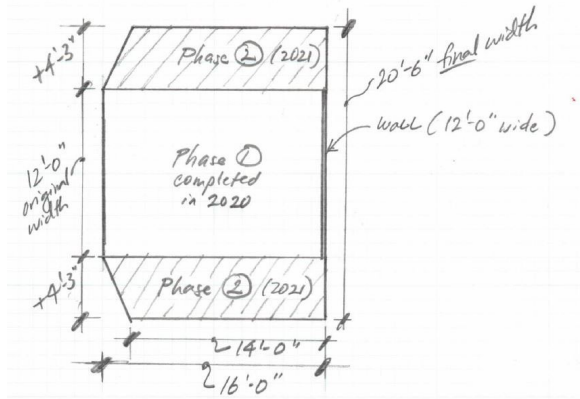

**Deck Dimensions (as built)**



**Front View**




**Side View**

**HONEYBEE (Pre-K, built 2020, expanded 2021)**



**General View**

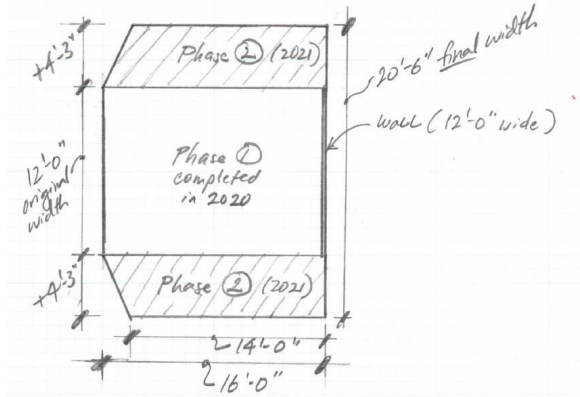

**Deck Dimensions (as built)**



**Front View**




**Side View**



**MOON (Pre-K, built 2020, expanded 2021)**



**General View**

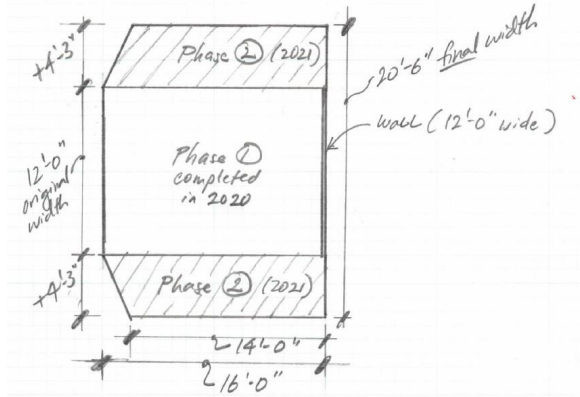

**Deck Dimensions (as built)**



**Front View**




**Side View**

**BLUEBIRD (Pre-K, built 2020, expansion started 2021)**



**General View**

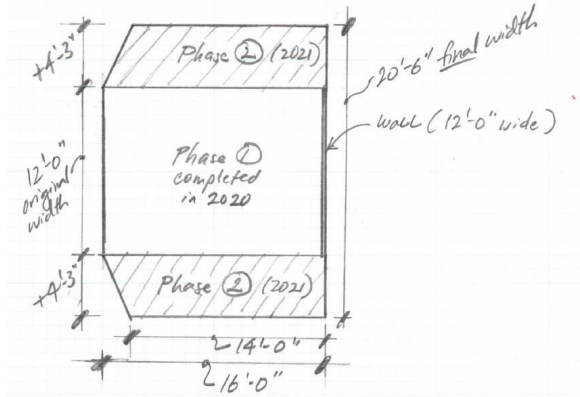

**Deck Dimensions (when complete)**



**Front View**



**Side View**






**SUNRISE KINDERGARTEN (built 2020)**



**General View**

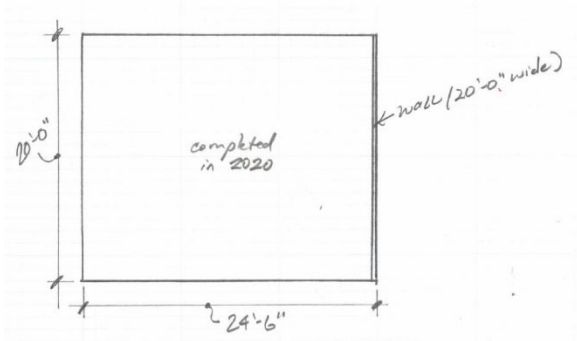

**Deck Dimensions (as built)**



**Front View**




**Side View**



1<sup>st</sup> GRADE (built 2020, expanded 2021)



General View

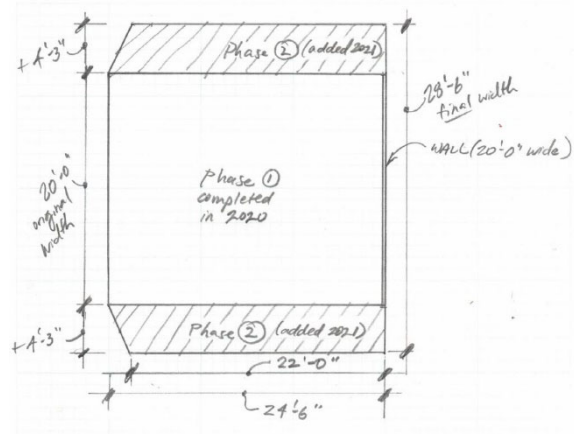

Deck Dimensions (as built)



Front View




Side View

2<sup>ND</sup> GRADE (built 2020)



General View

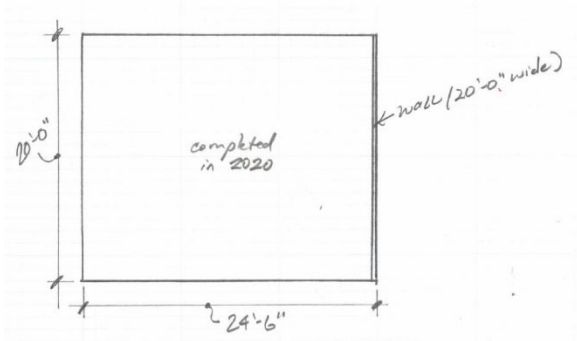

Deck Dimensions (as built)



Front View




Side View



**3<sup>RD</sup> GRADE (built 2020)**



**General View**

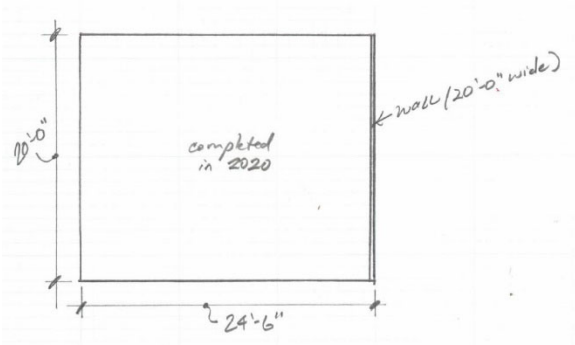

**Deck Dimensions (as built)**



**Front View**




**Side View**

4<sup>TH</sup> GRADE (built 2020)



General View

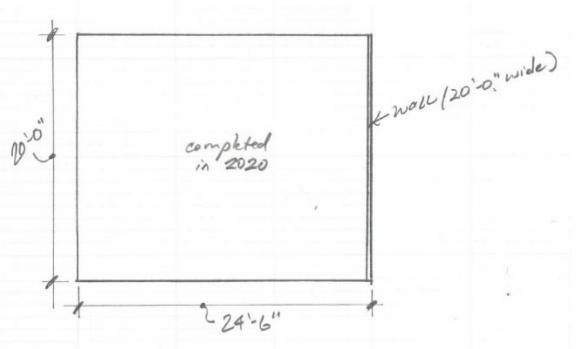

Deck Dimensions (as built)



Front View




Side View



5<sup>TH</sup> GRADE (built 2020)



General View

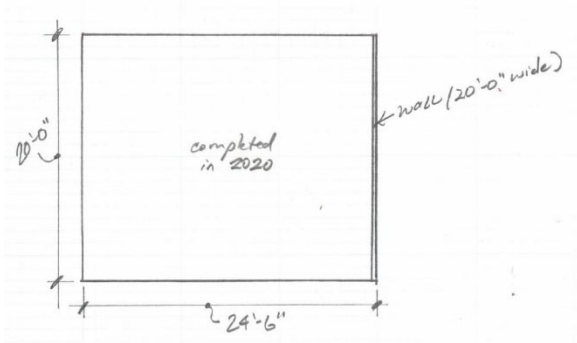

Deck Dimensions (as built)



Front View




Side View

6<sup>TH</sup> GRADE (built 2020)



General View

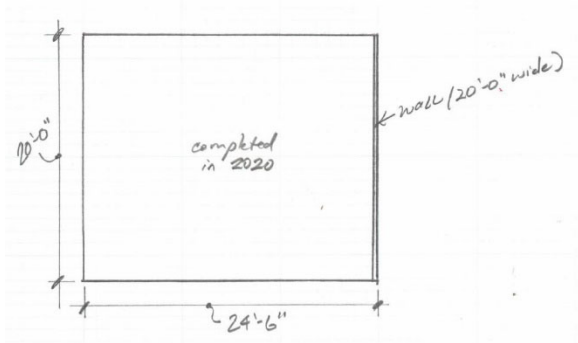

Deck Dimensions (as built)



Front View



Side View